

LLoyds NUMBERS FOR CLASS 100A1

HALF BREADTH 20,0"
 DEPTH 15,02"
 HALF GIRTH 32,92"
 FIRST NUMBER 87,94
 SECOND NUMBER 67,94 x 216,334 = 14,690
 L:B = 5,408 L:D = 14,403

28.8.08

2699. Steel seagoing Oil-lighter.

Longitudinal- & Deckplans.


216'-4" x 40'-0" x 14'-2 1/4". Scale 1/8" = 1'-0"

EQUIPMENT


2 STOCKLESS BOWERS 38 1/2 CWT EACH
 1 " " " " 32 1/2 " " " "
 1 STREAM ANCHOR WITH STOCK 11 CWT INCL. STOCK
 1 HEDGE " " " " 5-2-14 " " " "
 270 FATHOM 1 1/16" STUD CHAIN CABLE 388 CWT
 175 " 3/4" CIRC STEEL WIRE FOR STREAM ANCHOR
 90 " 3/4" " " " " TOW LINE
 2 x 90 " 3/4" " " " " ACC. SPECIFICATION

Fore castle-deck.


RIVETING
 STRINGER AND TIE PLATE
 DOUBLE RIV. BUTTLAPS

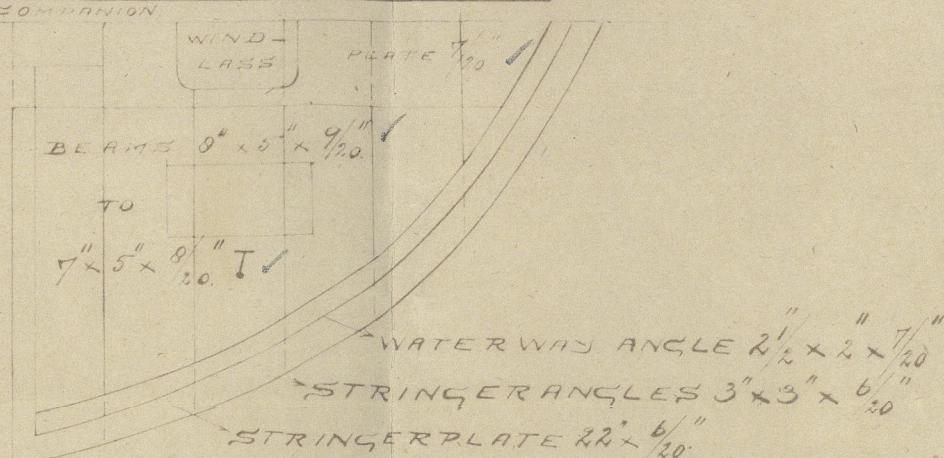

Longitudinal section.

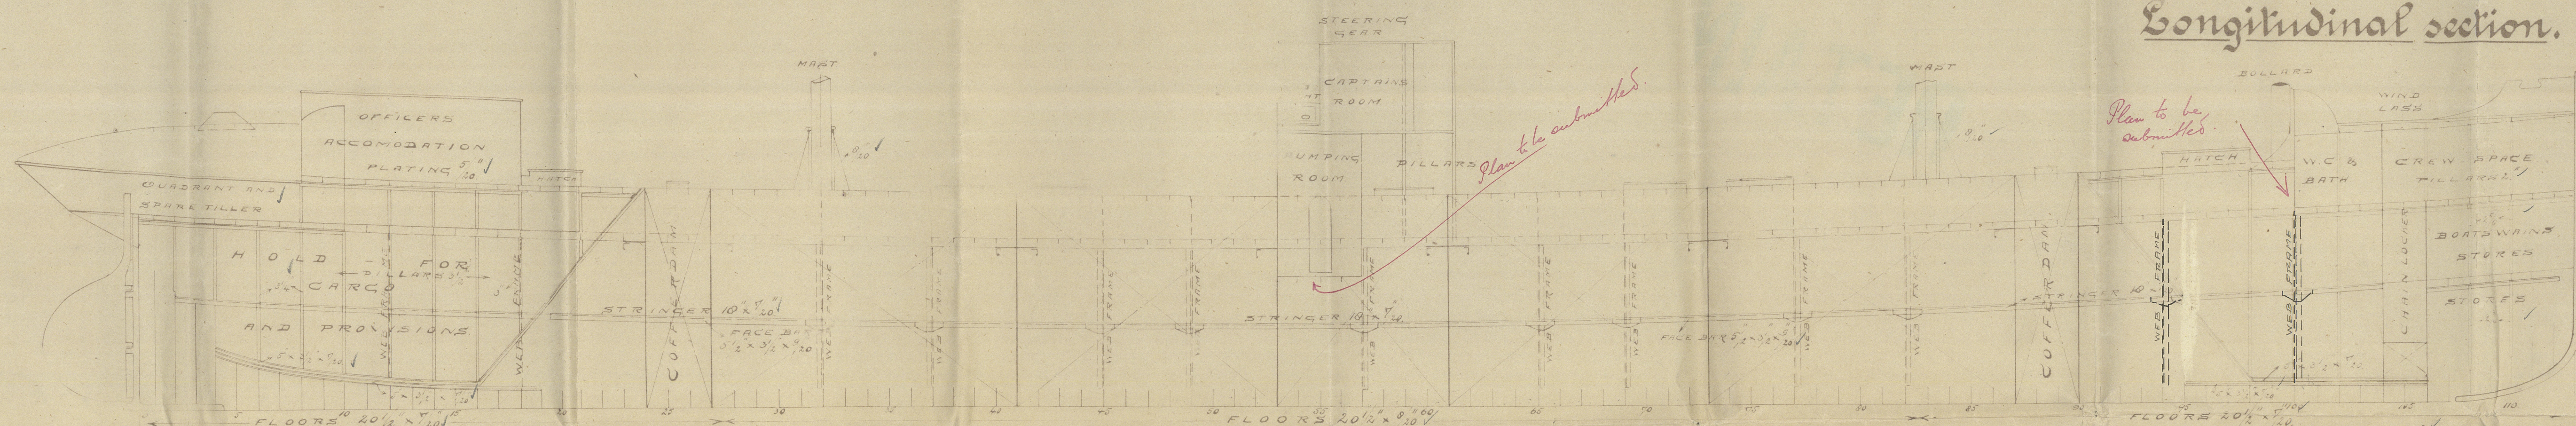


Trunk deck.

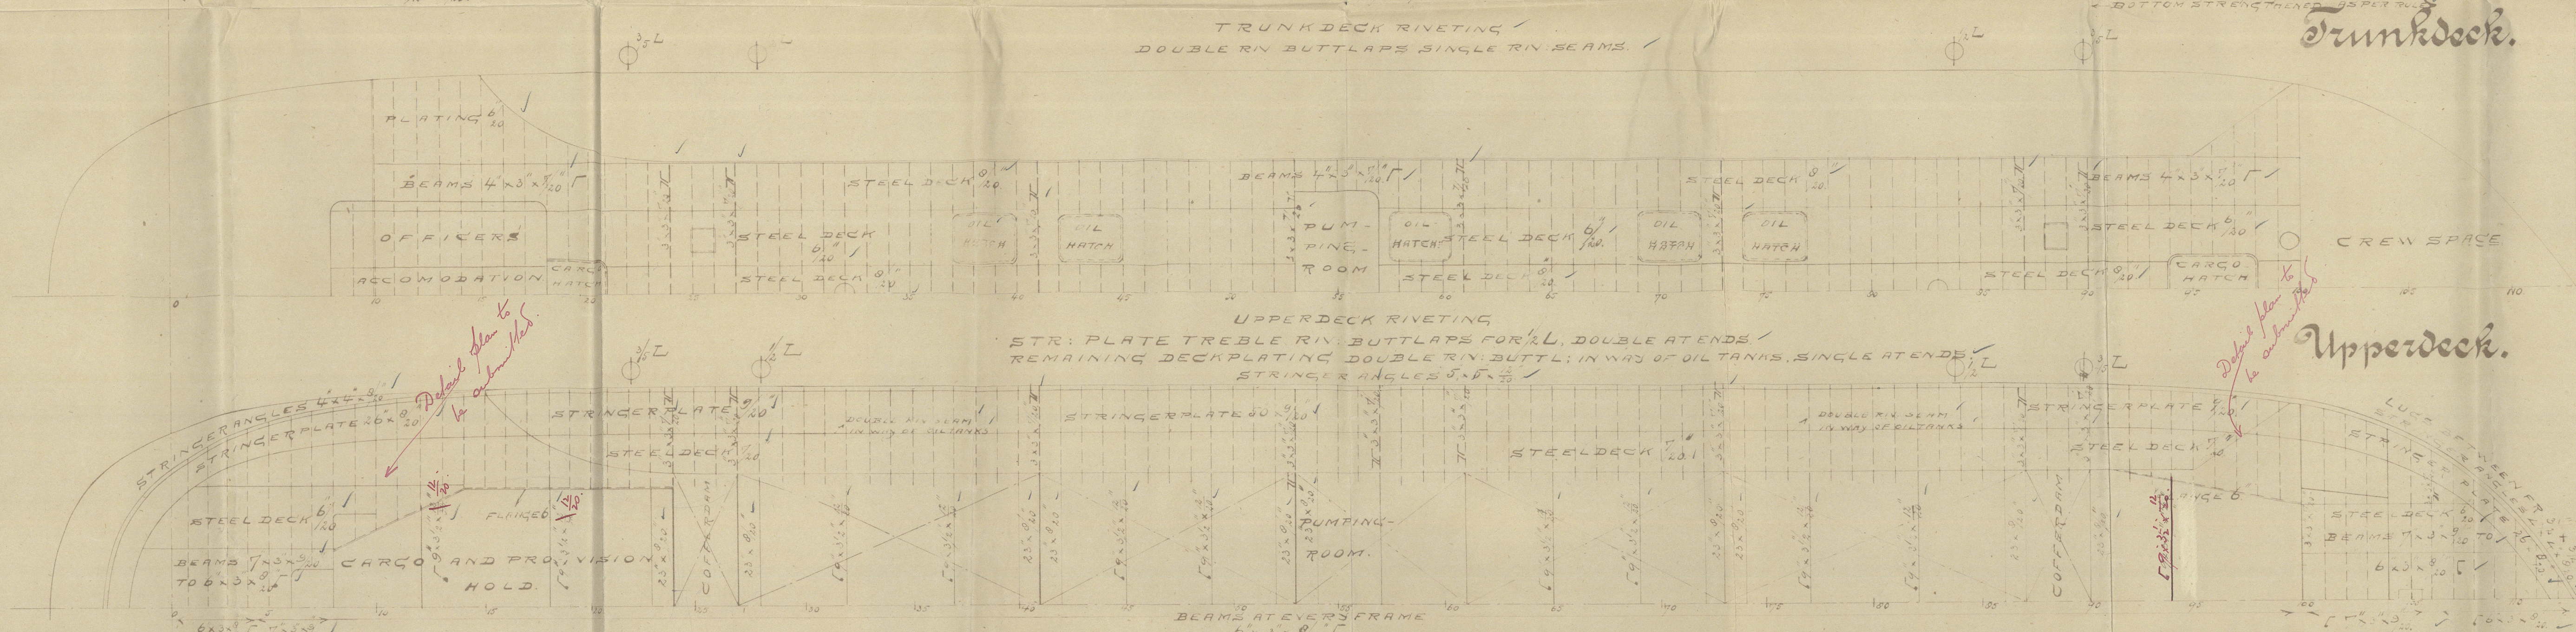

Upper deck.

Holdplan.

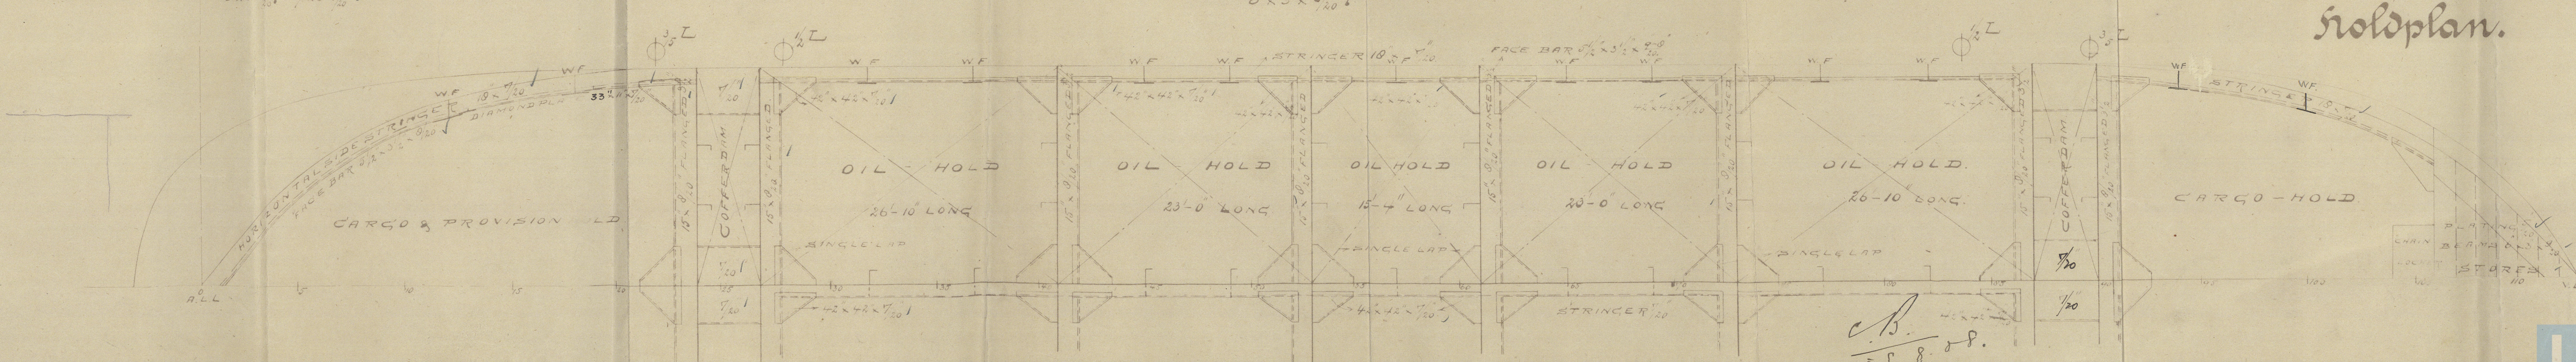

C.B.
 28.8.08

W1115-0129

Sank Raze Limburg

N^o 99.

Longitudinal and
deck plan

Ans 4248

REMAIN

REMAIN



© 2020

Lloyd's Register
Foundation