

MIDSHIP SECTION

SS N° 217

250'0" x 37'9 1/2" x 18'3"

SCALE 1/2" = 1 FOOT

ISHERWOOD SYSTEM (PATENT)

DECK - 26" SHEATHED WITH TEAK

STRINGER - 52" x 46" TO

24" x 36"

LONGS: 6" x 3" x 4" TO 36" O.A.

3" x 3" x 36"

SHELTER D.

4" x 4" x 48" TO 3 1/2" x 3 1/2" x 36"

5 1/2" x 3" x 34" B.A. N° 9.

5 1/2" x 3" x 34" B.A. N° 8.

3 1/2" x 3 1/2" x 38" TO 36"

5 1/2" x 3" x 36" TO 34" B.A. N° 7.

5 1/2" x 3" x 38" TO 34" B.A. N° 6.

SHELL - 46" TO 38"

6" x 3 1/2" x 4" TO 36" B.A. N° 5.

6 1/2" x 3 1/2" x 42" TO 38" B.A. N° 4.

7" x 3 1/2" x 44" TO 4" B.A. N° 3.

8" x 3 1/2" x 42" TO 38" B.A. N° 2.

6 1/2" x 3 1/2" x 34" B.A. N° 1.

9" x 4" BULB PLATE

5" x 4" x 45" TEE

TRANS. BEAM - 11" x 34"

FACE BAR - 4" x 3 1/2" x 4" O.A.

HALF TRANS. BEAM - 9 1/2" x 34"

FACE BAR - 4" x 3 1/2" x 4" O.A.

12" x 34"

STG. 4" x 38" TO

24" x 36"

BRACKET 15" x 45"

5" x 5" x 45"

DECK - 30" IN VIEW OF
SPACING OF BEAMS
LONGS. 6" x 3" x 4" TO 36" O.A.

TRANS. BEAM - 11" x 34"

FACE BAR - 7" x 3 1/2" x 45" B.A.

HALF TRANS. BEAM - 10" x 34"

FACE BAR - 7" x 3 1/2" x 45" B.A.

TRIPPING LUG

TRANSVERSE - 15" x 4"

FACE BAR - 7" x 3 1/2" x 45" B.A.

SHELL ATTACHMENT - 5" x 5" x 4" O.A.

TRIPPING LUG

SPACING - 10" 9"
& AS PER PROFILE

7" x 3 1/2" x 50" O.A. WITH
14" RIVETS EACH SIDE
OF MARGIN

LONGS. - 6 1/2" x 3" x 36" TO 6" x 3" x 36" B.A.

TANK TOP - 32" TO 3"

3" x 3" x 4" TO 38"

T.T.C. - 4" TO 34"

DOUBLE

34" x 42" TO 36"

SINGLE 5" x 5" x 48"

4" x 4" x 48" TO 46"

KEEL

42" x 72" TO 52"

76

BOTTOM PLATING - 48" TO 40"

LONGS. - 6 1/2" x 3 1/2" x 4" TO 36" B.A.

(8 1/2" FITTED)

58" STRAP

SINGLE

SINGLE 5" x 5" x 48"

INTERMEDIATE FLOOR

LLOYDS NUMERALS

BREADTH M¹⁰ - 37.79

DEPTH M¹⁰ - 18.25


TRANSVERSE N° - 56.04

LLOYDS LENGTH AT UPPER D¹⁰ - 249.80

LONGITUDINAL N° - 13998

EQUIPMENT

	CWTS.
2 BOWER ANCHORS (STOCKLESS) - 33	94 CWTS.
1 " " " - 28	
1 STREAM " (EX. STOCK) - 8 1/2	
1 KEDGE " " - 4 1/2	
240 FATH. 1 1/2" STUD CHAIN CABLE	
75 " 4" STEEL WIRE (IN LIEU OF STREAM CHAIN)	
90 " 3 1/2" WIRE TOWLINE	
2@90 " 6" HAWSER (OR 2 1/4" WIRE)	
2@90 " 5" " (OR 1 3/4" WIRE)	

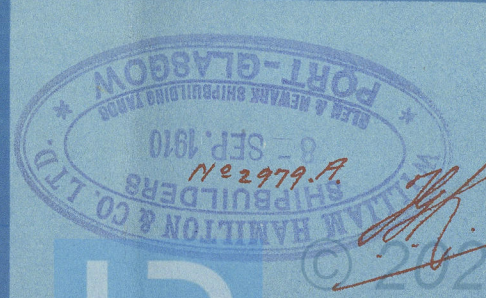

W1115-0149 1/2

FROM WM. HAMILTON & CO., LTD.,

GLEN SHIPBUILDING YARD, PORT-GLASGOW.

ENCLOSURE

FOR

Lloyd's Register
Foundation

Greenock

Midship Section


Hamilton & Co Ltd

No 214.

St. Thomas Holt

Greenock Report No. 15870

W115-0149

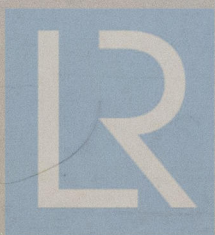

© 2020

Lloyd's Register
Foundation