

LLOYD'S STAMP

2/12/09.

PROFILE & DECK PLANS

LENGTH 249' 35 1/2" B.P. x 31' 15" M.L. x 18' 3" DEPTH M.L.



SCALE 1/8" = ONE FOOT

"ISHERWOOD SYSTEM" (PATENT)

S.S. No. 217

ALTERED TO LLOYD'S APPROVED PLAN 7/12/09.

ARRANGEMENTS TO BE ADOPTED FOR REDUCING SPANS OF LONGITUDINALS WHERE DISTANCE BETWEEN TRANSVERSES EXCEEDS 10'-0" OR LONGITUDINALS TO BE INCREASED.

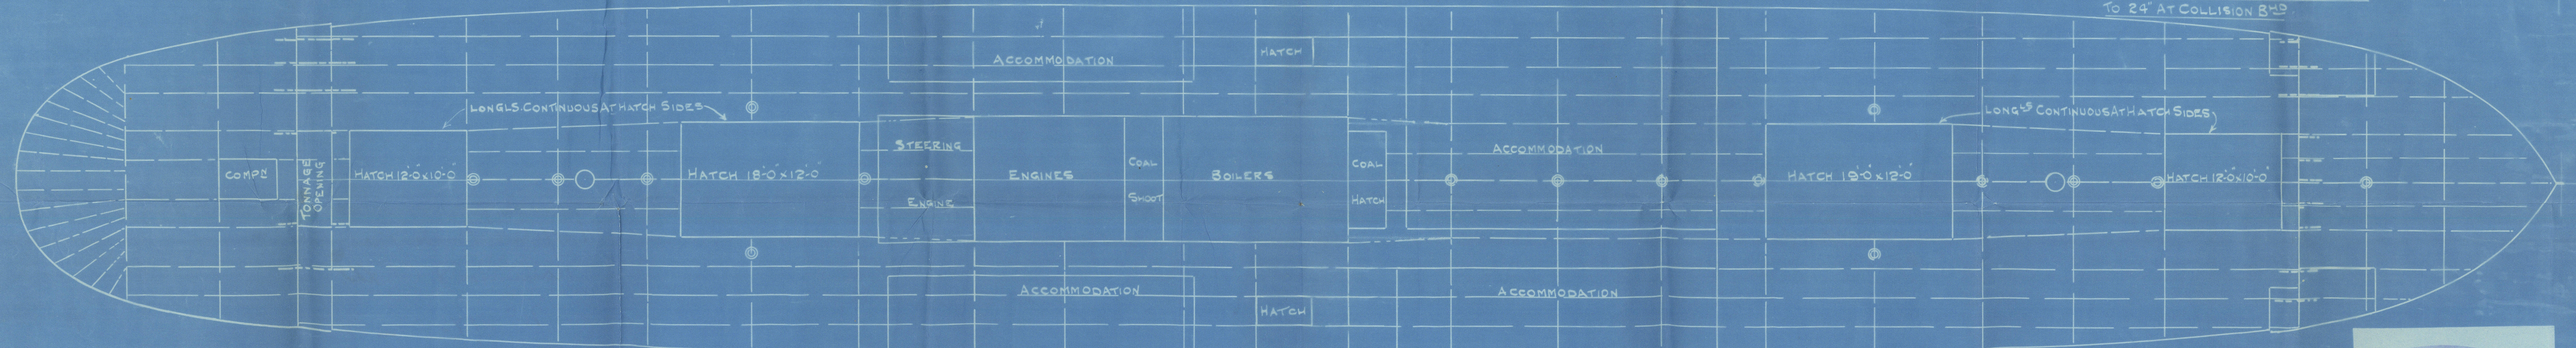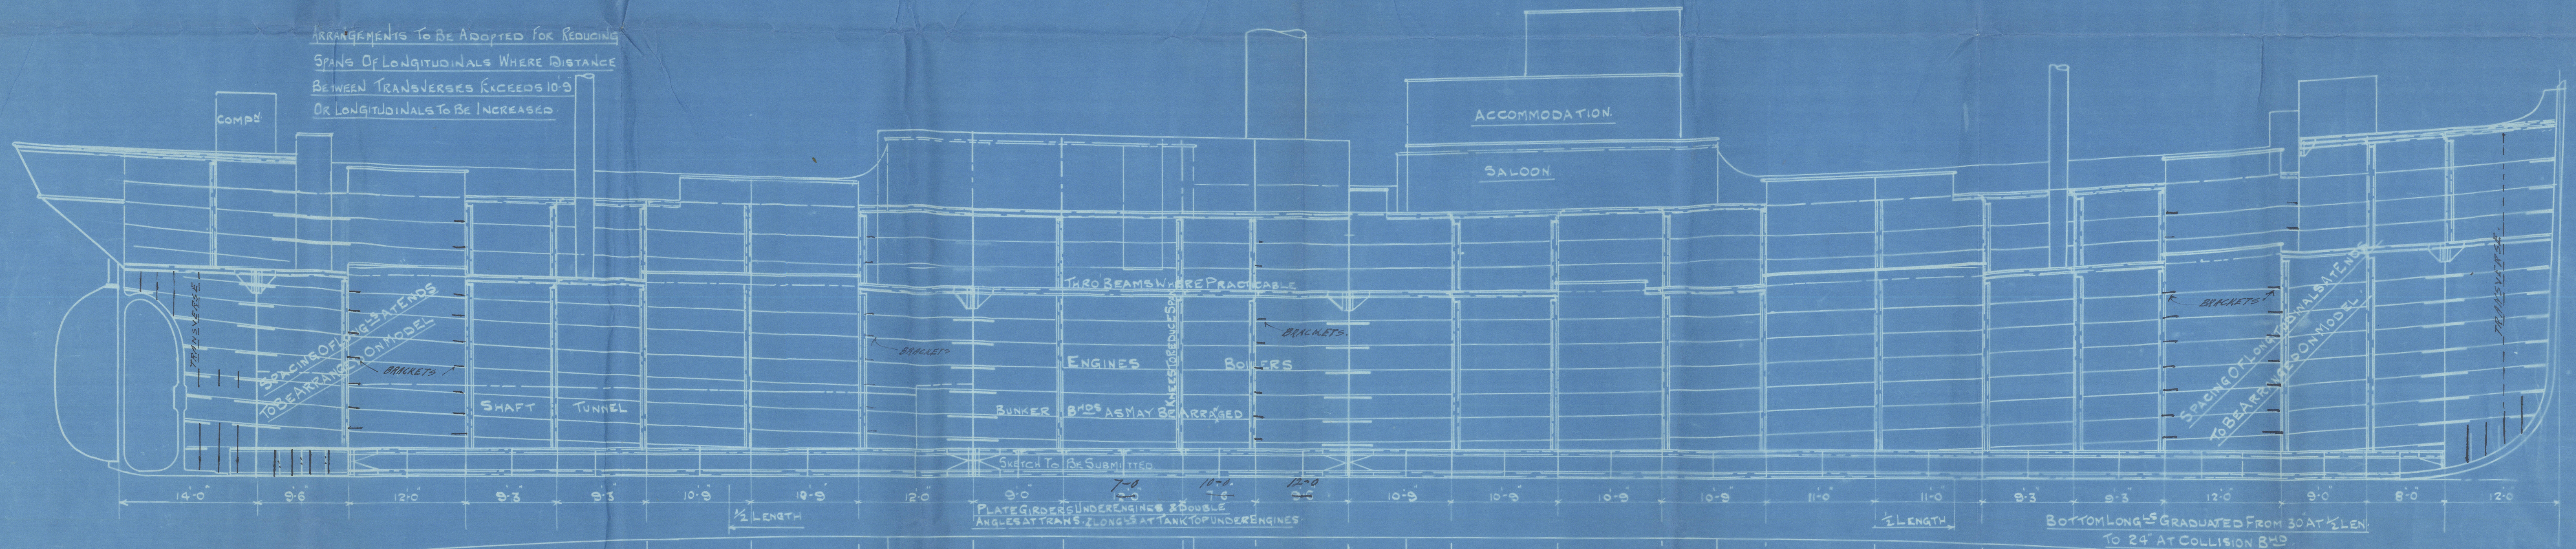


MESSRS W. HAMILTON & CO. LTD.


SHIPBUILDERS

PORT GLASGOW.

AWNING DECK

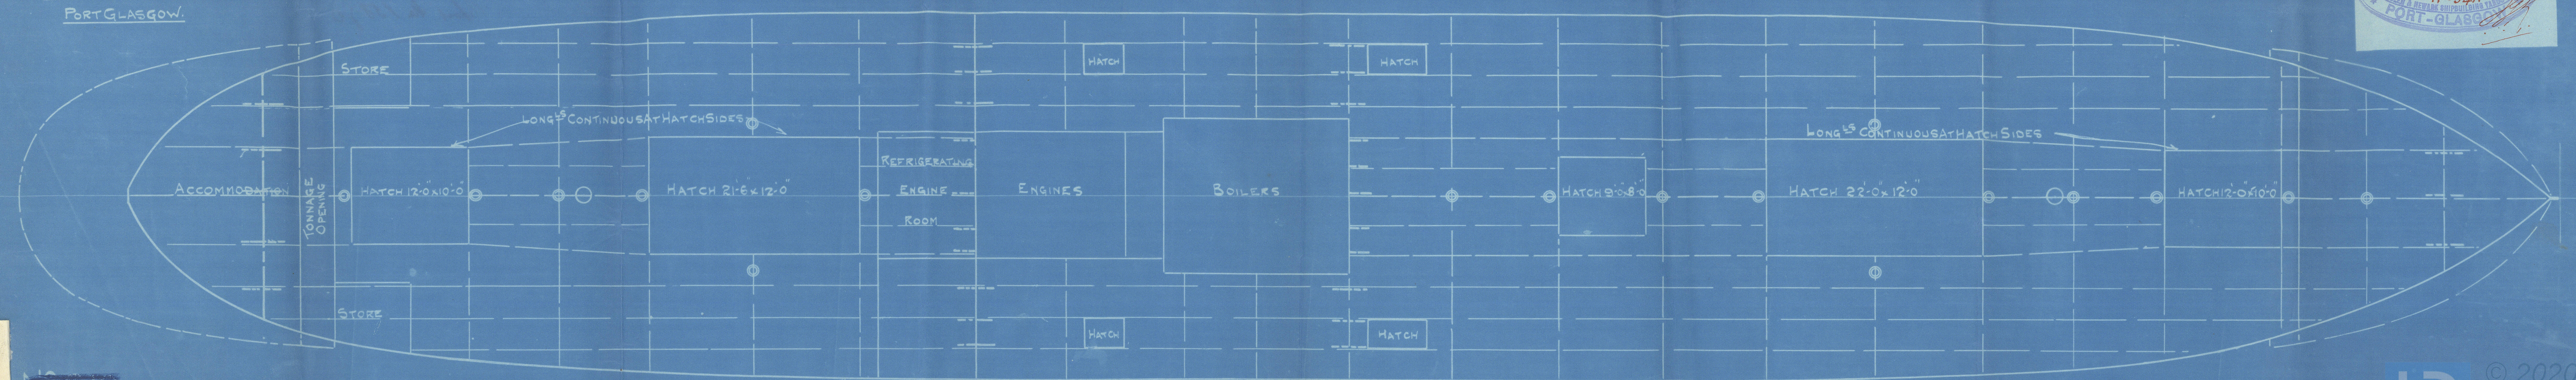

MAIN DECK

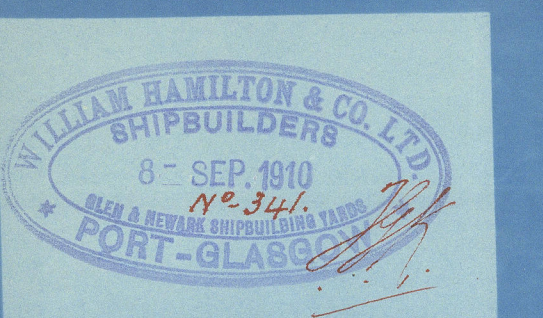

W1115 - 0150 1/2

FROM WM. HAMILTON & CO., LTD.,
GLEN SHIPBUILDING YARD, PORT-GLASGOW.

ENCLOSURE

FOR

Lloyd's Register
Foundation
Greenock

Profile & Deck Plan
Hamilton & Co. Ltd.

No 217.

M. "Thomas Holt"

Greenock Report No 15850

W115-0150

RECEIVED



© 2020

Lloyd's Register
Foundation