


P/58/3


BARCAZA-ALGIBE PARA 60 TONS.

ESCALA 1/15

CUADERNA MAESTRA

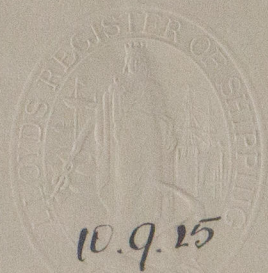

ESLORA	16'60 M.	54'5
MANCA	4'15 "	13'6
PUNTAL	1'75 "	5'75
CALADO	1'55 "	5'10

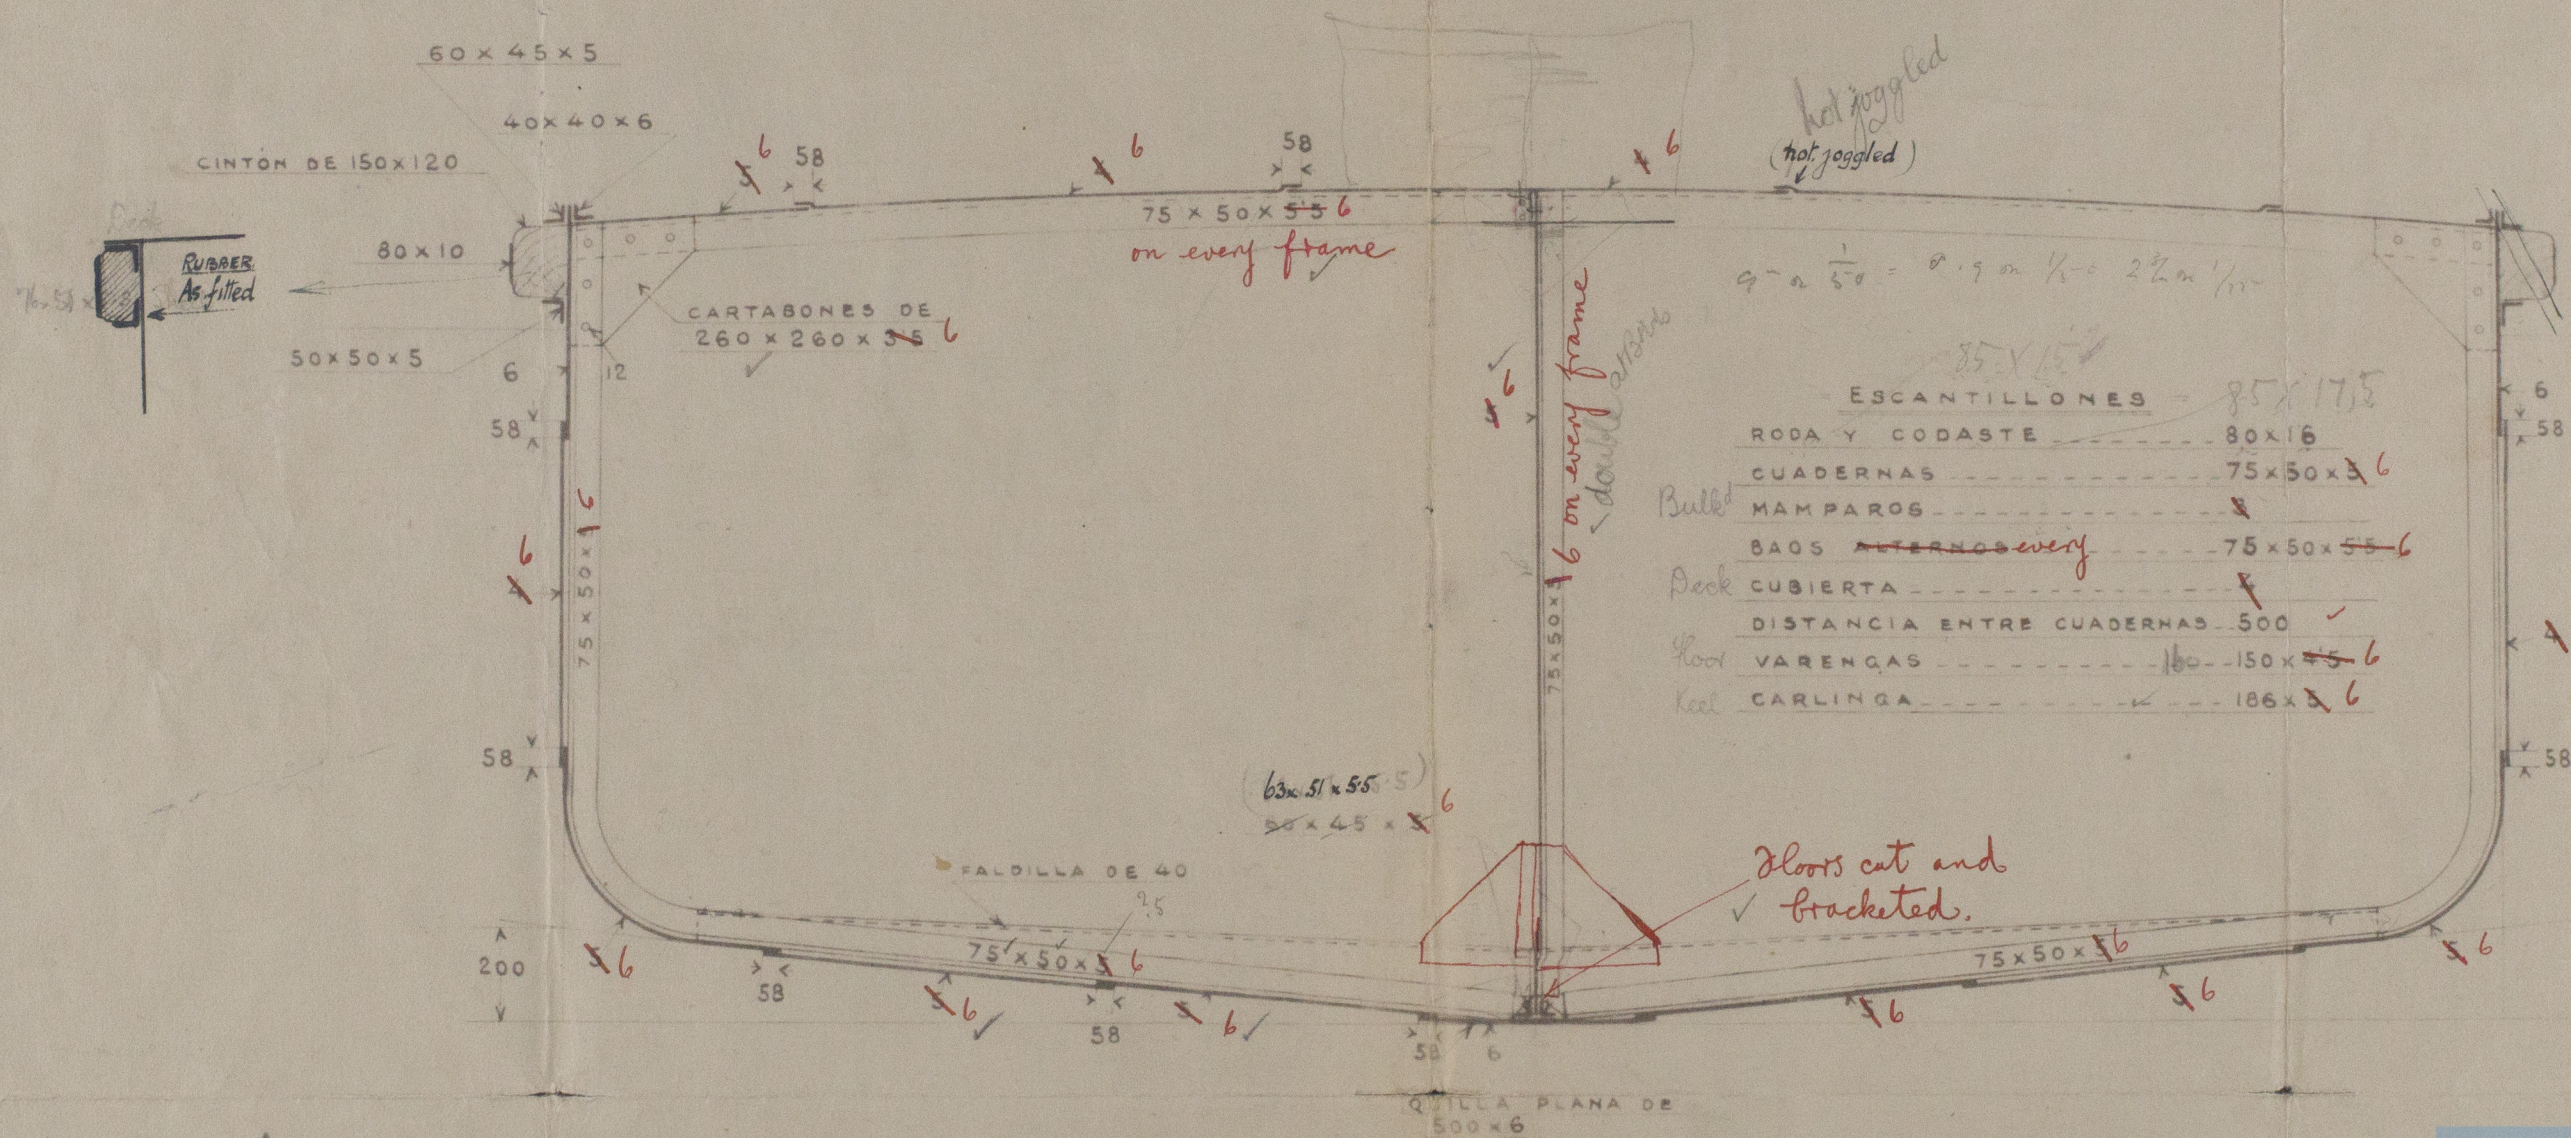

ACOTADO EN mm.



W.J.
9.9.25

DIBUJO Nº 50739-D

MATAGORDA 27-8-925

Cádiz 8/5/26
u/c

W1115-0185

Soc. Espanola. de Constrⁿ Naval
Cadiz
Water Barge. 'B.A. 1'

Midship Section

Cadiz Report No 1058

RETAIN



© 2020

Lloyd's Register
Foundation