

# MIDSHIP SECTION

SHOWING AMENDED SHELL PLATING


N<sup>o</sup> 162 SHIP

SCALE 1/2" = 1 FOOT

BRIDGE DECK

Upper Deck

Side plating to be reduced to in thickness  
in accordance with A. frames being carried  
up to Bondy Deck.

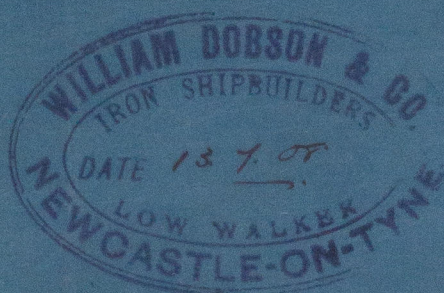



W1116-0161 1/2



W1116-0161<sup>2/2</sup>  
W DOBSON & Co., LOW WALKER.  
ENCLOSURE  
FOR  
Messrs Lloyd's Surveyors, Newcastle.

W. Dobson & Co

SS 162

Amended steel plating

W1116-0161



© 2020

Lloyd's Register  
Foundation



© 2020  
WH16-0161<sup>2/2</sup>

W DOBSON & Co., LOW WALKER.

ENCLOSURE

FOR

*by Messrs Lloyds Surveyors Newcastle.*