


22. 10. 02

Beams to be pillared to
Surveyor's satisfaction.

No 710411.
ELEVATION OF A STEEL SCREW TRAWLER
TO CLASS 100 A.I. LLOYDS
BUILDERS DIMENSIONS 105'-0" x 20'-9" x 12'-1"
SCALE 1/4" = ONE FOOT.

newcastle-on-Tyne
Profile of Screw Trawler
Built at Wood & Co
Jardine No 710411


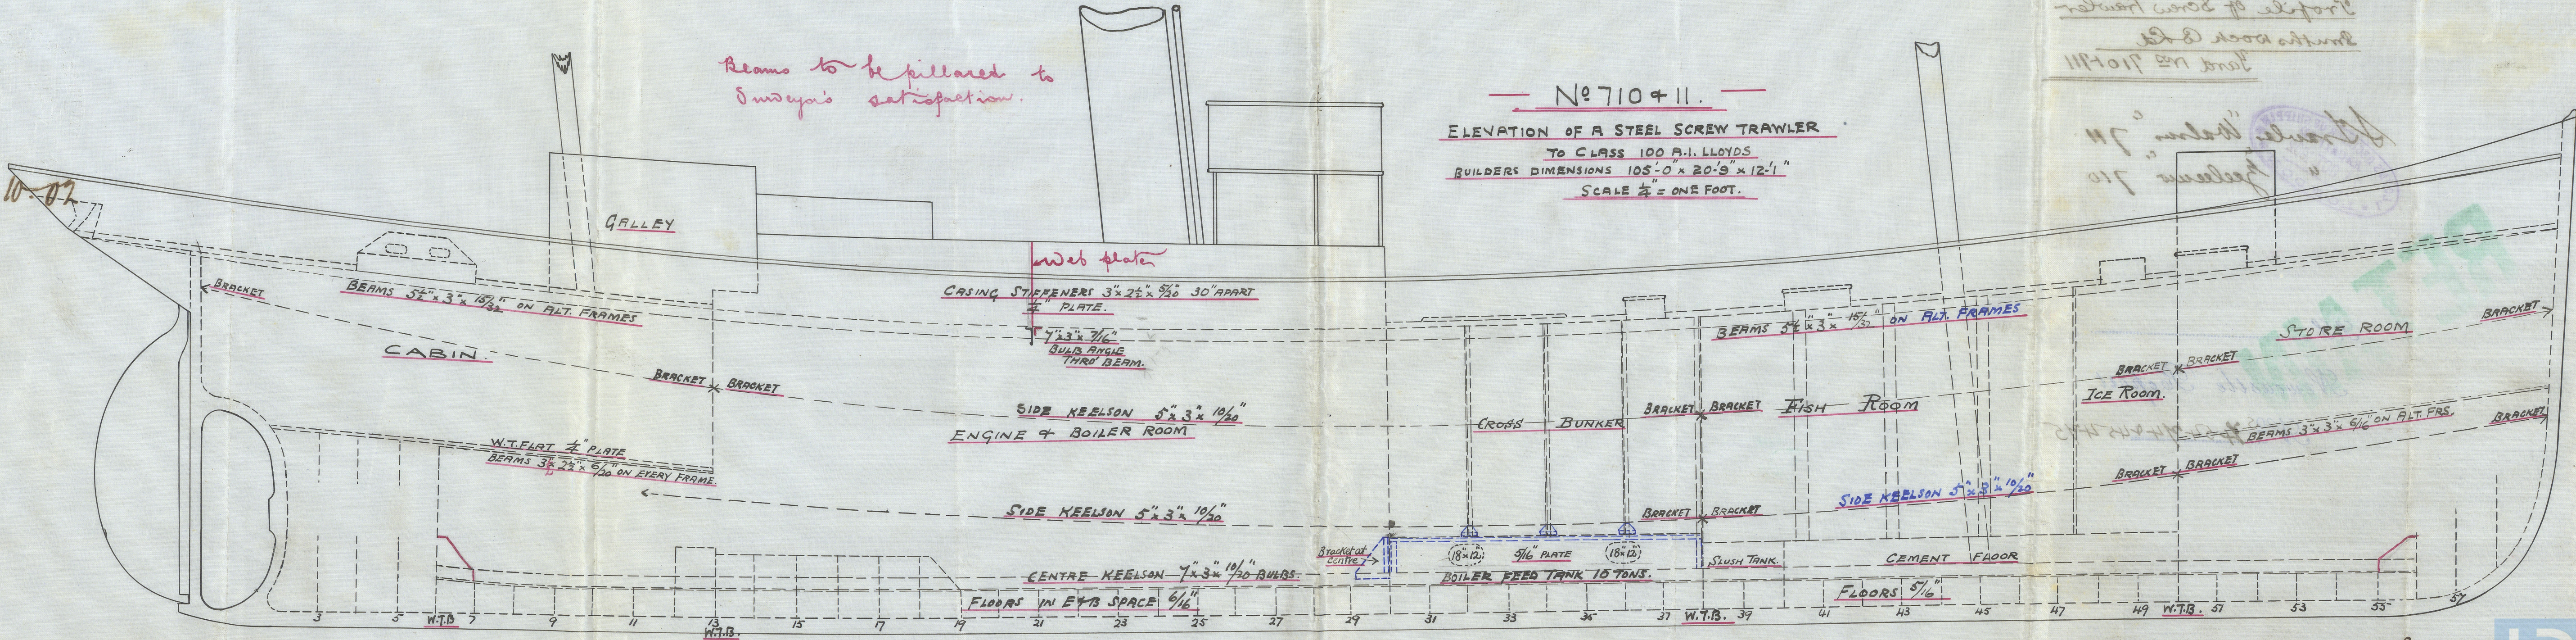

22. 10. 02

1100 - F111W

S. Truvel "Walrus" 711
" " Zeeluw 710

Newcastle Report

45474845475

117-0013