


13.11.05
1.6.06

Principal Dimensions
Length overall 264.6
Length between perps 258.0
Breadth extreme 46.2
Depth moulded 18.3

Nº 781 Ship.

Longitudinal Plan for Single Decked Tanker

Scale 1/8" = 1 Foot.

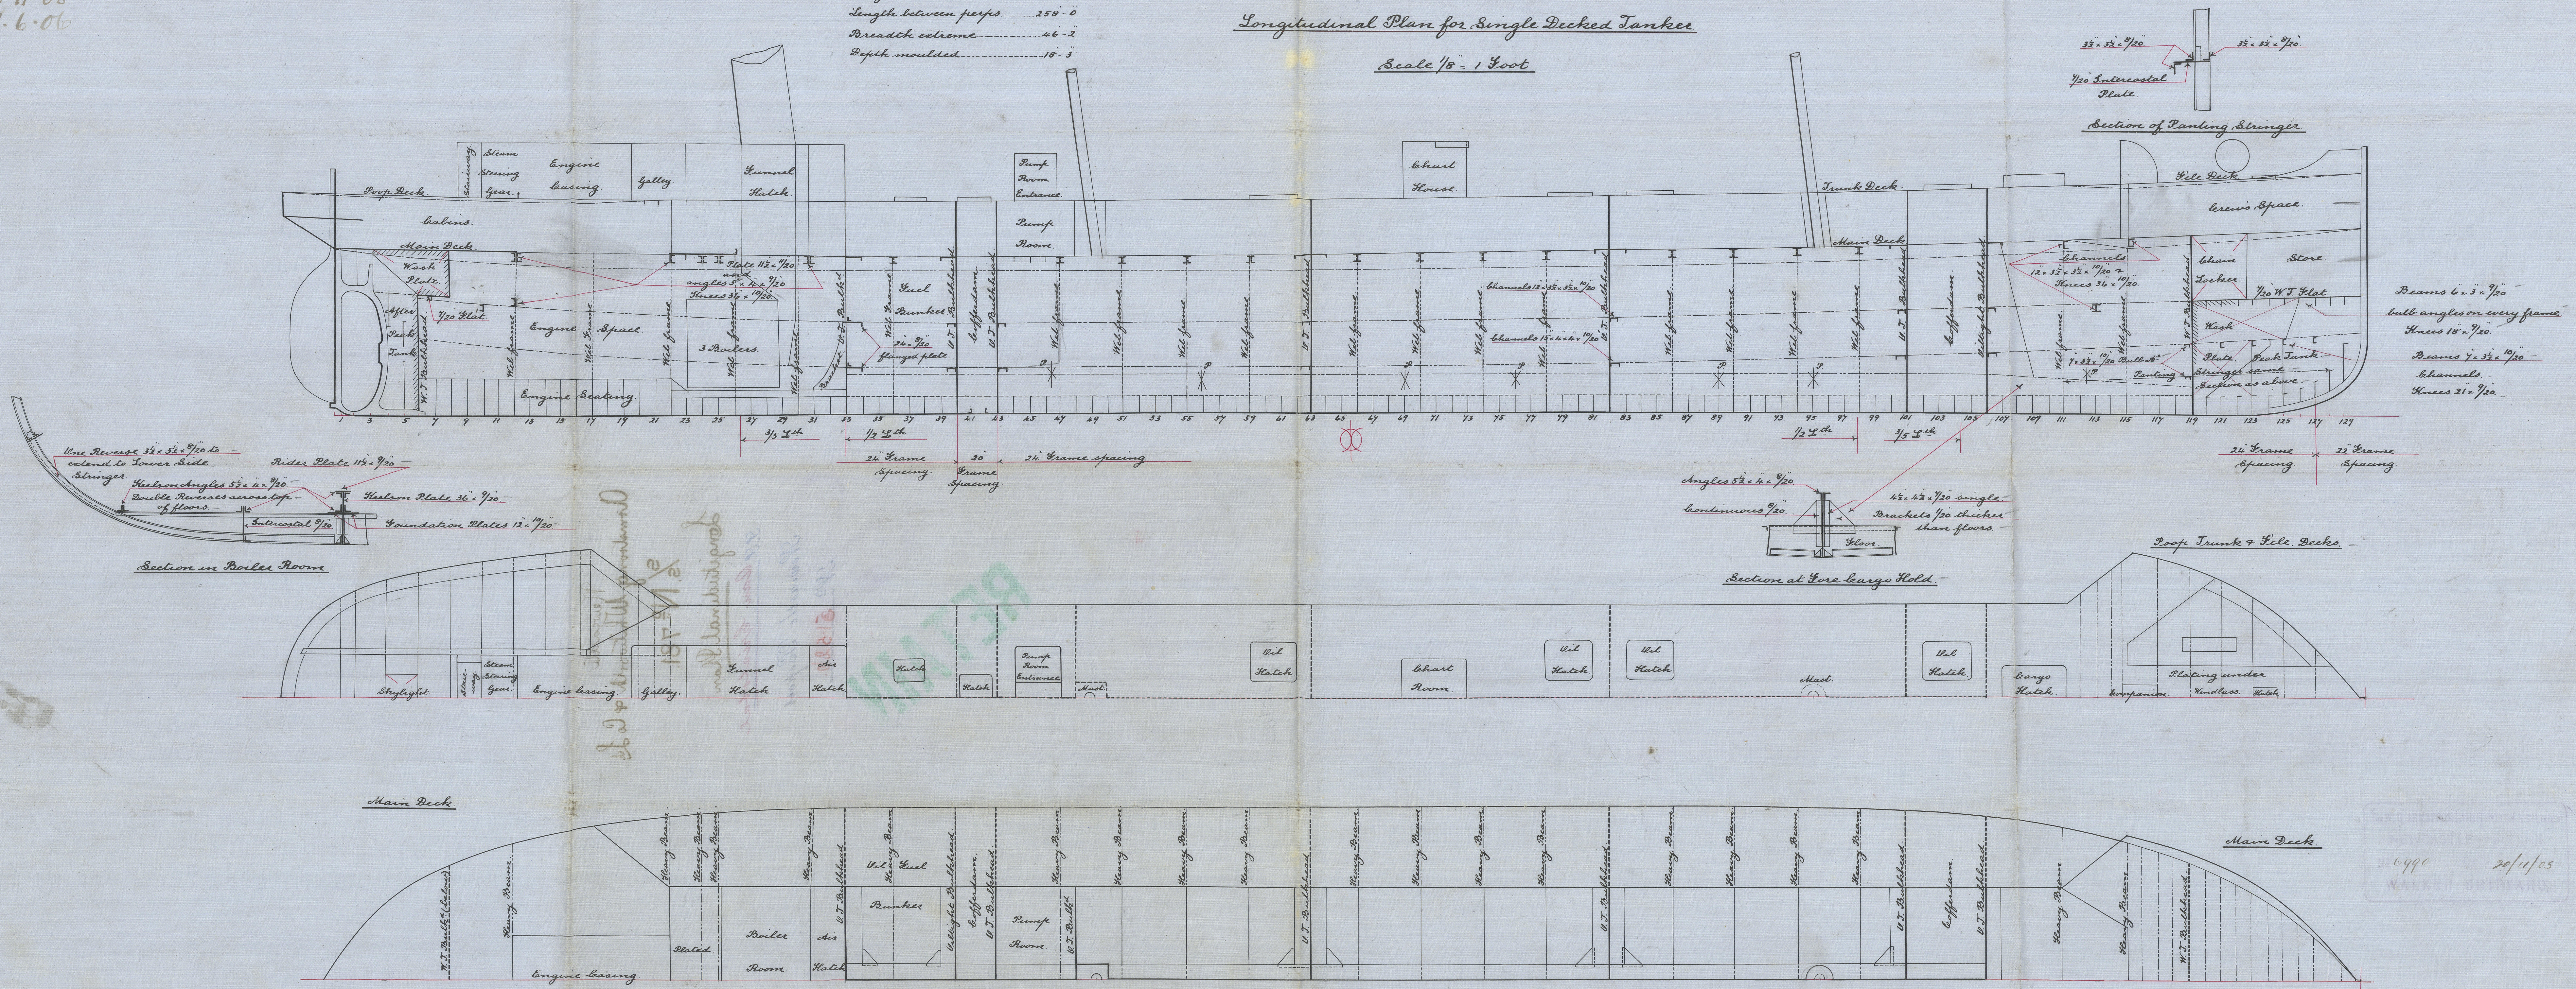

NEWCASTLE
6990 20/11/05
WALKER SHIPYARD

J.P.
23/11/05

W1117-0162

Newcastle
Armstrong Whitworth & Co Ltd

S/S. N^o 781.

Longitudinal Plan

J. J. Rau Cristobal

Newcastle Report

N^o 51.526.

REMAIN



© 2020

Lloyd's Register
Foundation

W1157-0162