

8/12/25

SHIP NO 543.


PROFILE DECK PLANS & SECTIONS.

TO CLASS 100A1 WITH FREEBOARD - EGYPTIAN COASTING

DIMENSIONS: 245'-0" LBP x 34'-0" B.M.P. x 19'-0" D.M.L.

TO LOAD TO 12'-5" L.W.L. ON LLOYDS SUMMER MARKS.

SCALE 1/8" = 1 FOOT.

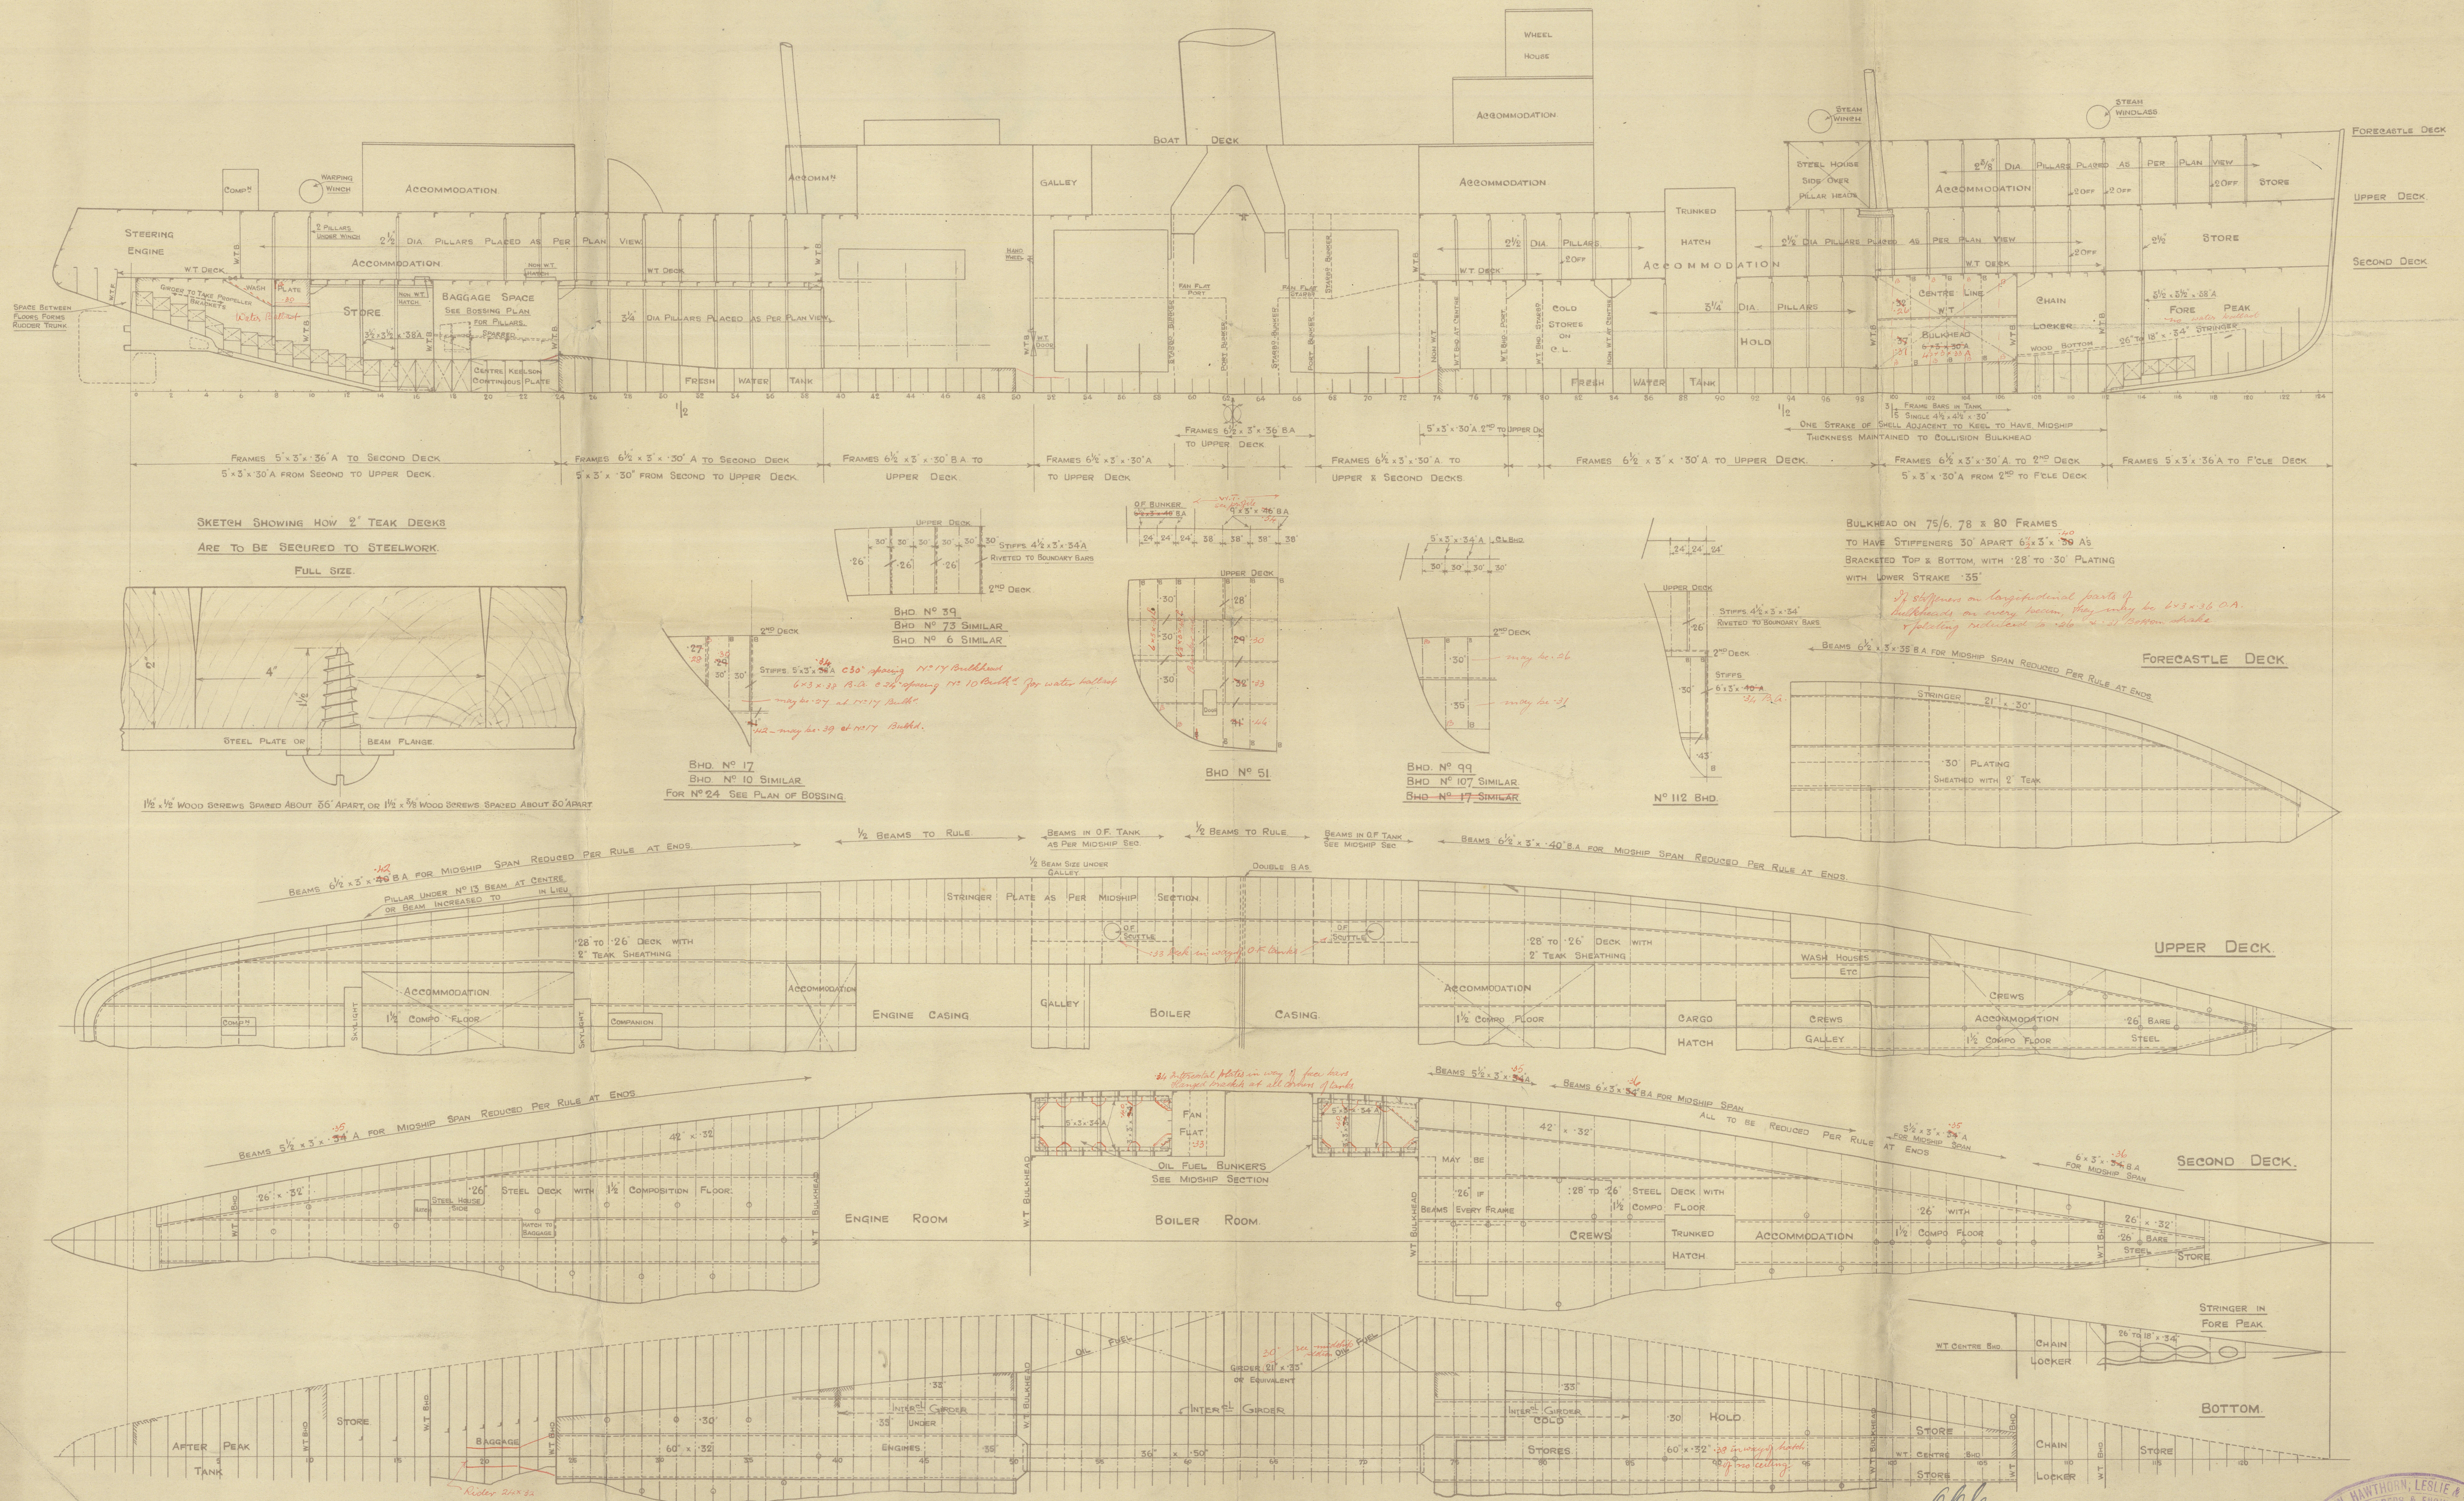

4

Hawthorn Leslie

543

Profile & deck Plans
(final) 34' beam

S.S. "EL. AMIR FAROUQ"

NEWCASTLE ON TYNE.

Report No.

8-12-25

Profile & Deck

RETAIN
RETAIN

W1118-0166



© 2021

Lloyd's Register
Foundation