



3.12.10

Mr. Lloyd's Surveyors
Hull

MIDSHIP SECTION


STEEL SCREW TRAWLER

488.
No 482.

DIMS 130'-0" x 22'-6" x 12'-9" MLD.

SCALE $\frac{1}{2}$ " = ONE FOOT

TO CLASS 100 A1 AT LLOYDS FOR FISHING
PURPOSES, ENGINE & BOILER CASING AS PREVIOUSLY
APPROVED, DECK PLATED OVER IN WAY OF ENGINE
AND BOILER CASING.

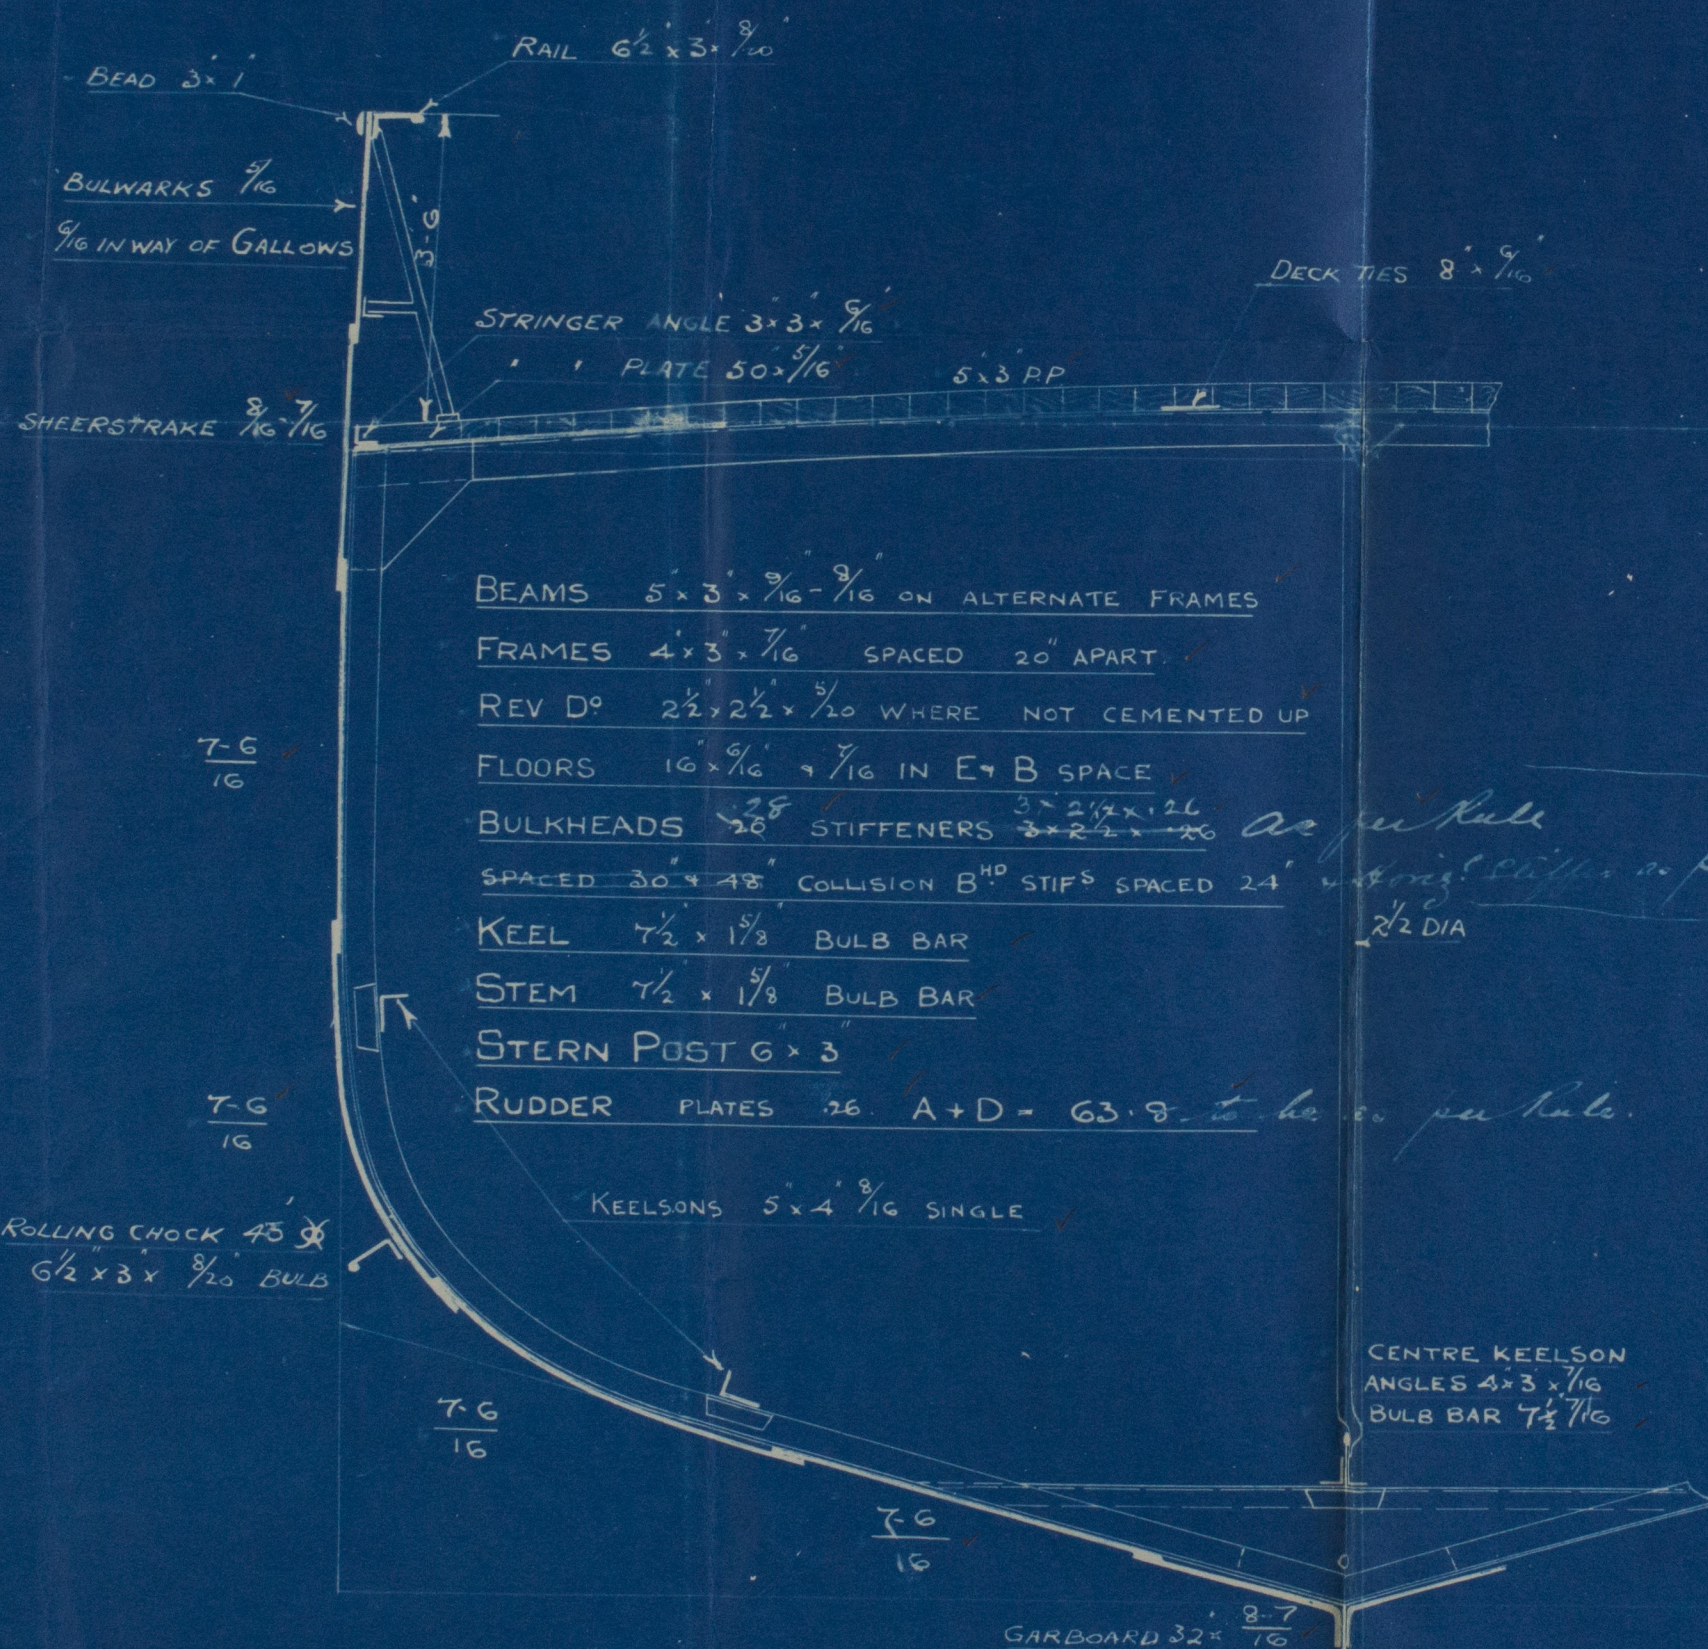

NUMERALS

$$B+D = 35.12$$

$$L \times (B+D) = 4565.60$$

PROPORTIONS

$$\frac{L}{D} = 10.19$$

$$\frac{L}{B} = 5.8$$

EQUIPMENT

1ST BOWER ANCHOR	5 3/4 CWTs EX STOCK
2ND " "	5 1/4 " " "
KEDGE ANCHOR	3 " " "
105 FATHOMS	1 1/6 CABLE
60 " "	6 HAWSER
60 " "	5 WARP

RIVETING


BUTTS OF GARBOARD & SHEERSTRAKE STRAPPED
" DOUBLE RIVETED, REMAINDER OF SHELL
LAPPED & DOUBLE RIVETED BULWARKS
SINGLE RIVETED.



-Midship Section-
Cochrane & Sons-

N 488

RETAIN

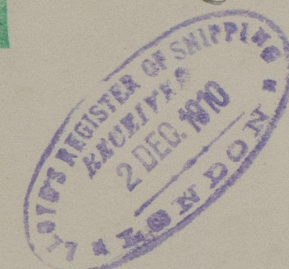

of Princeps
Hull Rpt no 24137

