

1/12/10

13'-0" OUTSIDE DIAM. 10'-6" OUTSIDE LENGTH
180 LBS ☐

BOILER N° 923

CHARLES D HOLMES & CO LTD
ENGINEERS & BOILER MAKERS
HULL.

ILM

30/11/10
1/923 JAL

RETAIN

Messrs
Charles D. Holmes & Co.

Boiler No 923

Sc. R. Princeps
Hull Report No 24-137


No 1813

Lloyds Test

360 lbs.

J.B.

18.5.11

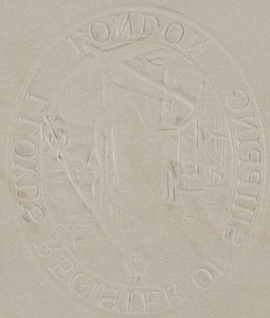

© 2020

Lloyd's Register
Foundation

W1120-0019