

MIDSHIP SECTION

DIMENSIONS

LENGTH 3 P 225-0" BREADTH MLD 36-0" DEPTH MLD 14-0"

To CLASS 90. A.I. AT LLOYD'S "SINGLE DECK"

1/2" SCALE

EQUIPMENT

LENGTH OF POOP 30-8" BRIDGE 58-0" FORE 30-3"

EQUIPMENT N° 15413 LETTER N


3 BOWER ANCHORS COLLECTIVE WEIGHT 75 CWT. STOCKLESS

1 STEAM	6 1/2 CWT. EX STOCK	✓
1 KEDGE	3 1/2	✓
210 FATHOMS OF	1 1/2" STUO CHAIN CABLE	✓
75	3 1/2" STEEL WIRE HANSE	✓
30	3/4" TOWLINE	✓
90	6" MANILLA HANSE	✓
90	5" WARP	✓
1 1/2 75	2 1/2" STEEL WIRE HANSE	✓
2 90	5" MANILLA	✓

LENGTH FROM BRIDGE SIDE OF STEM TO FORE SIDE OF STERN POST 223-10
BREADTH MOULDED 36-0
DEPTH TO SKIN 10-0 9" ROUND UP OF BEAM 14-9
DEPTH TO LENGTH 15-11

(No 176) 15.10.07
29.1.08
18.3.08
2 GIRTH
1/2 BREADTH
DEPTH

NUMERALS
30.24
18.00
4.75
62.99. 1ST N°
223.83
1404. 2ND N°

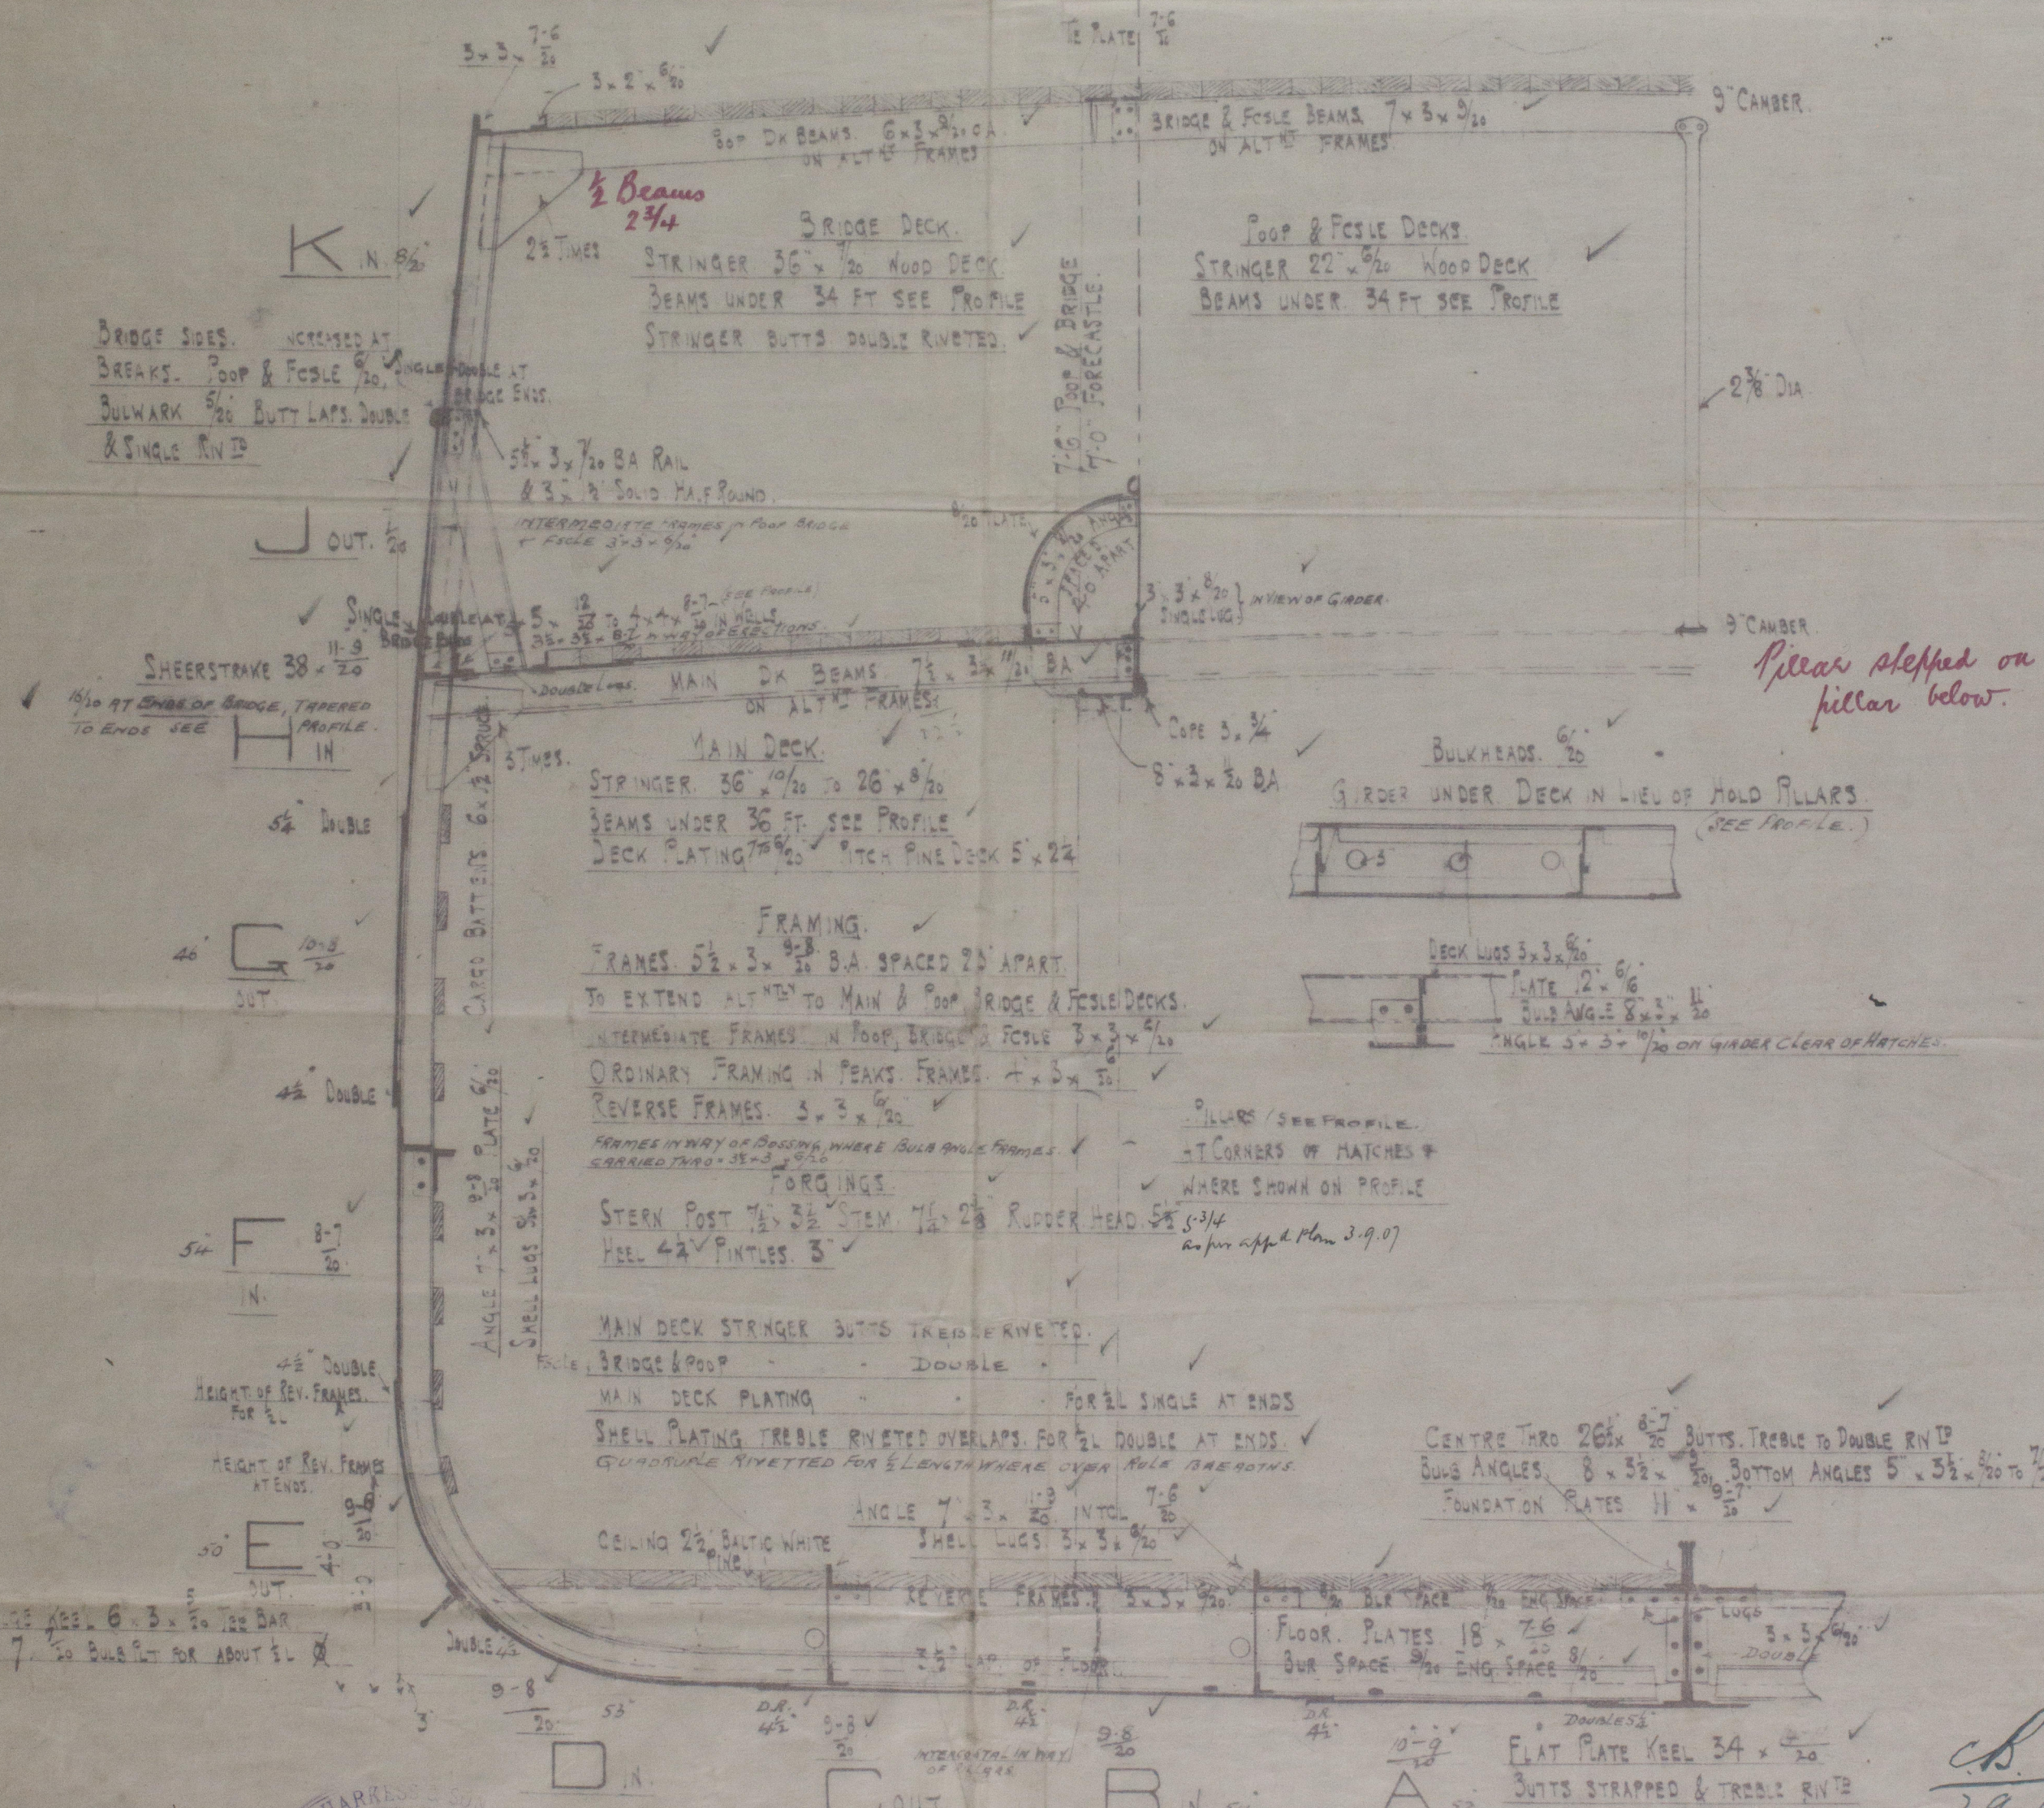

Pillar stepped on pillar below.

N. HARRISS & SON LTD
SHIPBUILDERS & REPAIRERS
EAST SLIPWAY
MIDDLESBROUGH-TEES.

W. HARRISS & SON LTD
SHIPBUILDERS & REPAIRERS
8 SEP 1907
No. 1519
Middlesbrough-Tees







© 2020
Lloyd's Register
Foundation
174
11/9/07
W1121-0127

N. Hankins & Son W 174
Mid. Sec. 2176




174. $\frac{3}{4}$ Bars
Mdb rft W. 5413



S.S. Bida

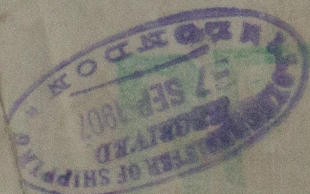 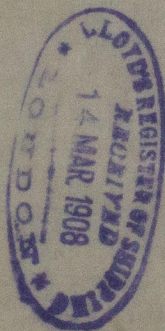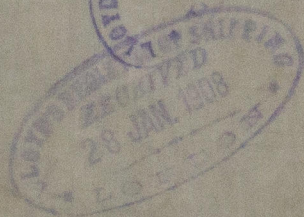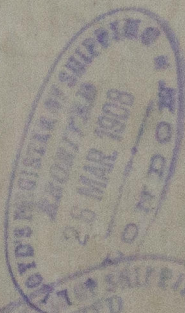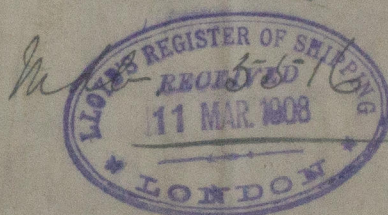

ELTAIN

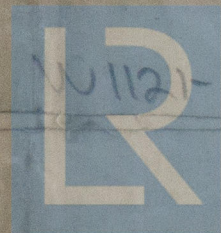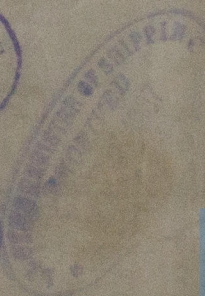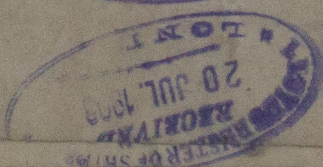

© 2020

W1121-0127

Lloyd's Register
Foundation