

# PROFILE & DECK PLANS

STEEL SCREW STEAMER

DIMENSIONS


LENGTH BP 225'0" BREADTH MLD 36'0" DEPTH MLD 14'0"

TO CLASS 90A1 AT LLOYDS





SCALE

LLOYDS 1" = 6'2" 93'2" = 14'10"

11.9.07  
5.10.07  
15.10.07  
29.1.08 (m H)  
18.3.08

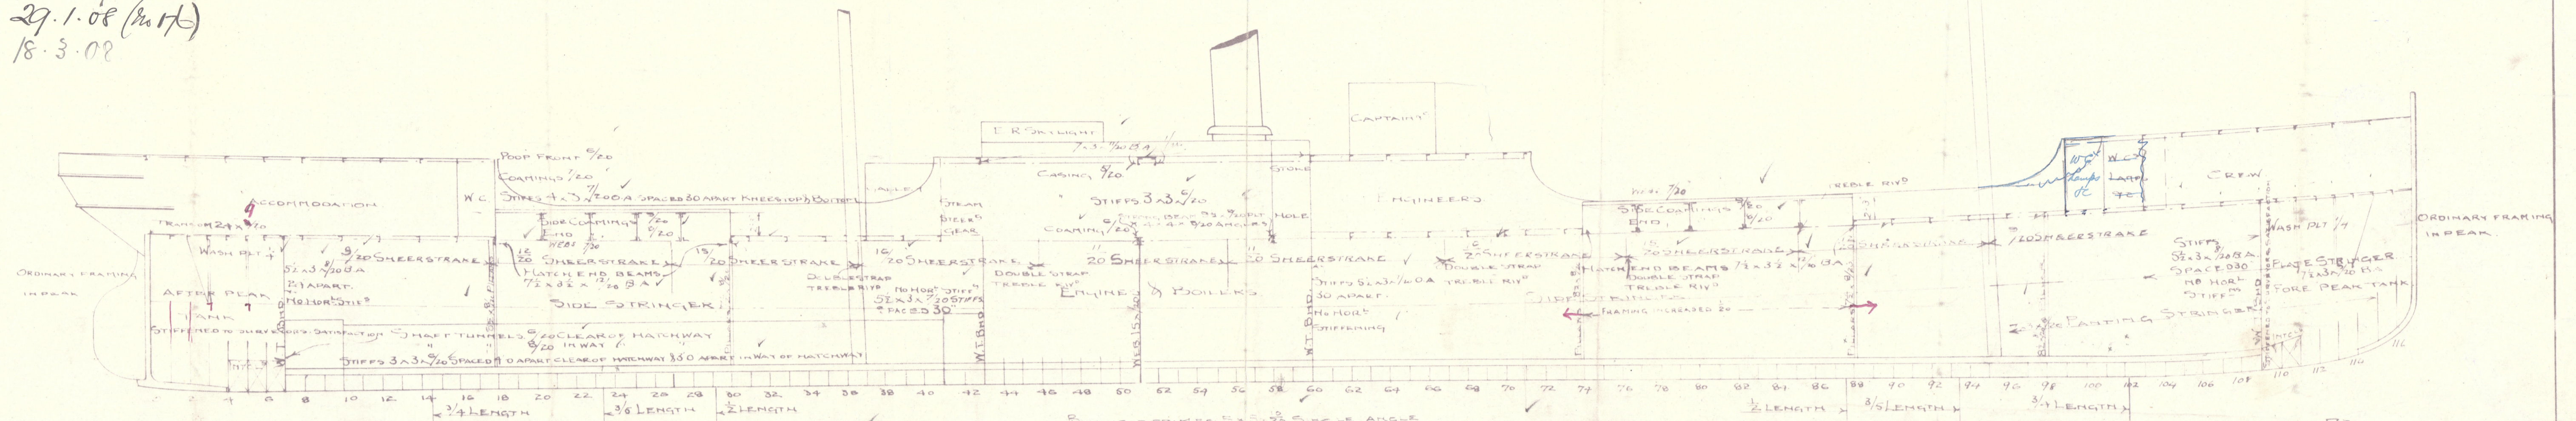

Bottom forward strengthened as per Rule 4 of free form forward.

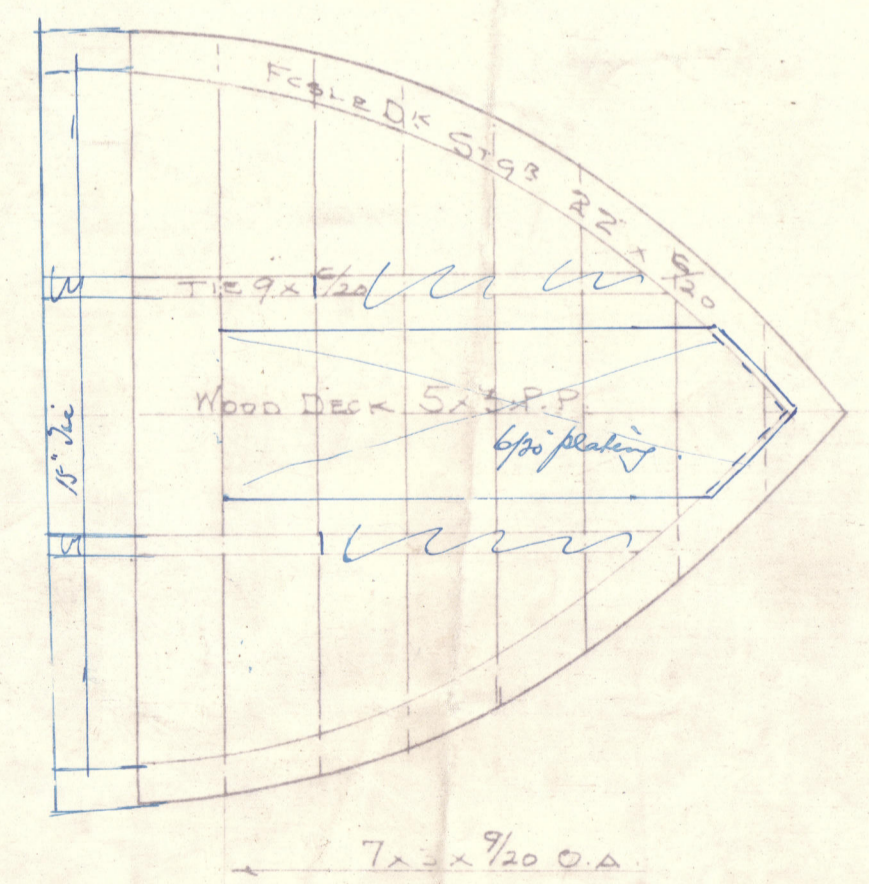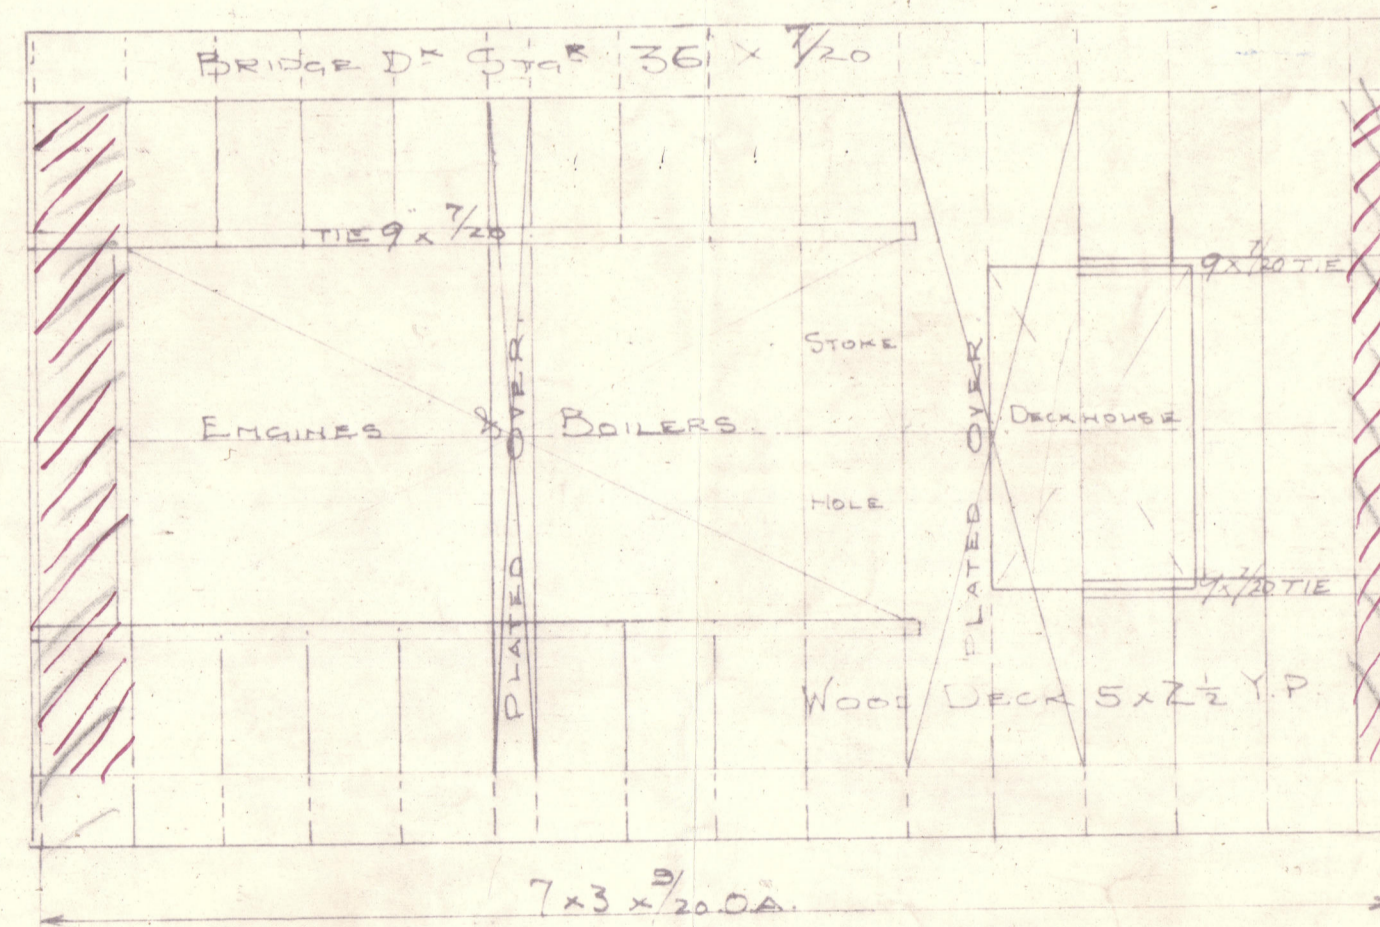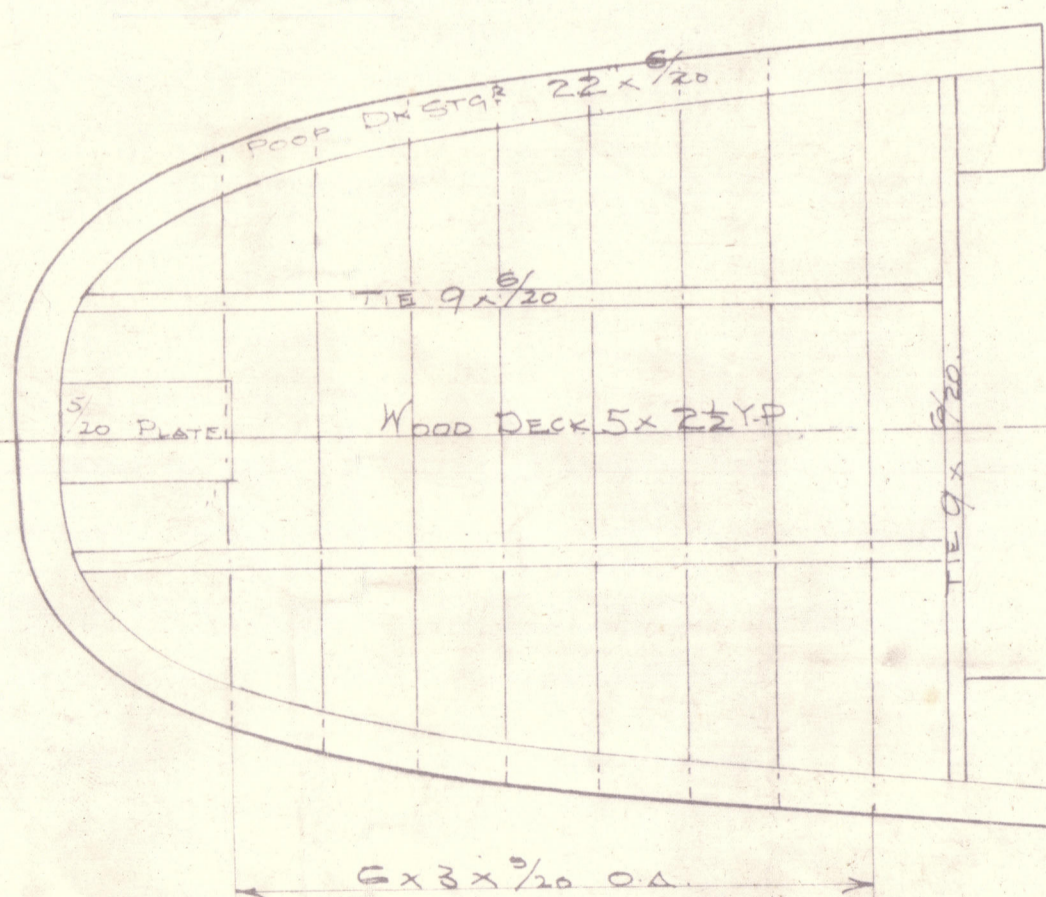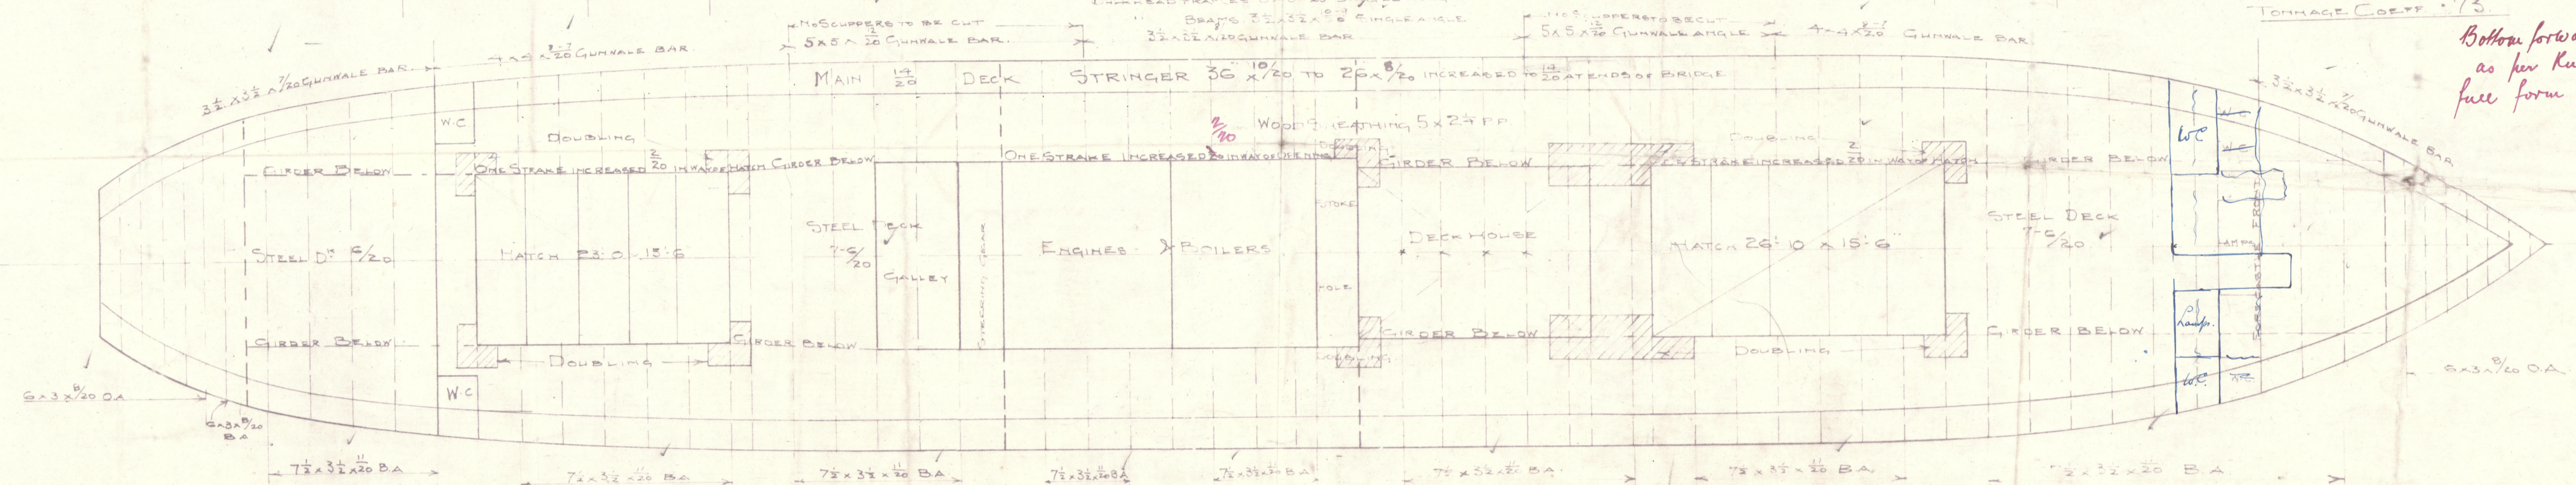

H. HARRISS & SON LTD.  
SHIPBUILDERS & REPAIRERS  
EAST SLIPWAY  
MIDDLEBROUGH-ON-TEES

C.F.  
11/9/07




C.F.  
29.1.07





Nº 174

W. Harkness & Son Esq 174  
Profile & Deck Plans 2176

sp Baro  
Indb rpt no. 5413

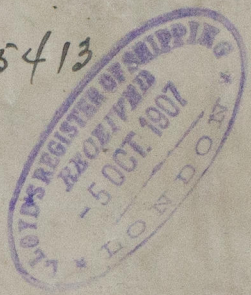

sp Bida  
Indb report no 5516

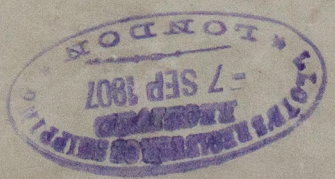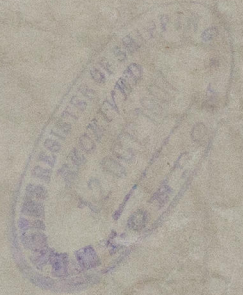

RETAIN



© 2020 Lloyd's Register Foundation

W1121-0129