


27/5/25

MIDSHIP SECTION

S. S. "RUTH"

SCALE 1/2" = ONE FOOT.

DIMENSIONS :- 100'-0" x 23'-0" x 11'-4" M-L

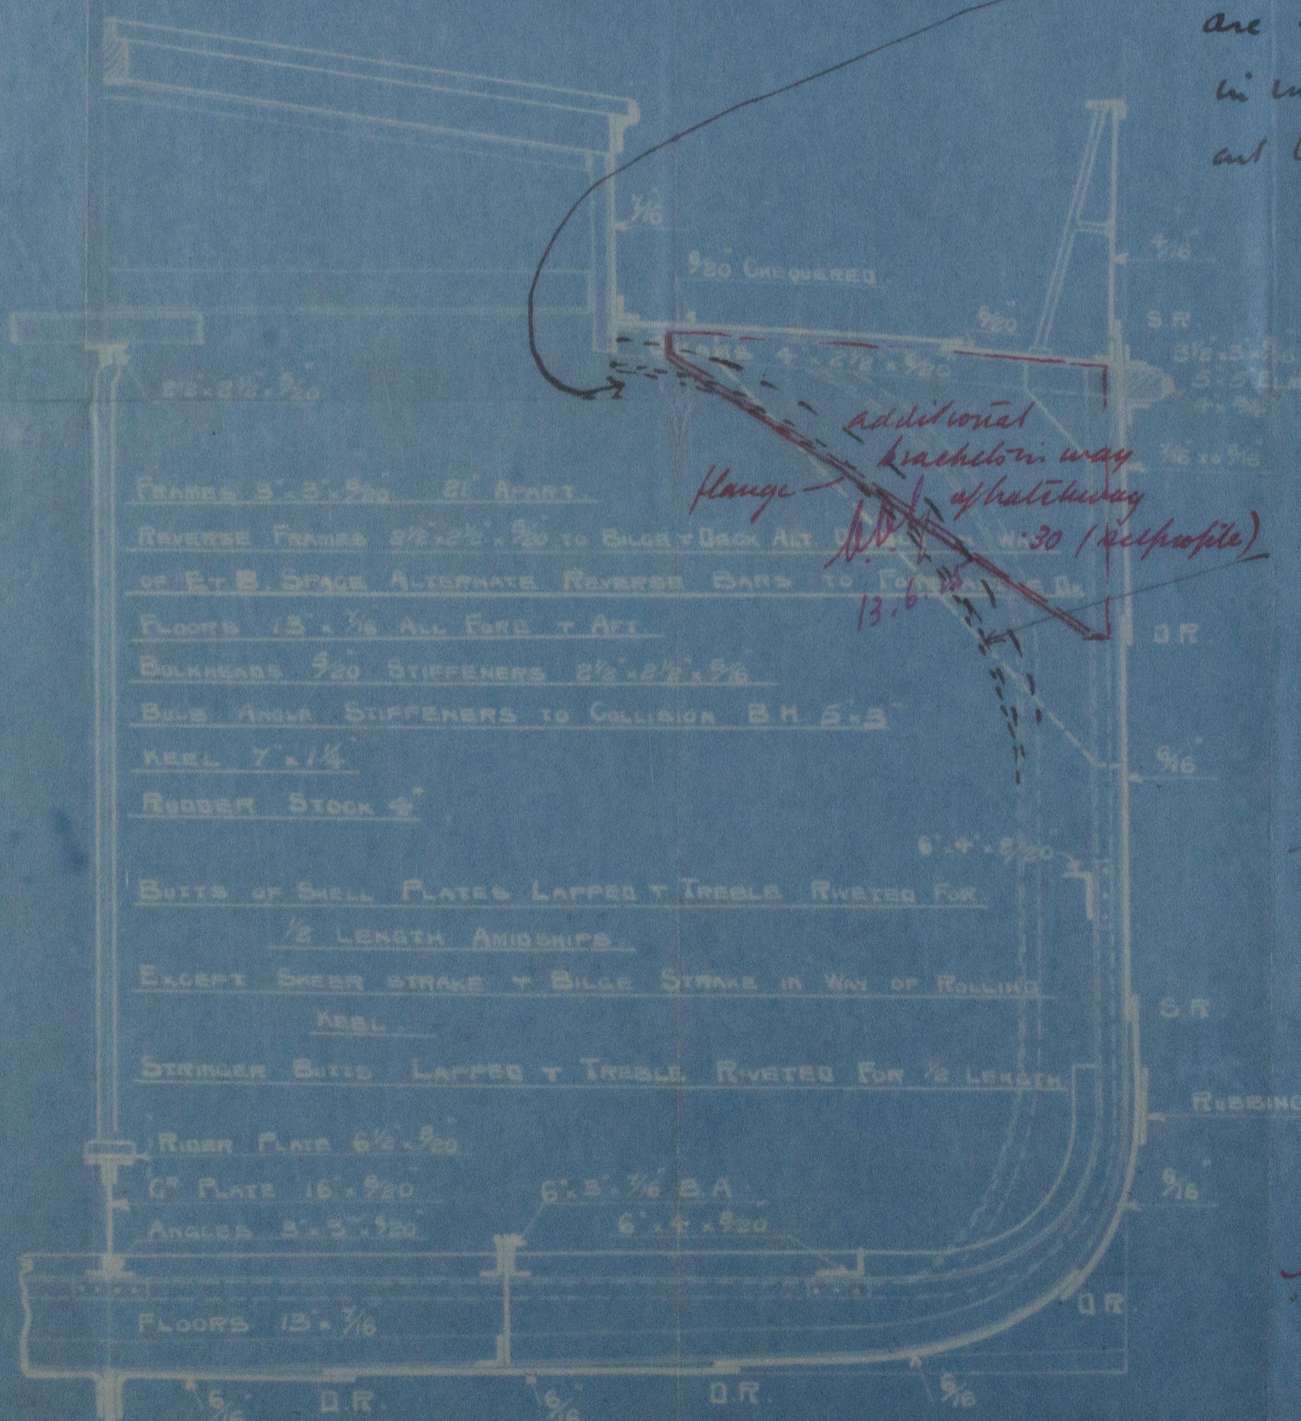

deep web frames at 32 and 34 are actually as indicated in ink extending right out to hatch

flanged brackets at each end of hatch 4'-7\"/>

Through beams to hold Z bars formed of two 4x3x7/16 angle L

See letter.

B.B.G.

27.5.25



© 2020
Lloyd's Register
Foundation
W1121-0333

MIDSHIP SECTION

STEAMER

'RUTH'

RETAIN

PLYMOUTH

London

© 2020

6 25

Lloyd's Register
Foundation

W1121- 0333