

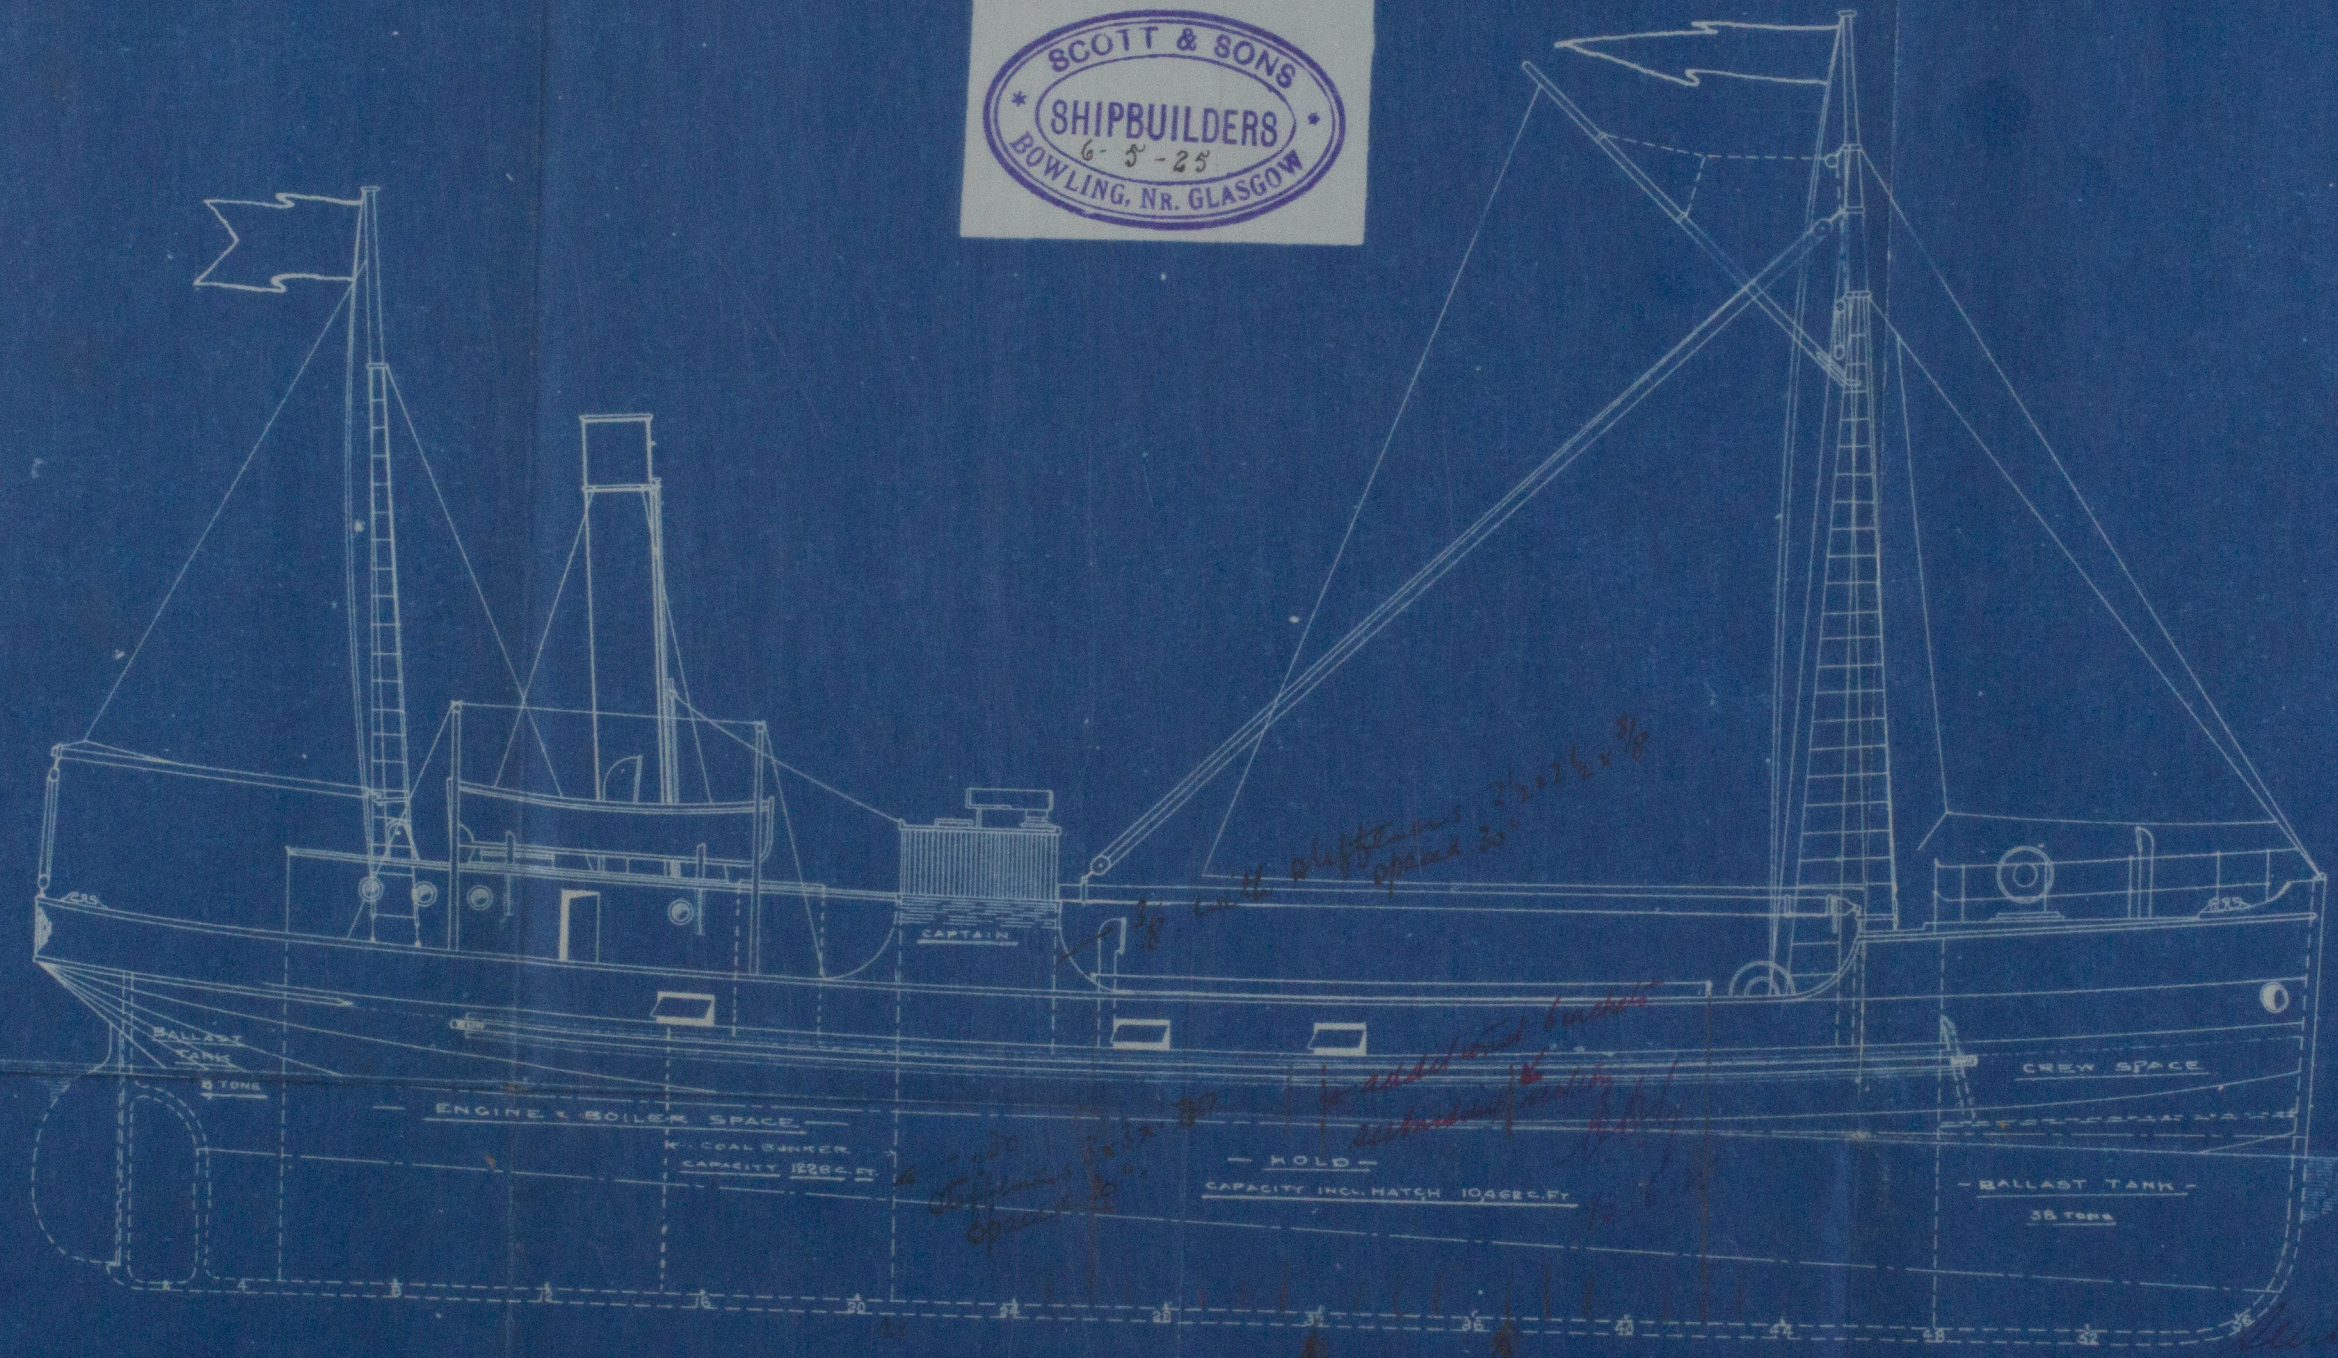


— RIGGING PLAN —
— S. S. RUTH —
— SCALE 1/8" = 1 FOOT —
— DIMENSIONS 100 FT. x 23 FT. x 11-4 MLD —

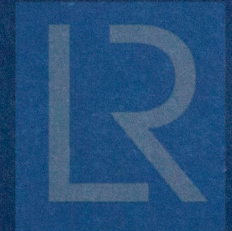

deep web frames
at 32 and 37

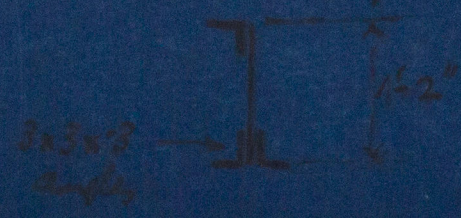

ARRANGEMENT

2

RIGGING

S/S "RUTH"

PLYMOUTH.

RETAIN



© 2020

Lloyd's Register
Foundation

W1121-0334