
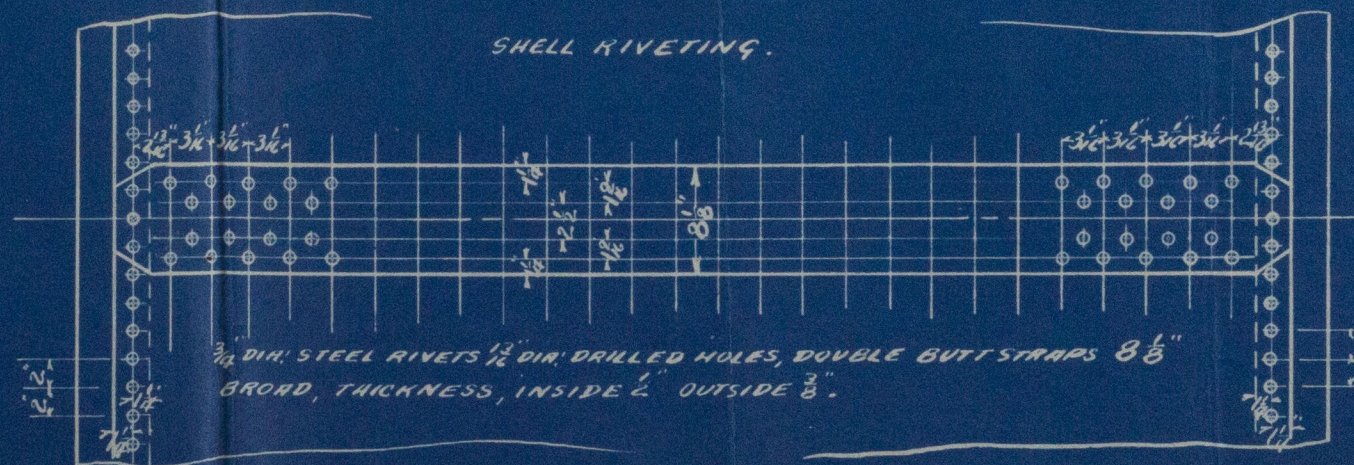
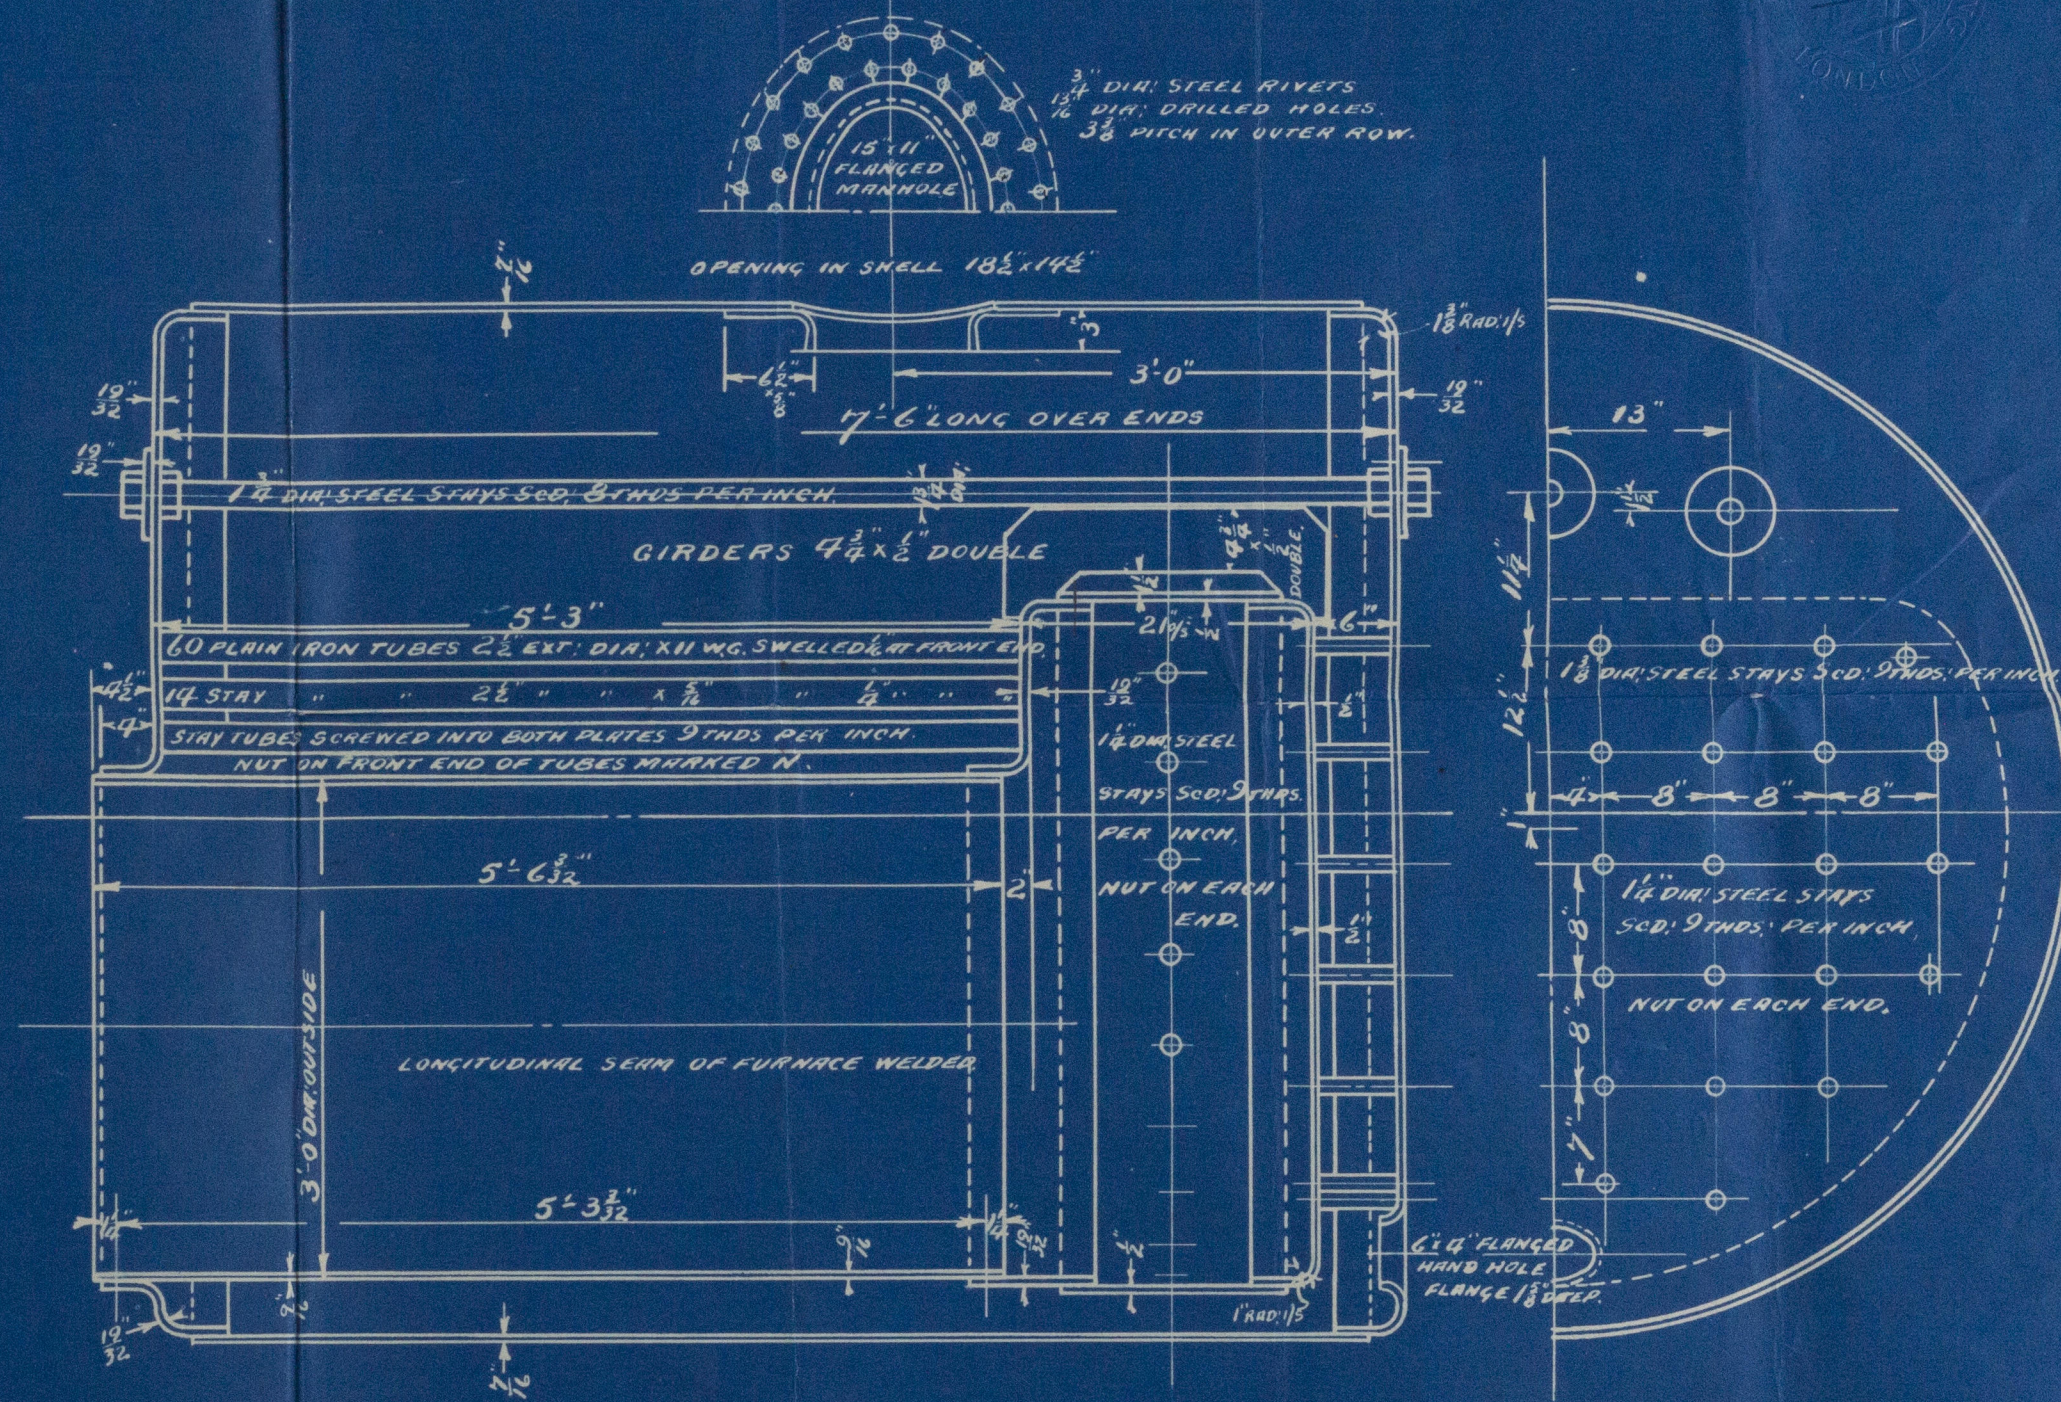
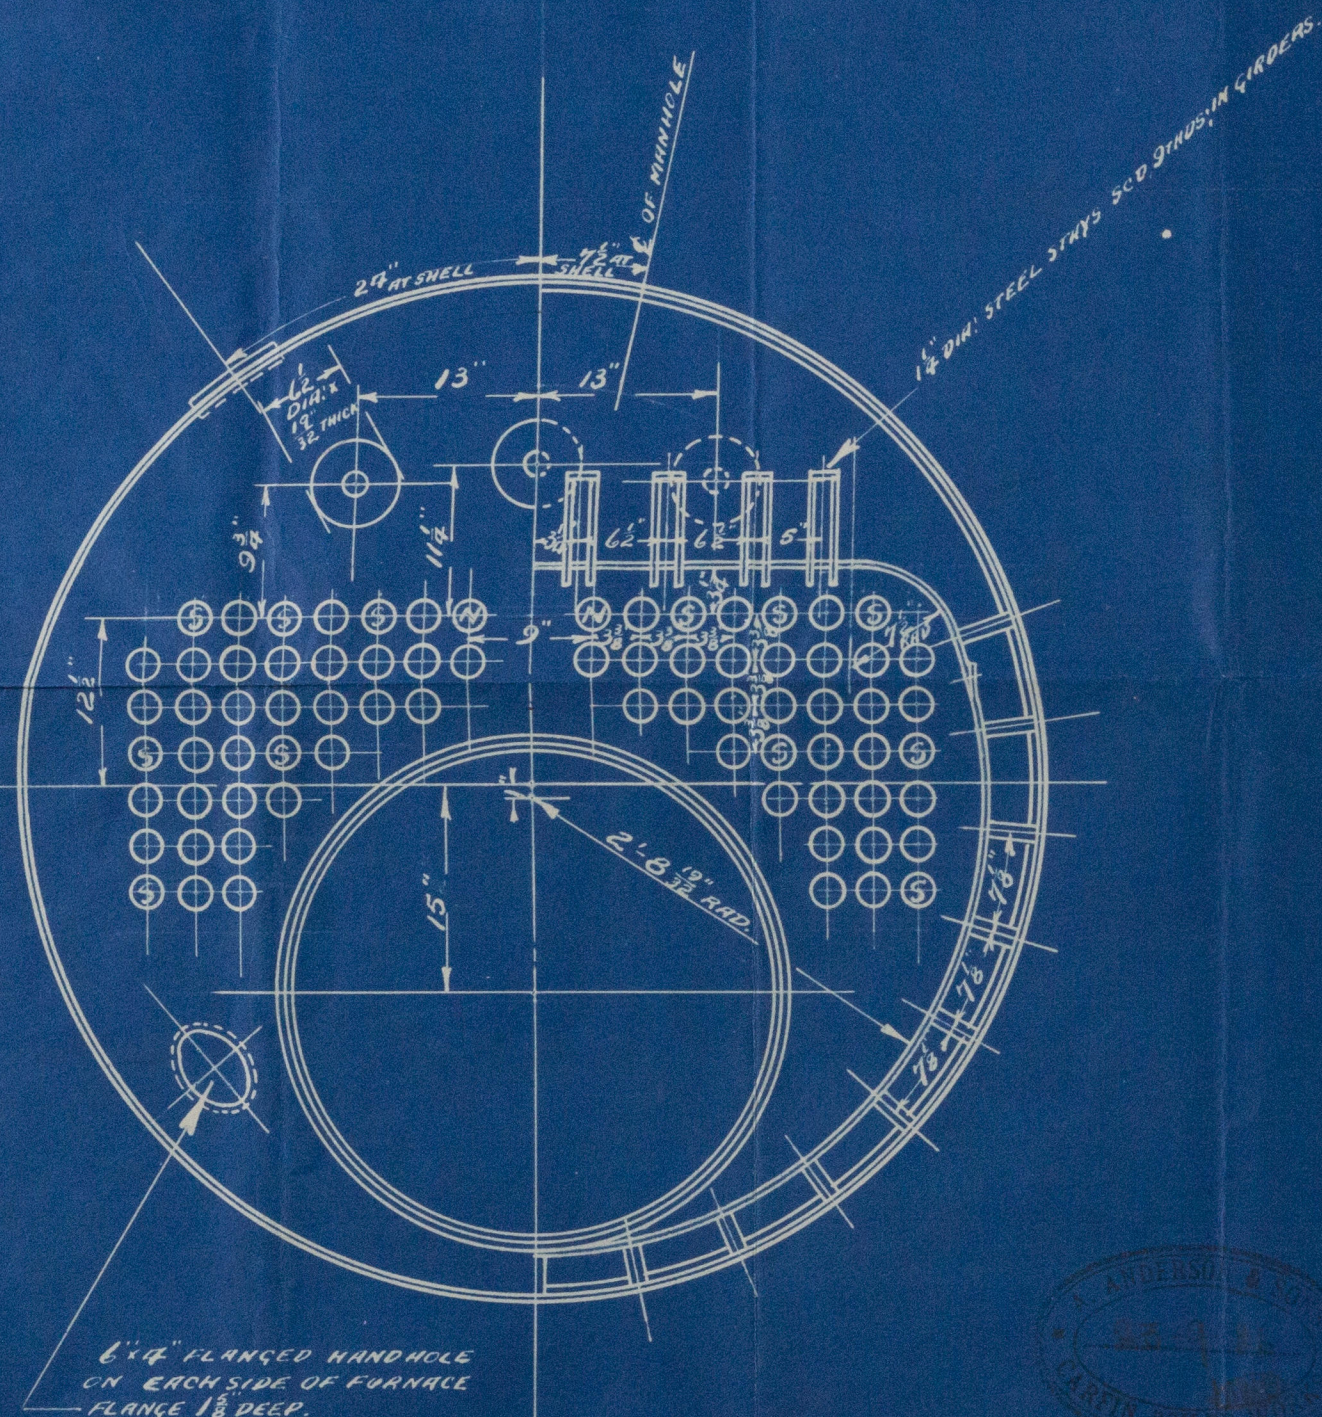
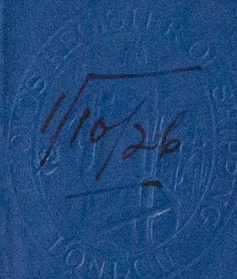


MARINE BOILER N° 2872.

BOILER ~~4'3"~~ DIA. OUTSIDE x 7'-6" LONG OVER ENDS x 120 LBS. PER Q" WORKING PRESSURE
TO LLOYDS SURVEY HYDRAULIC TEST PRESSURE 230 LBS. PER Q" SCALE 1/4" = 1 FOOT.

INTERNAL DIA ALTERED TO 4'3 3/8"

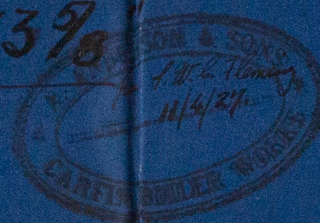

TOTAL HEATING SURFACE . . . 316 sq. ft.
FIREGRATE AREA WITH 4'3\"/>



RETAIN

ALEX ANDERSON & SONS

BOILER N° 2872

120 LBS/□

NO 14352
Lloyds List
230 lb
120 lb WP
23/3/27 H.P.

for McKend Baylin - Goran
E1185.

GLASGOW REPORT No.
46570

ST. SWAN

GLASGOW REPORT No.
46649

W1122-8161

