

MIDSHIP SECTION.

— OF A —

SINGLE DECKED STEEL SCREW STEAMERS

DIMENSIONS.

LENGTH AS PER RULE 322.0 (DEPTH M.L.P.) 24.1
BREADTH M.L.P. 46.10 CLASS 100-A.I.

THREE DECK RULE

SCALE 1/2 INCH = 1 FOOT.

Lloyd's Numbers

16.5.00 Half Girth 45.43
15.6.00 Half Breadth 23.415
18.6.00 Depth 25.04
Frame No 86.886
Length as per Rule 322.0
Plating No 27977.29


Equipment No 32083

1st Power Co Stock 36 1/2 cuts of steelless 45 1/2 cuts
2nd do do 36 1/2 do do 45 1/2 do
3rd do do 31 do do 39 do
Stream do do 11 1/2 do
Sledge do do 5 1/2 do
270 fms Stud chain 1 1/2 do
90 fms Stream chain 1 1/2 do or 4 1/4 Steel Wire

Hawsers & Harps

100 fms Sawline 12 or 14 Steel Wire
2-90 Hawsers 7
2-90 Harps 6

Depths in Length 12.83
Breadths do 6.88

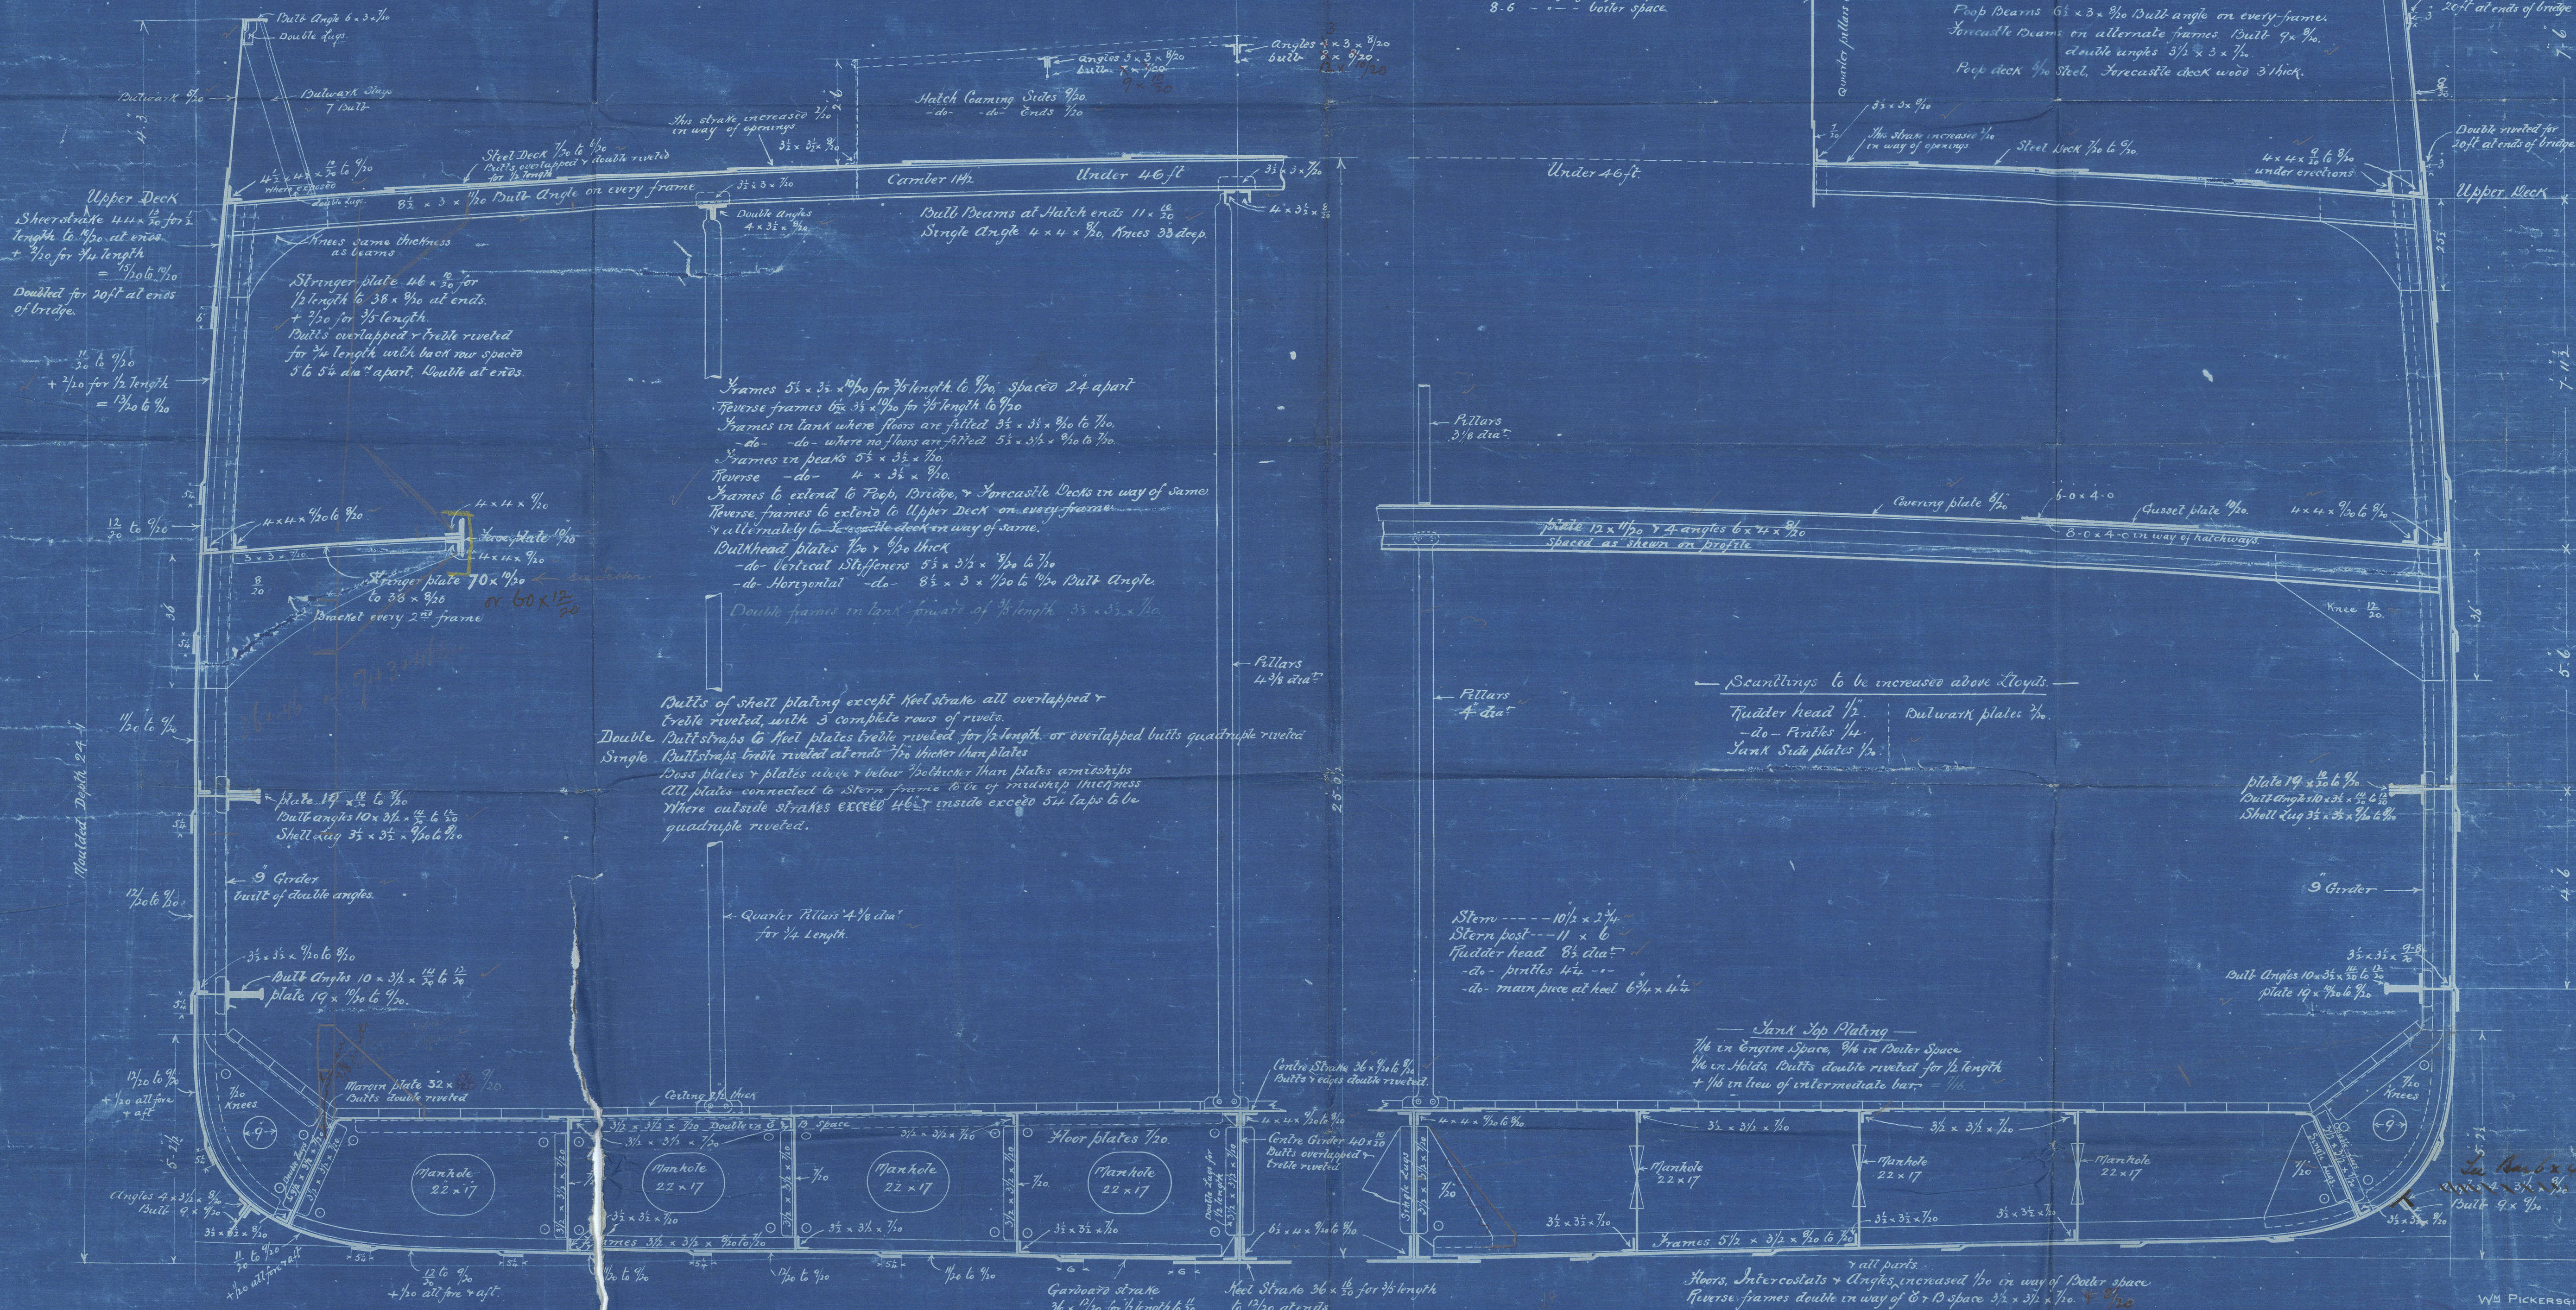

No 132

Bottom forward to be strengthened in accordance with Circular No 10 of 1902.

W. PICKERSGILL & SONS
SOUTHWICK
SUNDERLAND.

15/5/1900

W1122-0122



W Pickering & Sons

No 132

Midship Section

S.S. "Tonbridge"

Gunderland. N. 1897

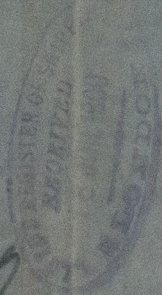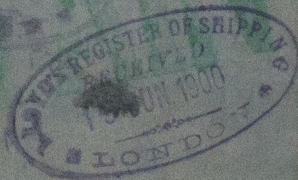

© 2020

Lloyd's Register
Foundation