* 53663

Propeller diam. ökad 4 tum
Det Norske Veritas d. 17/5-27

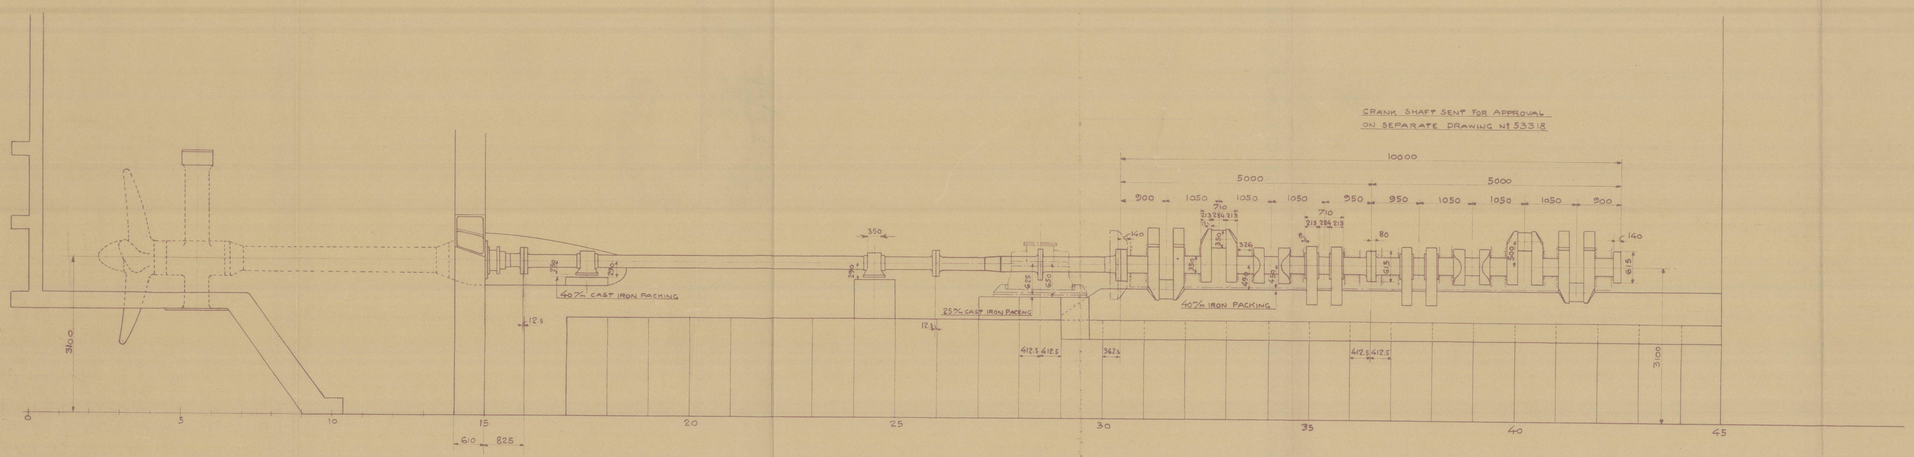

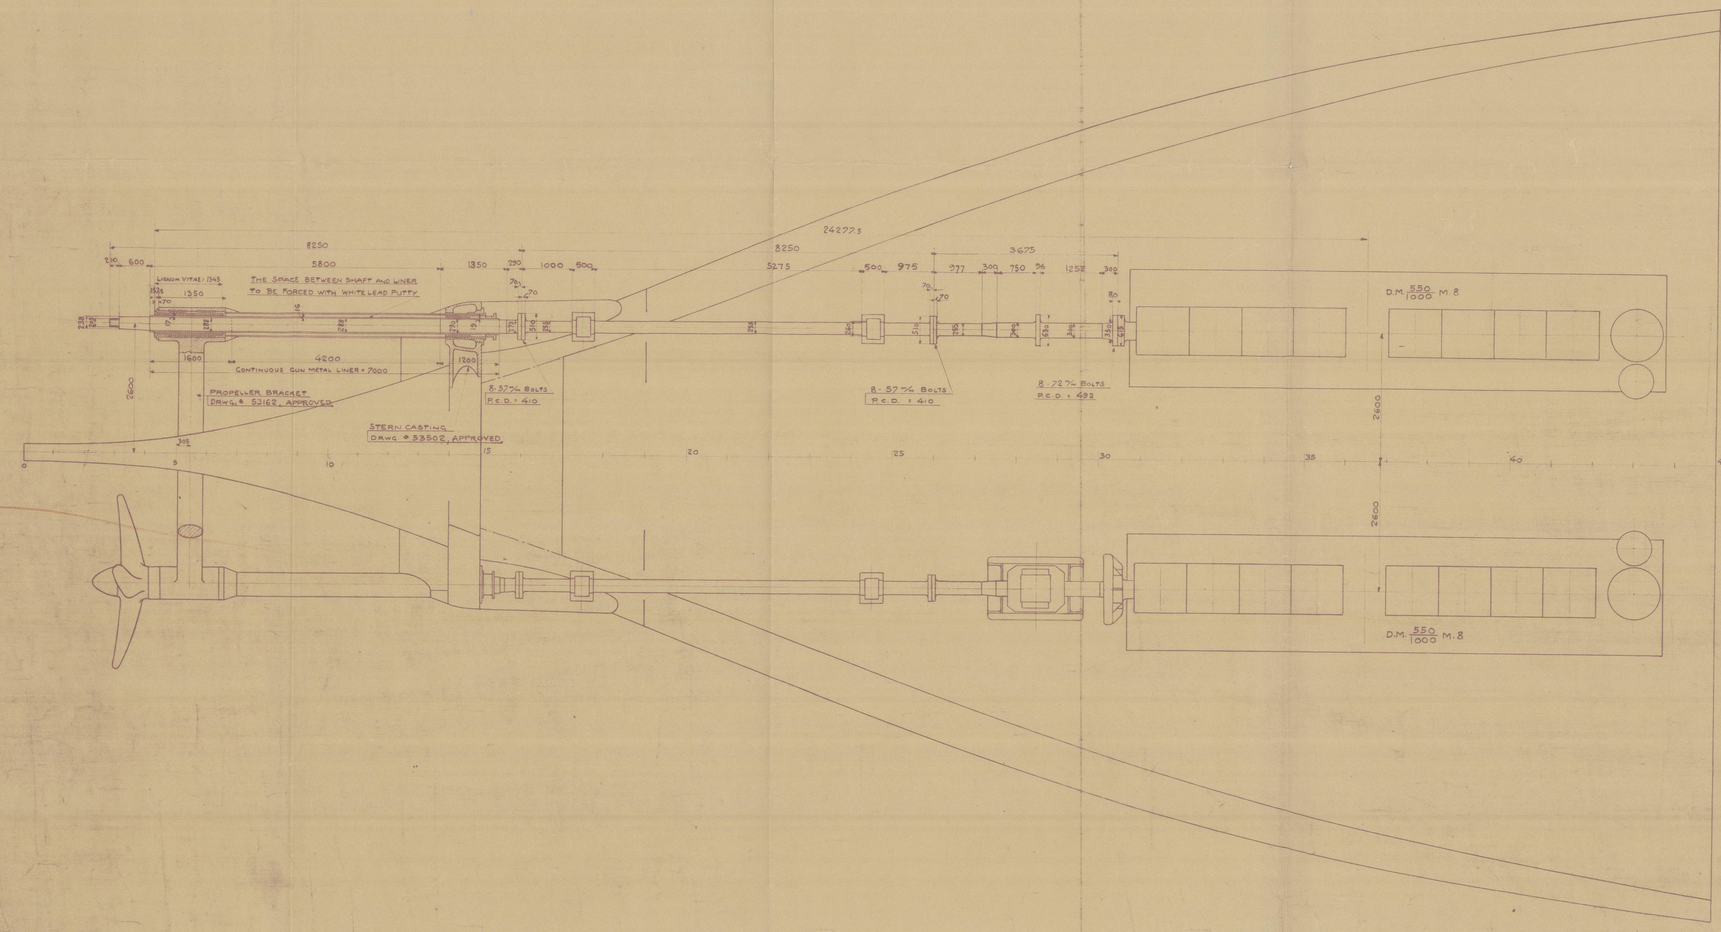

2 DIESEL MOTORS, FOUR CYCLE, SINGLE ACTING
WITH 8 CYLINDERS

DIAMETER OF CYLINDERS = 550 m/m
LENGTH OF STROKE = 1000
DIAMETER OF PROPELLERS = ~~3600~~ 3658
REVOLUTIONS PER MIN. = 135
W.D² OF 8 BALANCE WEIGHTS = 6600 KGMTR²
" " TURNING WHEEL " = 1000 "

JÄMFÖR FÖLJANDE RITNINGAR:

#54478	PROPELLER - MELLAN & TRYCKAXLAR
#54479	PROPELLERHYLSA
#43121	TRYCKLAGER (SAMMANST.)
#45115	BOTTENPLATTA FÖR Dt
#41752	BÄRLAGER
#	PROPELLER
#52027	SAXNINGSHJUL

Gol. Rpt. No 8324.

"Barform"
GEN. BOX NO. 729

AB. GÖTAVERKEN
M/S 443
SHAFTING - ARRANGEMENT

RITAD AV W.A. SKALA 1:50
KALK. AV
GRANSK. AV W.A. DATUM 2-5-27

LLOYD'S REGISTER 13.3.30 GOTHENBURG SHIPBUILDING DEPARTMENT

BEST. FÖR	BEST. NR	UTFÖRT DATUM	LEVER. DATUM	ANM.
M/S 443	53663	23/3 30	30-1-30	
M/S 443	53664	23/3 30	30-1-30	
M/S 443	53665	23/3 30	30-1-30	

* 53663
* 53664
* 53665
* 582831
W 1113 - 3231
Lloyd's Register Foundation