




as fitted

SURFACES		ONE BOILER
TUBES		1345 #
FIREBOX TOP AND SIDES		123
" BACK		61
" TUBEPLATE		40
FURNACES		131
TOTAL HEATING SURFACE		1700
GRATE AREA (8-6 BARS)		538
TUBE AREA		9.37
WATER AREA		130
STEAM SPACE		330
GRATE AREA : HEATING SURFACE		1:31.7
" : TUBE		1:25.1
" : WATER		576:1
" : STEAM SPACE		1:4.42
% BOILER ABOVE FIREBOX		29.7
WEIGHT OF WATER		20 TONS

RIVETING			
	LONGIT	BACK END	FRONT END
RIVET HOLE DIA	11/16	11/16	11/16
PITCH	9 1/16	8 3/8	8 1/2
% PLATE	85.8	64.1	61.6
% RIVET	87.4	47.5	48.4
% COMBINED	89		



LIMITS OF TENSILE STRENGTH & MATERIAL			
SHELL, BUTTSTRAPS AND GIRDERS	28 TO 30 TONS		
OTHER PLATES	26 " 30 "		
FURNACES	26 " 30 "		SIEMENS-MARTIN STEEL
MAIN STAYS	28 " 30 "		
SCREWED STAYS	26 " 30 "		
RIVET BARS	16 " 20 "		

BACK END CIRCUM 134 PITCHES OF 3.83"

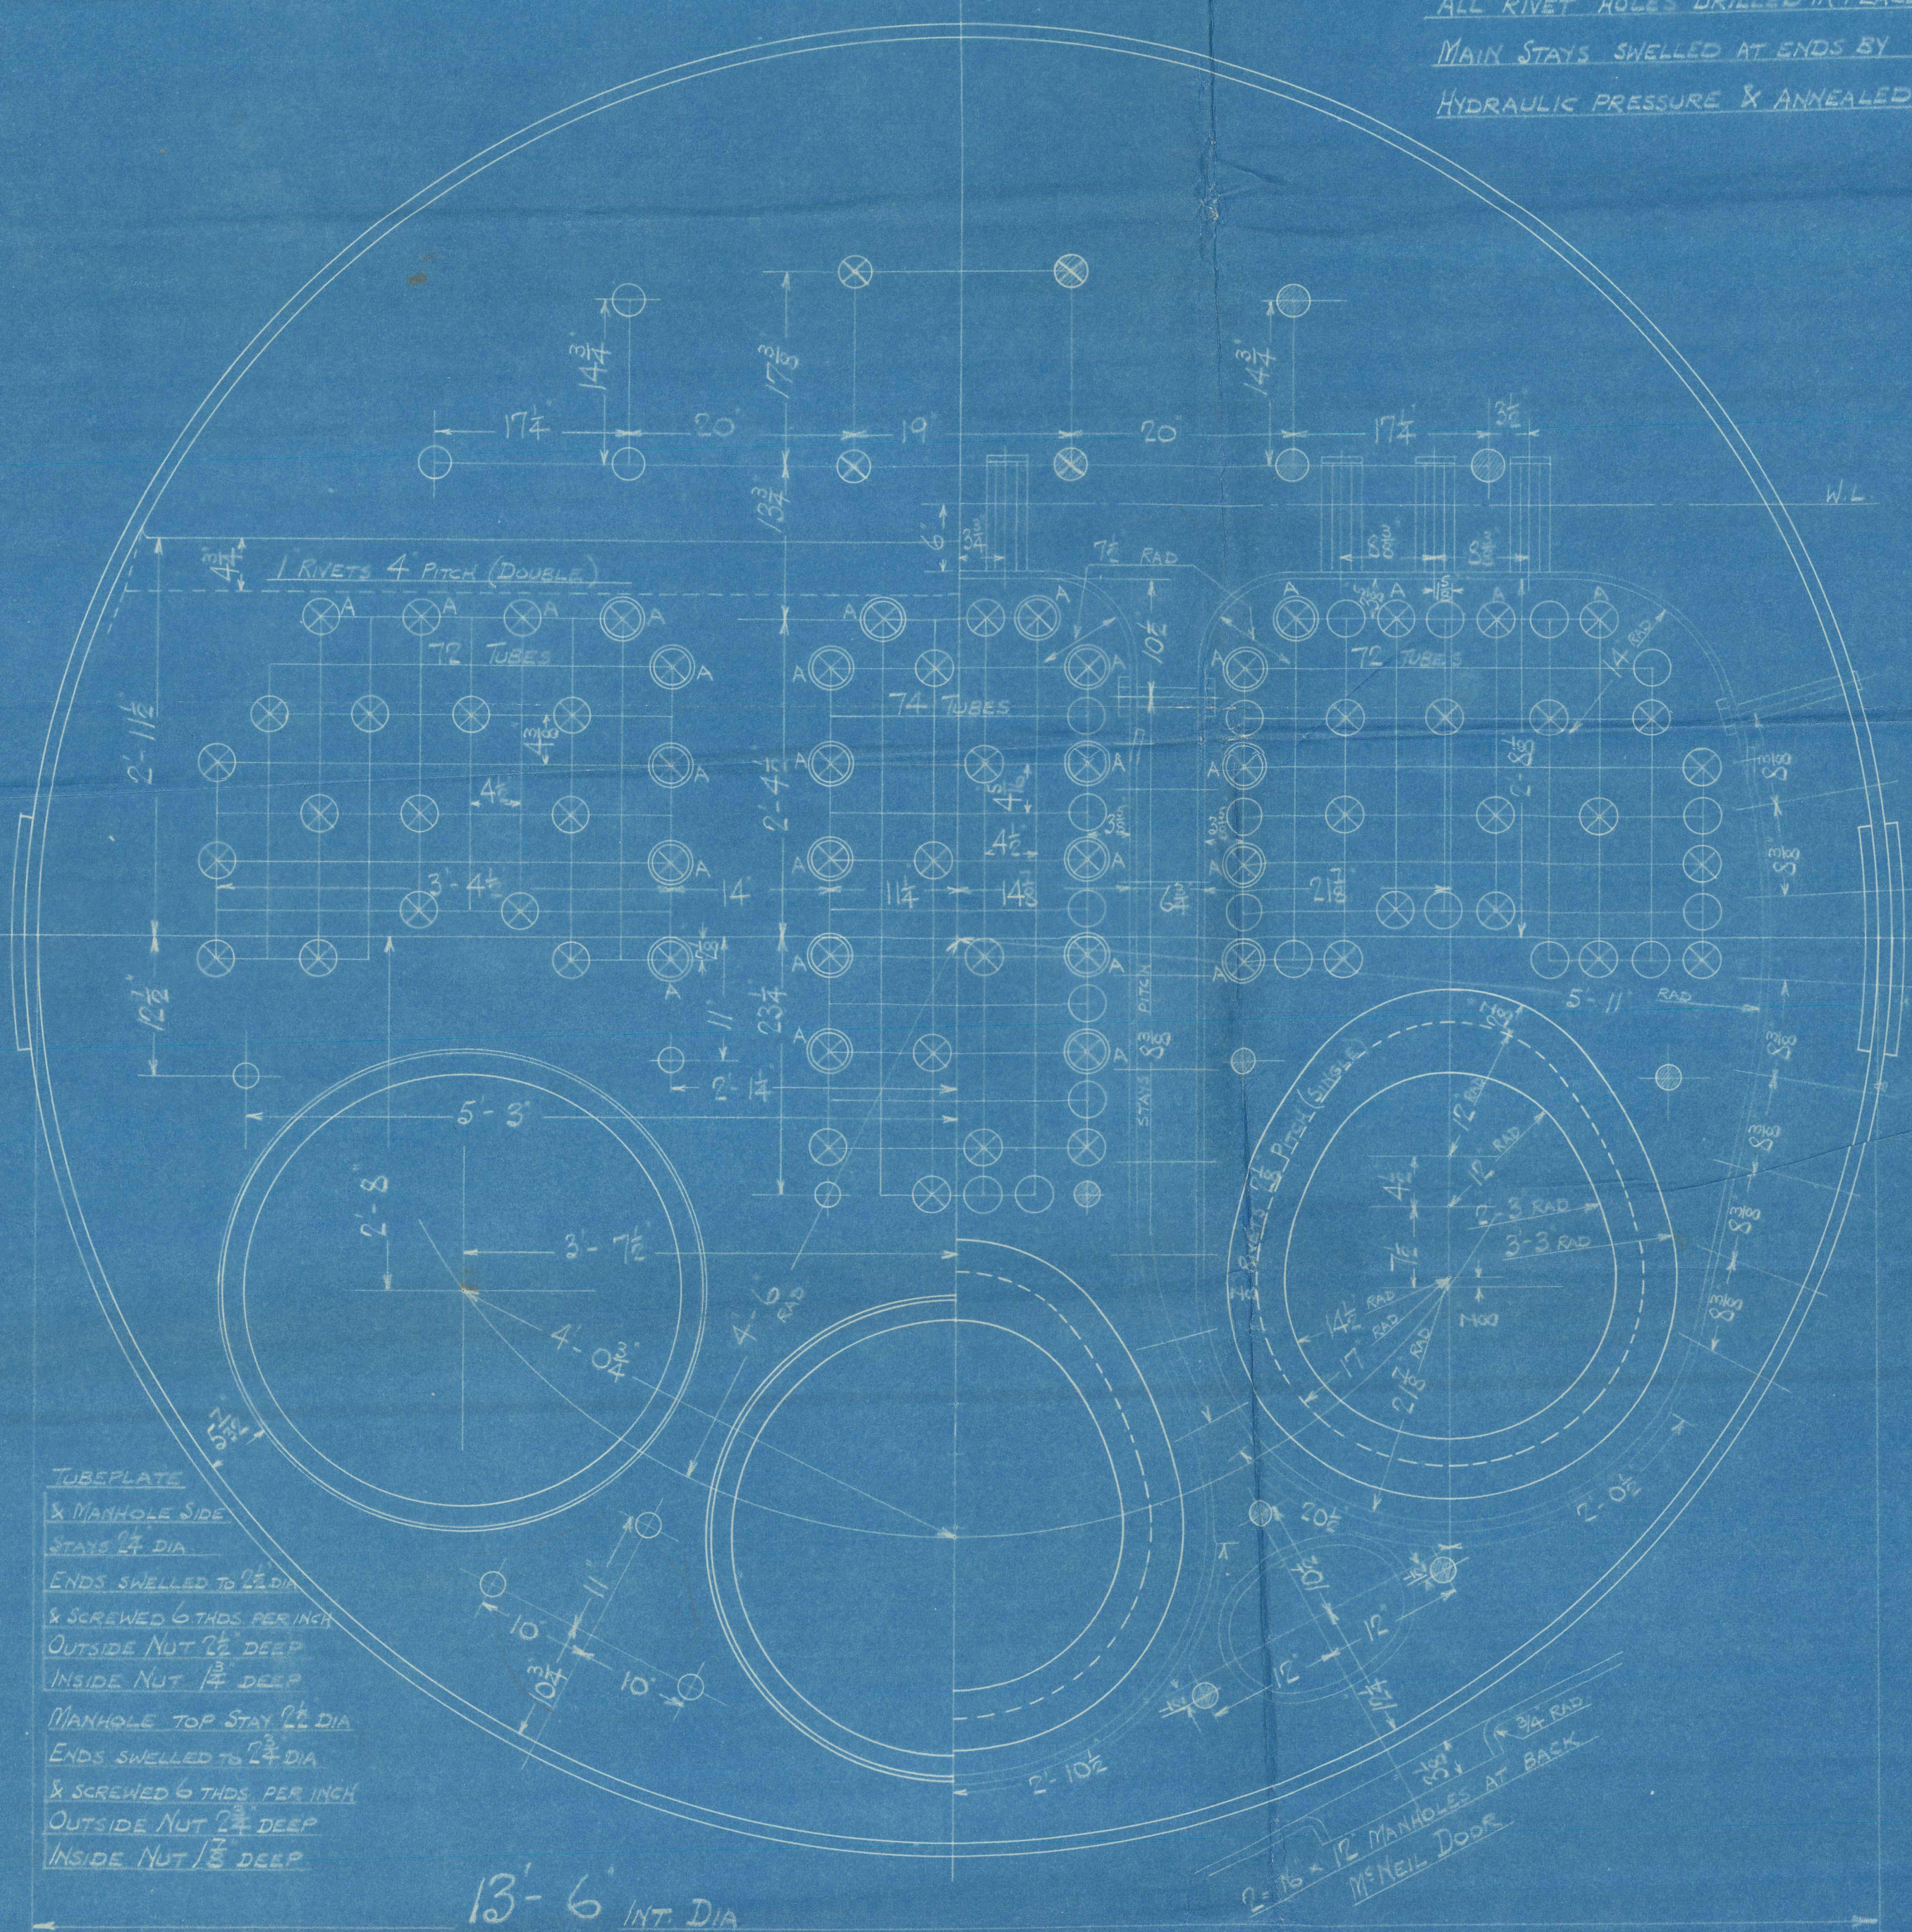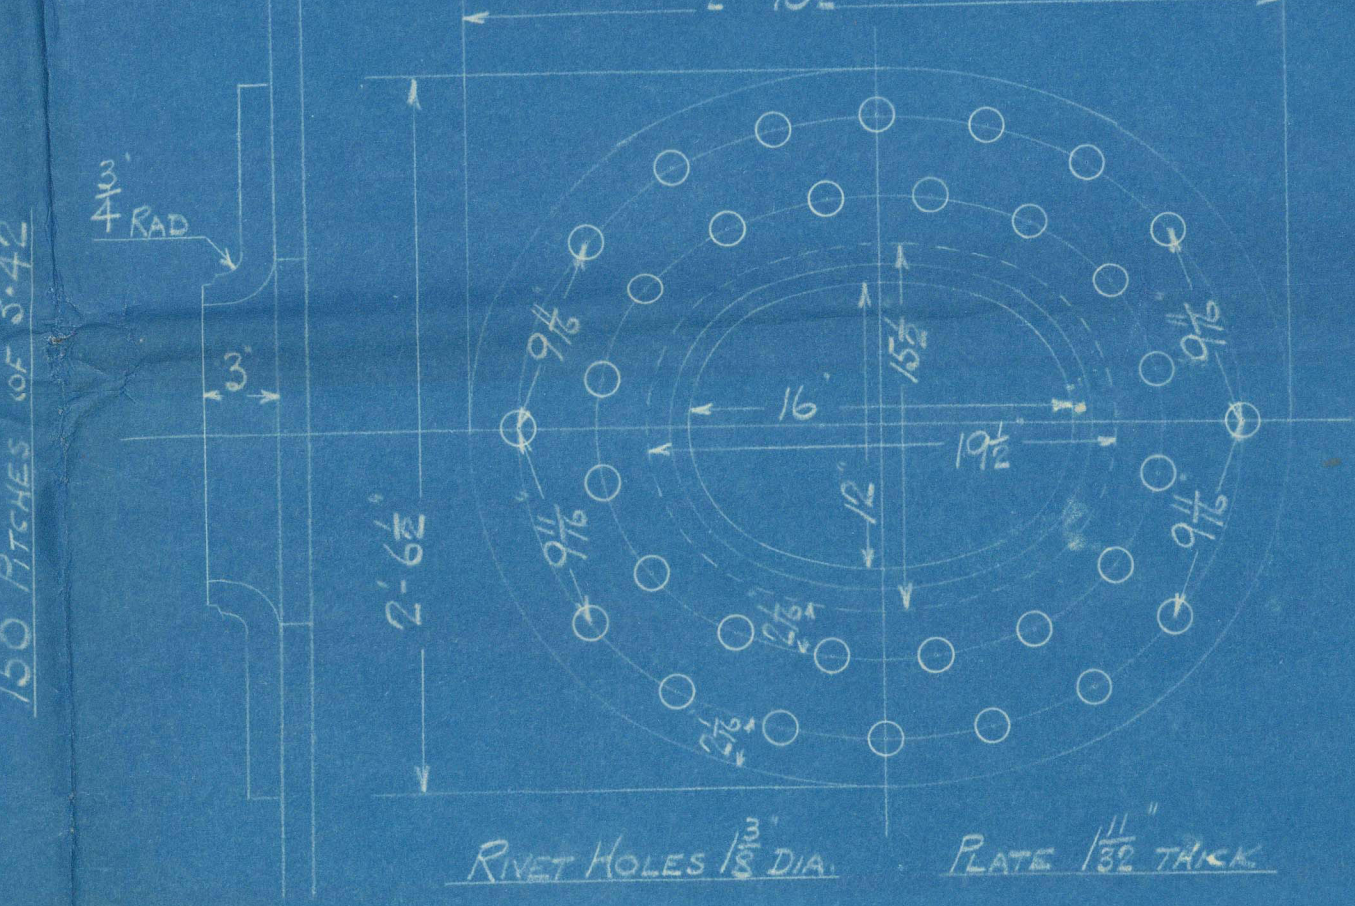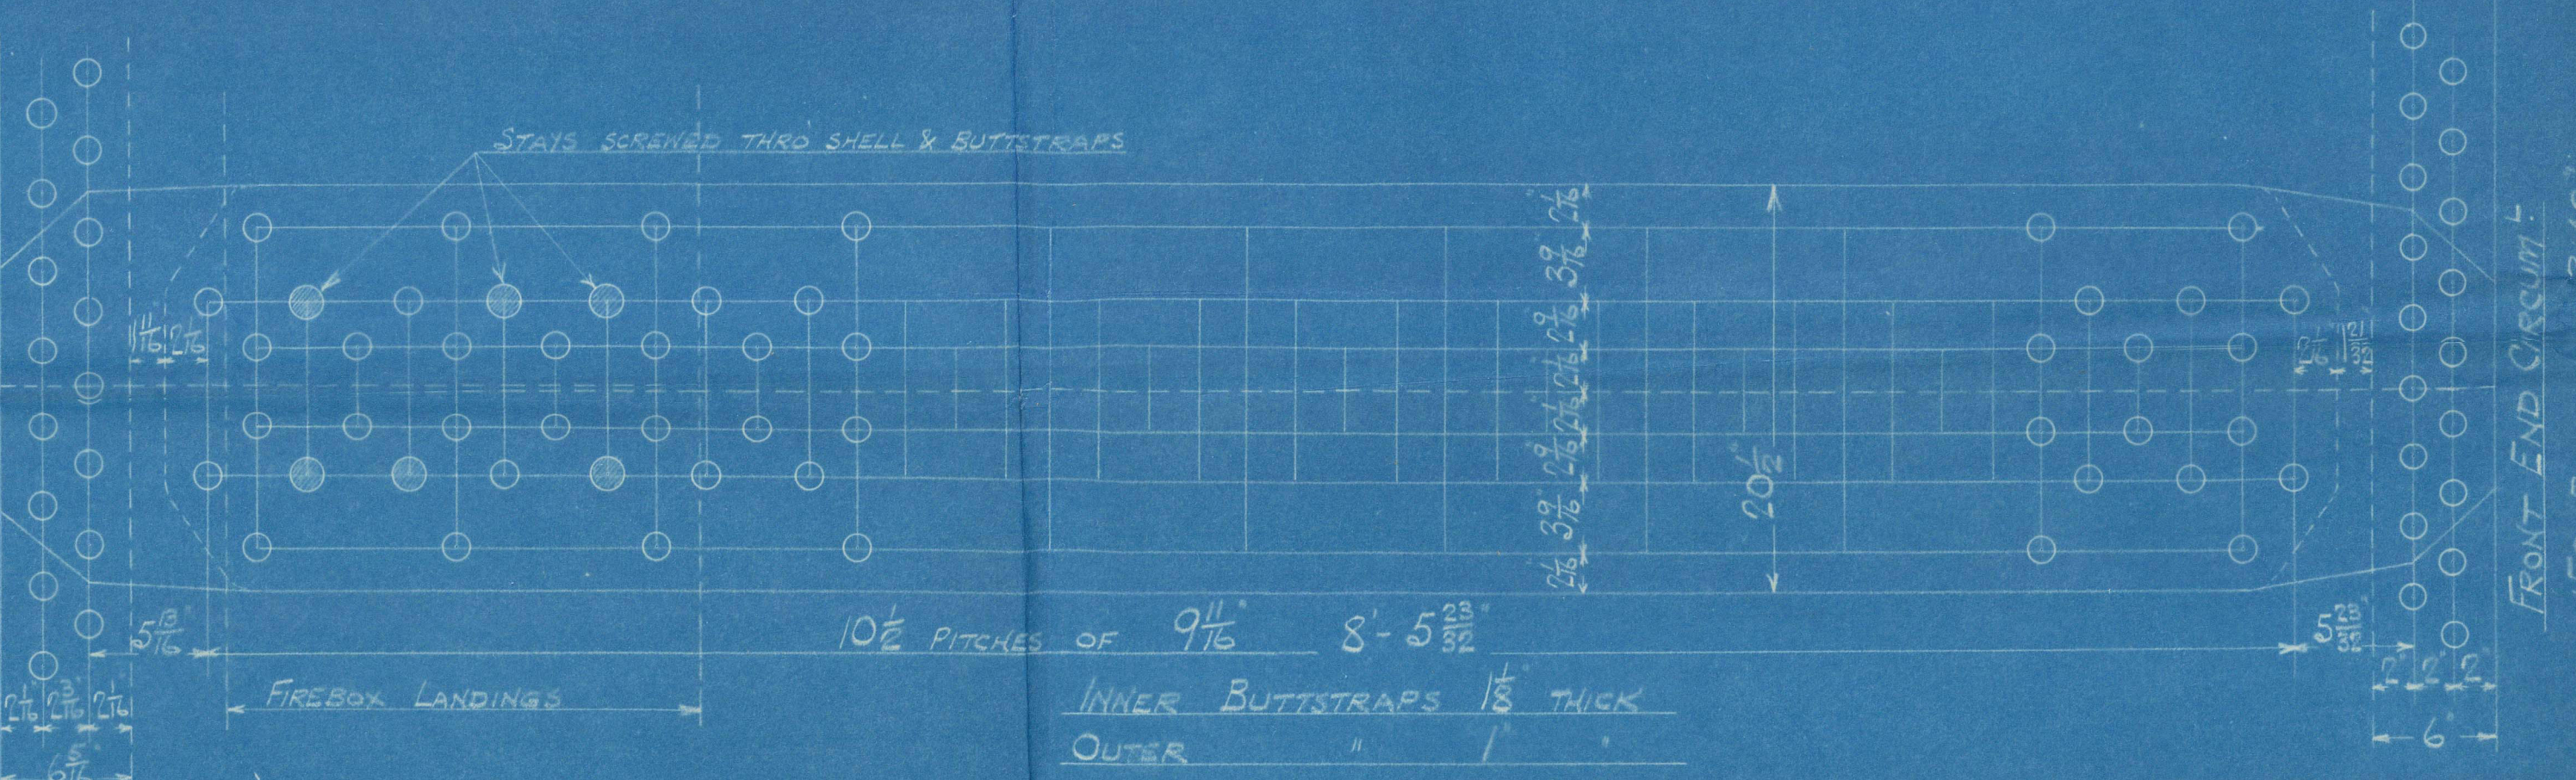

TUBEPLATE & MANHOLE SIDE STAYS 1/2" DIA
ENDS SHELLED TO 1/2" DIA
& SCREWED 5 THDS PER INCH
OUTSIDE NUT 1/2" DEEP
INSIDE NUT 1/2" DEEP
MANHOLE TOP STAY 1/2" DIA
ENDS SHELLED TO 1/2" DIA
& SCREWED 5 THDS PER INCH
OUTSIDE NUT 1/2" DEEP
INSIDE NUT 1/2" DEEP

ALL RIVET HOLES DRILLED IN PLACE
MAIN STAYS SHELLED AT ENDS BY
HYDRAULIC PRESSURE & ANNEALED

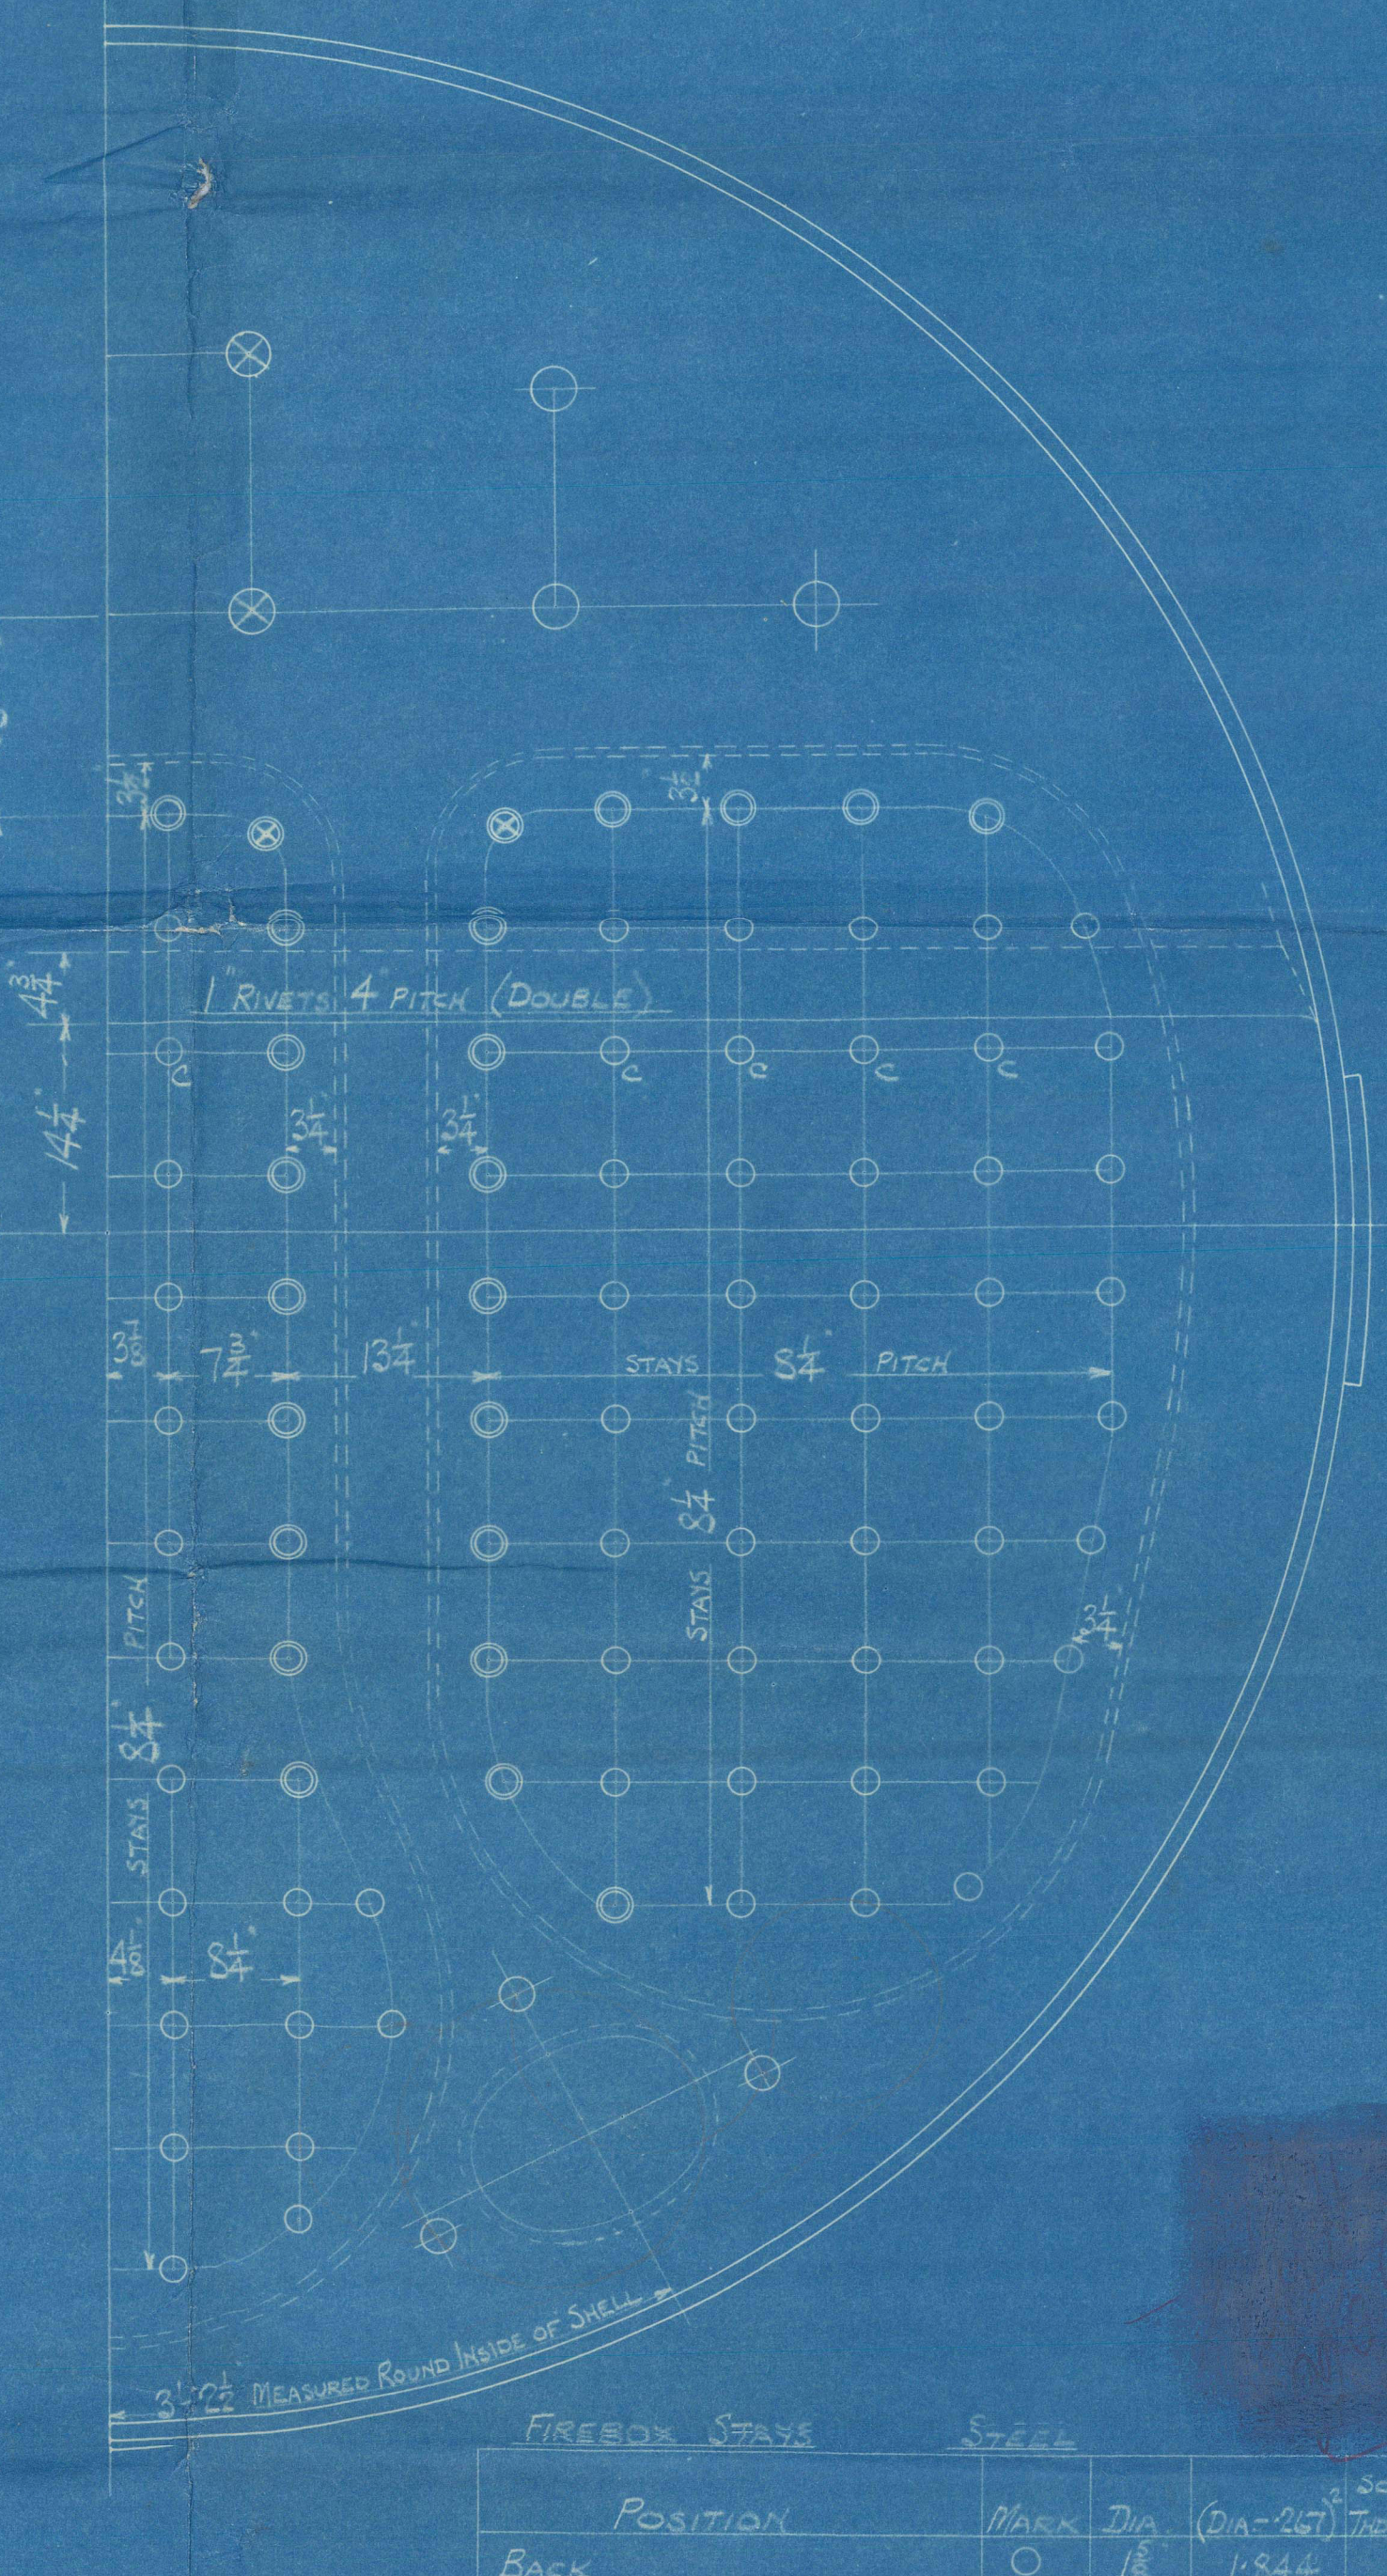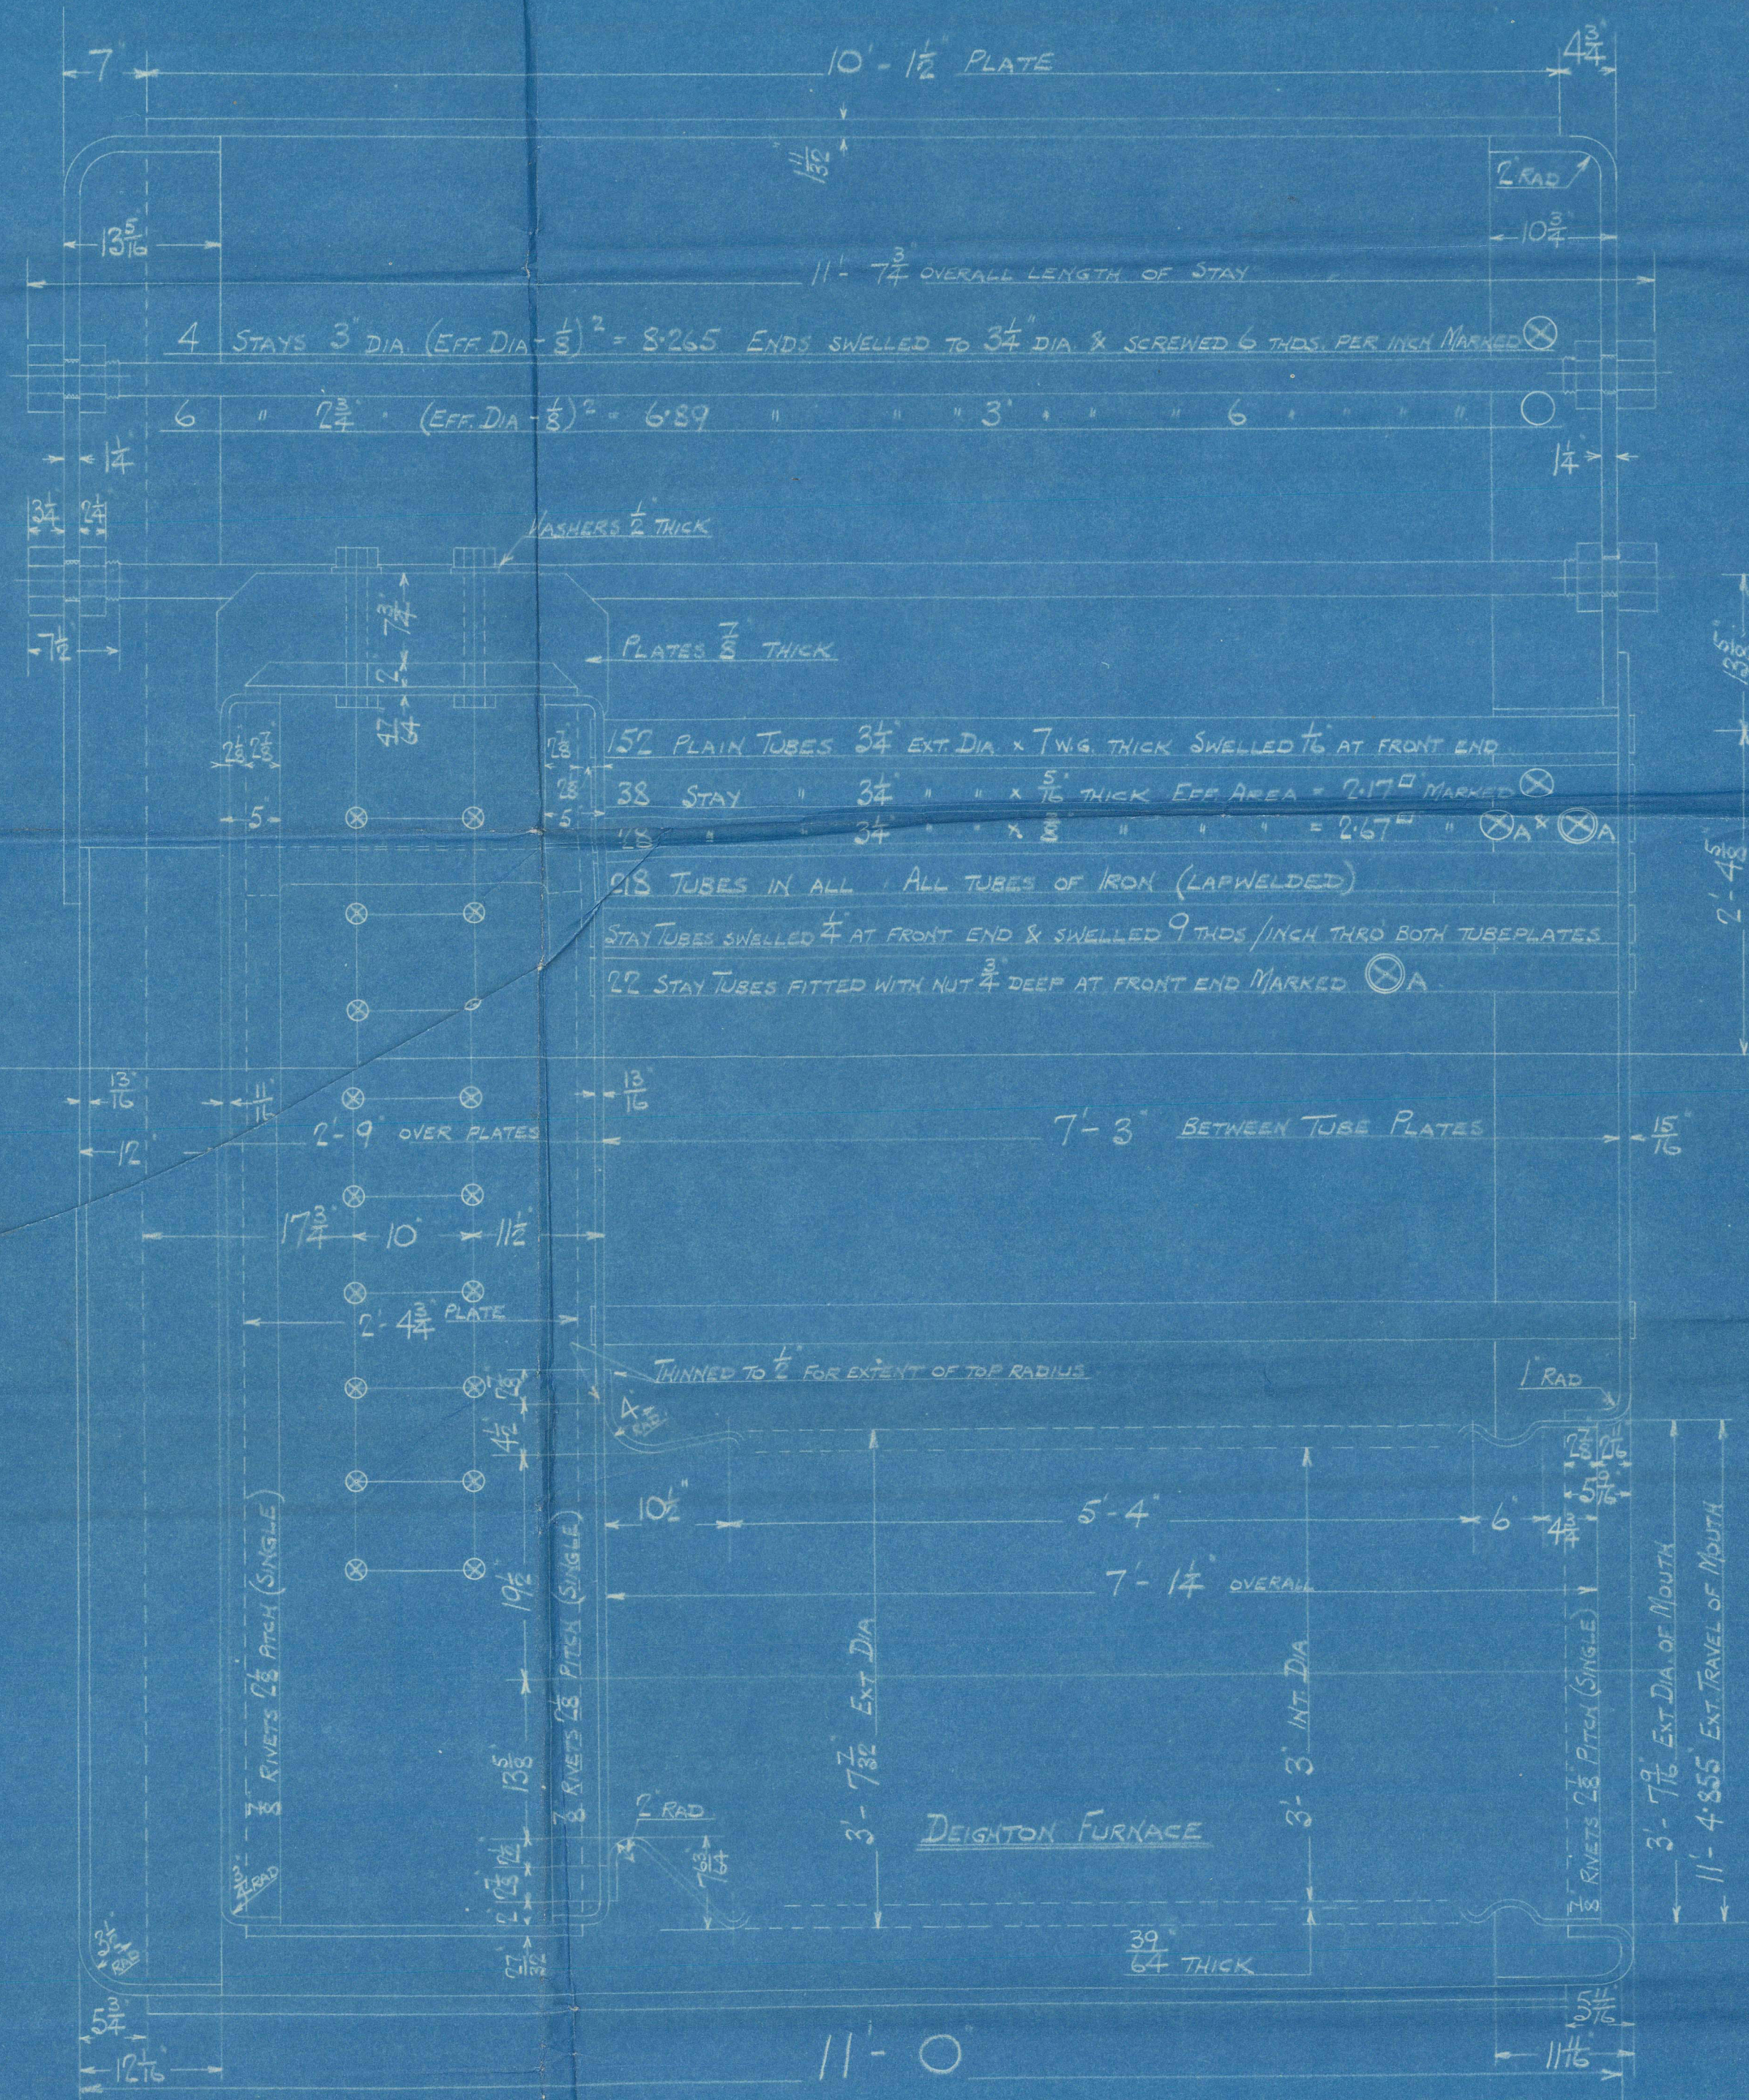


AUXILIARY BOILER ONE OFF CONT. NO 848

WORKING PRESSURE 220 LBS. PER SQUARE INCH
TEST " 380 " " "
TO PASS LLOYDS SURVEY
SCALE 1" = 1/2" ONE FOOT

FIREBOX STAYS		STEEL	
POSITION	MARK	DIA	SCREWED (DIA-26) THDS/INCH
BACK	○	1 1/8	1-844
TOP & SIDES	⊗	1 1/8	2-194
BACK WIDE SPACE & TOP ROW	⊗	1 1/8	2-585
" TOP CORNER	⊗	1 1/8	3-932

ALL FIREBOX STAYS SCREWED THRO BOTH PLATES AND NOT FITTED AT EACH END EXCEPT STAYS FROM WING FIREBOX TO SHELL AND STAYS MARKED C IN BACK BOTTOM END WHICH PROJECT 3" AND ARE CHALKED
ALL 1 1/8" NUTS 1/2" DEEP EXCEPT ON GIRDER TOPS WHERE THE OUTSIDE NUTS ARE 1 1/2" DEEP
ALL 1 1/8" NUTS 1" DEEP & 3/4" NUTS 1/2" DEEP

O.T 3/882A

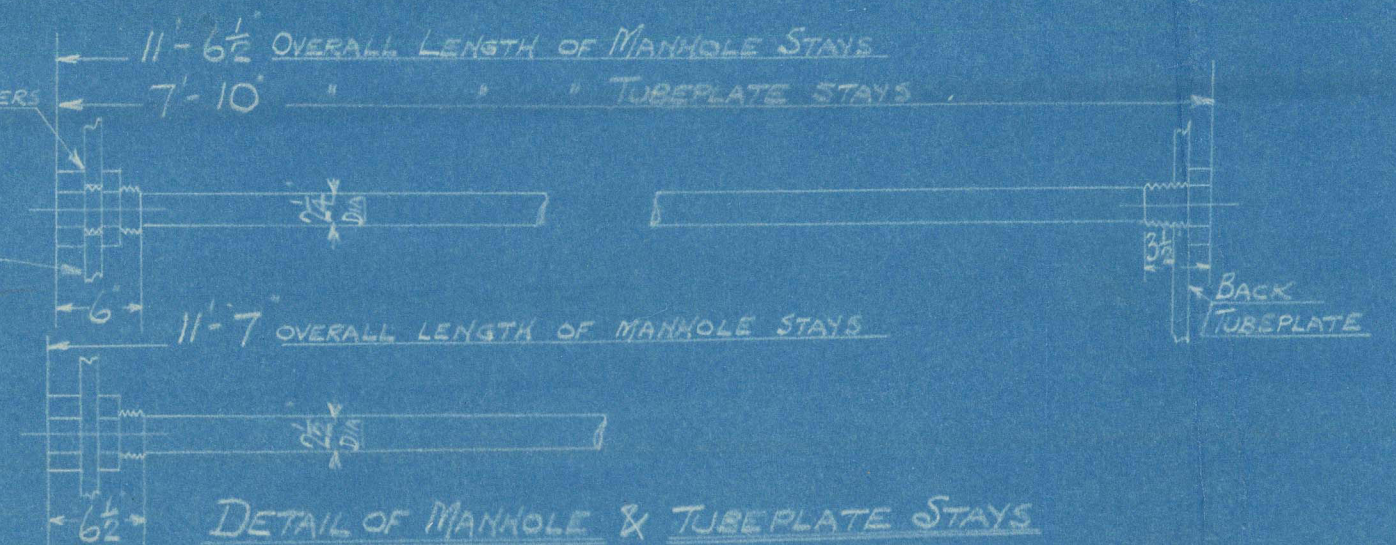

From DAVID ROWAN & CO., GLASGOW
ENCLOSURE
FOR MESSRS.
Lloyd's

SURFACES	ONE BOILER
TUBES	1345 #
FIREBOX TOP AND SIDES	123 "
" BACK	61 "
" TUBEPLATE	40 "
FURNACES	131 "
TOTAL HEATING SURFACE	1700 #
GRATE AREA (6-6 BARS)	538 "
TUBE AREA	9.37 "
WATER AREA	130 "
STEAM SPACE	33.0 #
GRATE AREA : HEATING SURFACE	1 : 31.7
" : TUBE	1 : 25.1
" : WATER	5.72 :
" : STEAM SPACE	1 : 2.42
% BOILER ABOVE FIREBOX	29.7
WEIGHT OF WATER	20 TONS

-- RIVETING --


	LONG	BACK END CIRC	FRONT END CIRC
RIVET HOLE DIA	18	18	18
PITCH	9 1/2	3.83	3.42
% PLATE	85.8	64.1	61.6
% RIVET	87.4	47.5	48.4
% COMBINED	89.		

LIMITS OF TENSILE STRENGTH & MATERIAL


SHELL, BUTTSTRAPS AND GIRDERS	28 TO 32 TONS	
OTHER PLATES	26 " 30 "	
FURNACES	26 " 30 "	
MAIN STAYS	28 " 30 "	
SCREWED STAYS	26 " 30 "	
RIVET BARS	26 " 30 "	

SIEMENS-MARTIN STEEL

BACK END CIRCUM 134
PITCHES OF 3.42



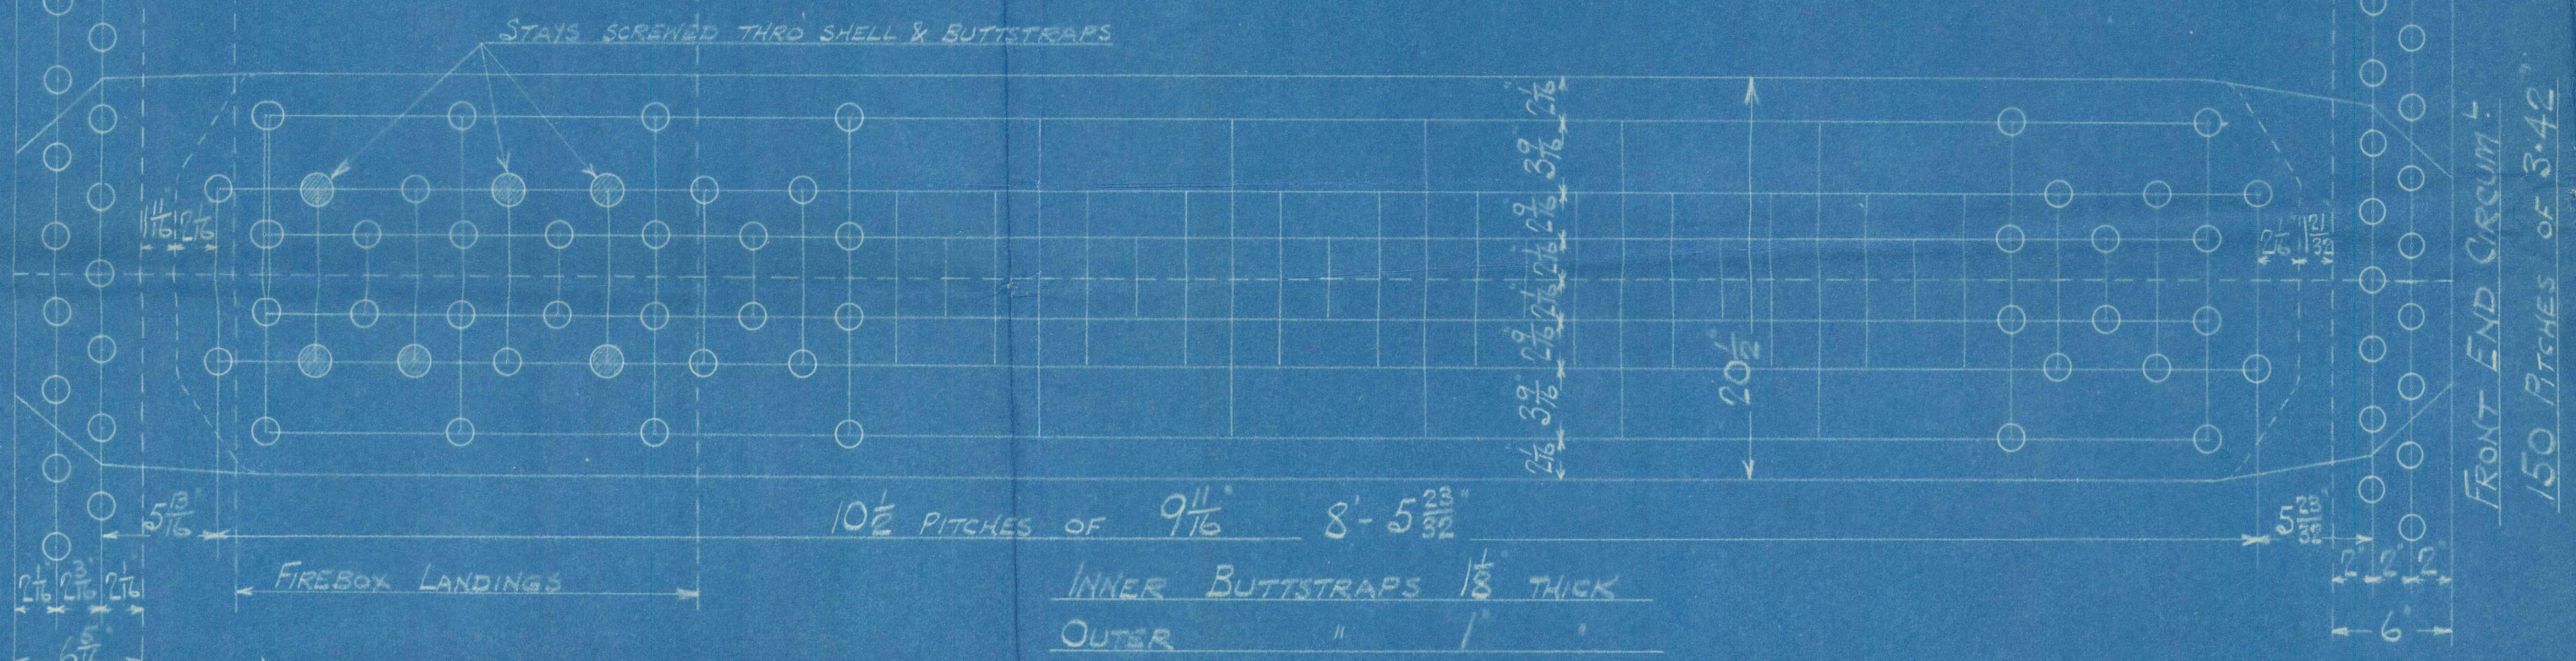


FRONT END CIRCUM 150
PITCHES OF 3.42

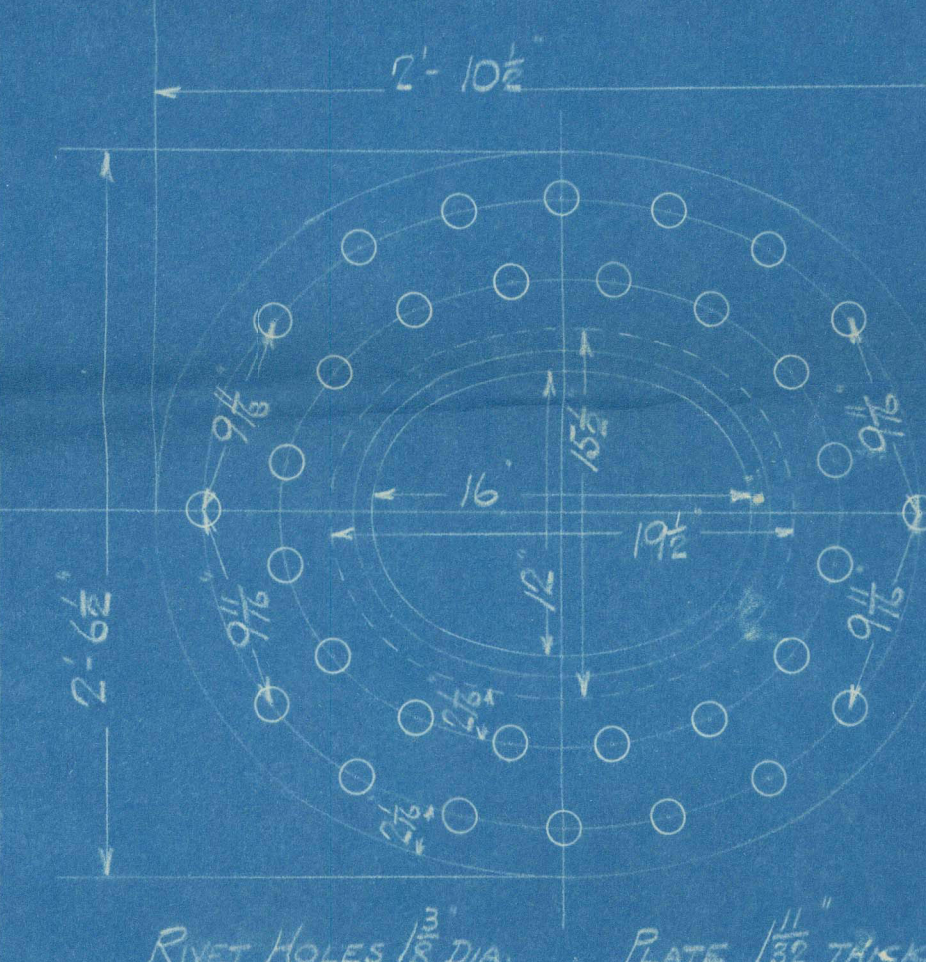

SHELL MANHOLE COMPENSATING RING
MCNEIL DOOR

ALL RIVET HOLES DRILLED IN PLACE
MAIN STAYS SWELED AT ENDS BY
HYDRAULIC PRESSURE & ANNEALED.

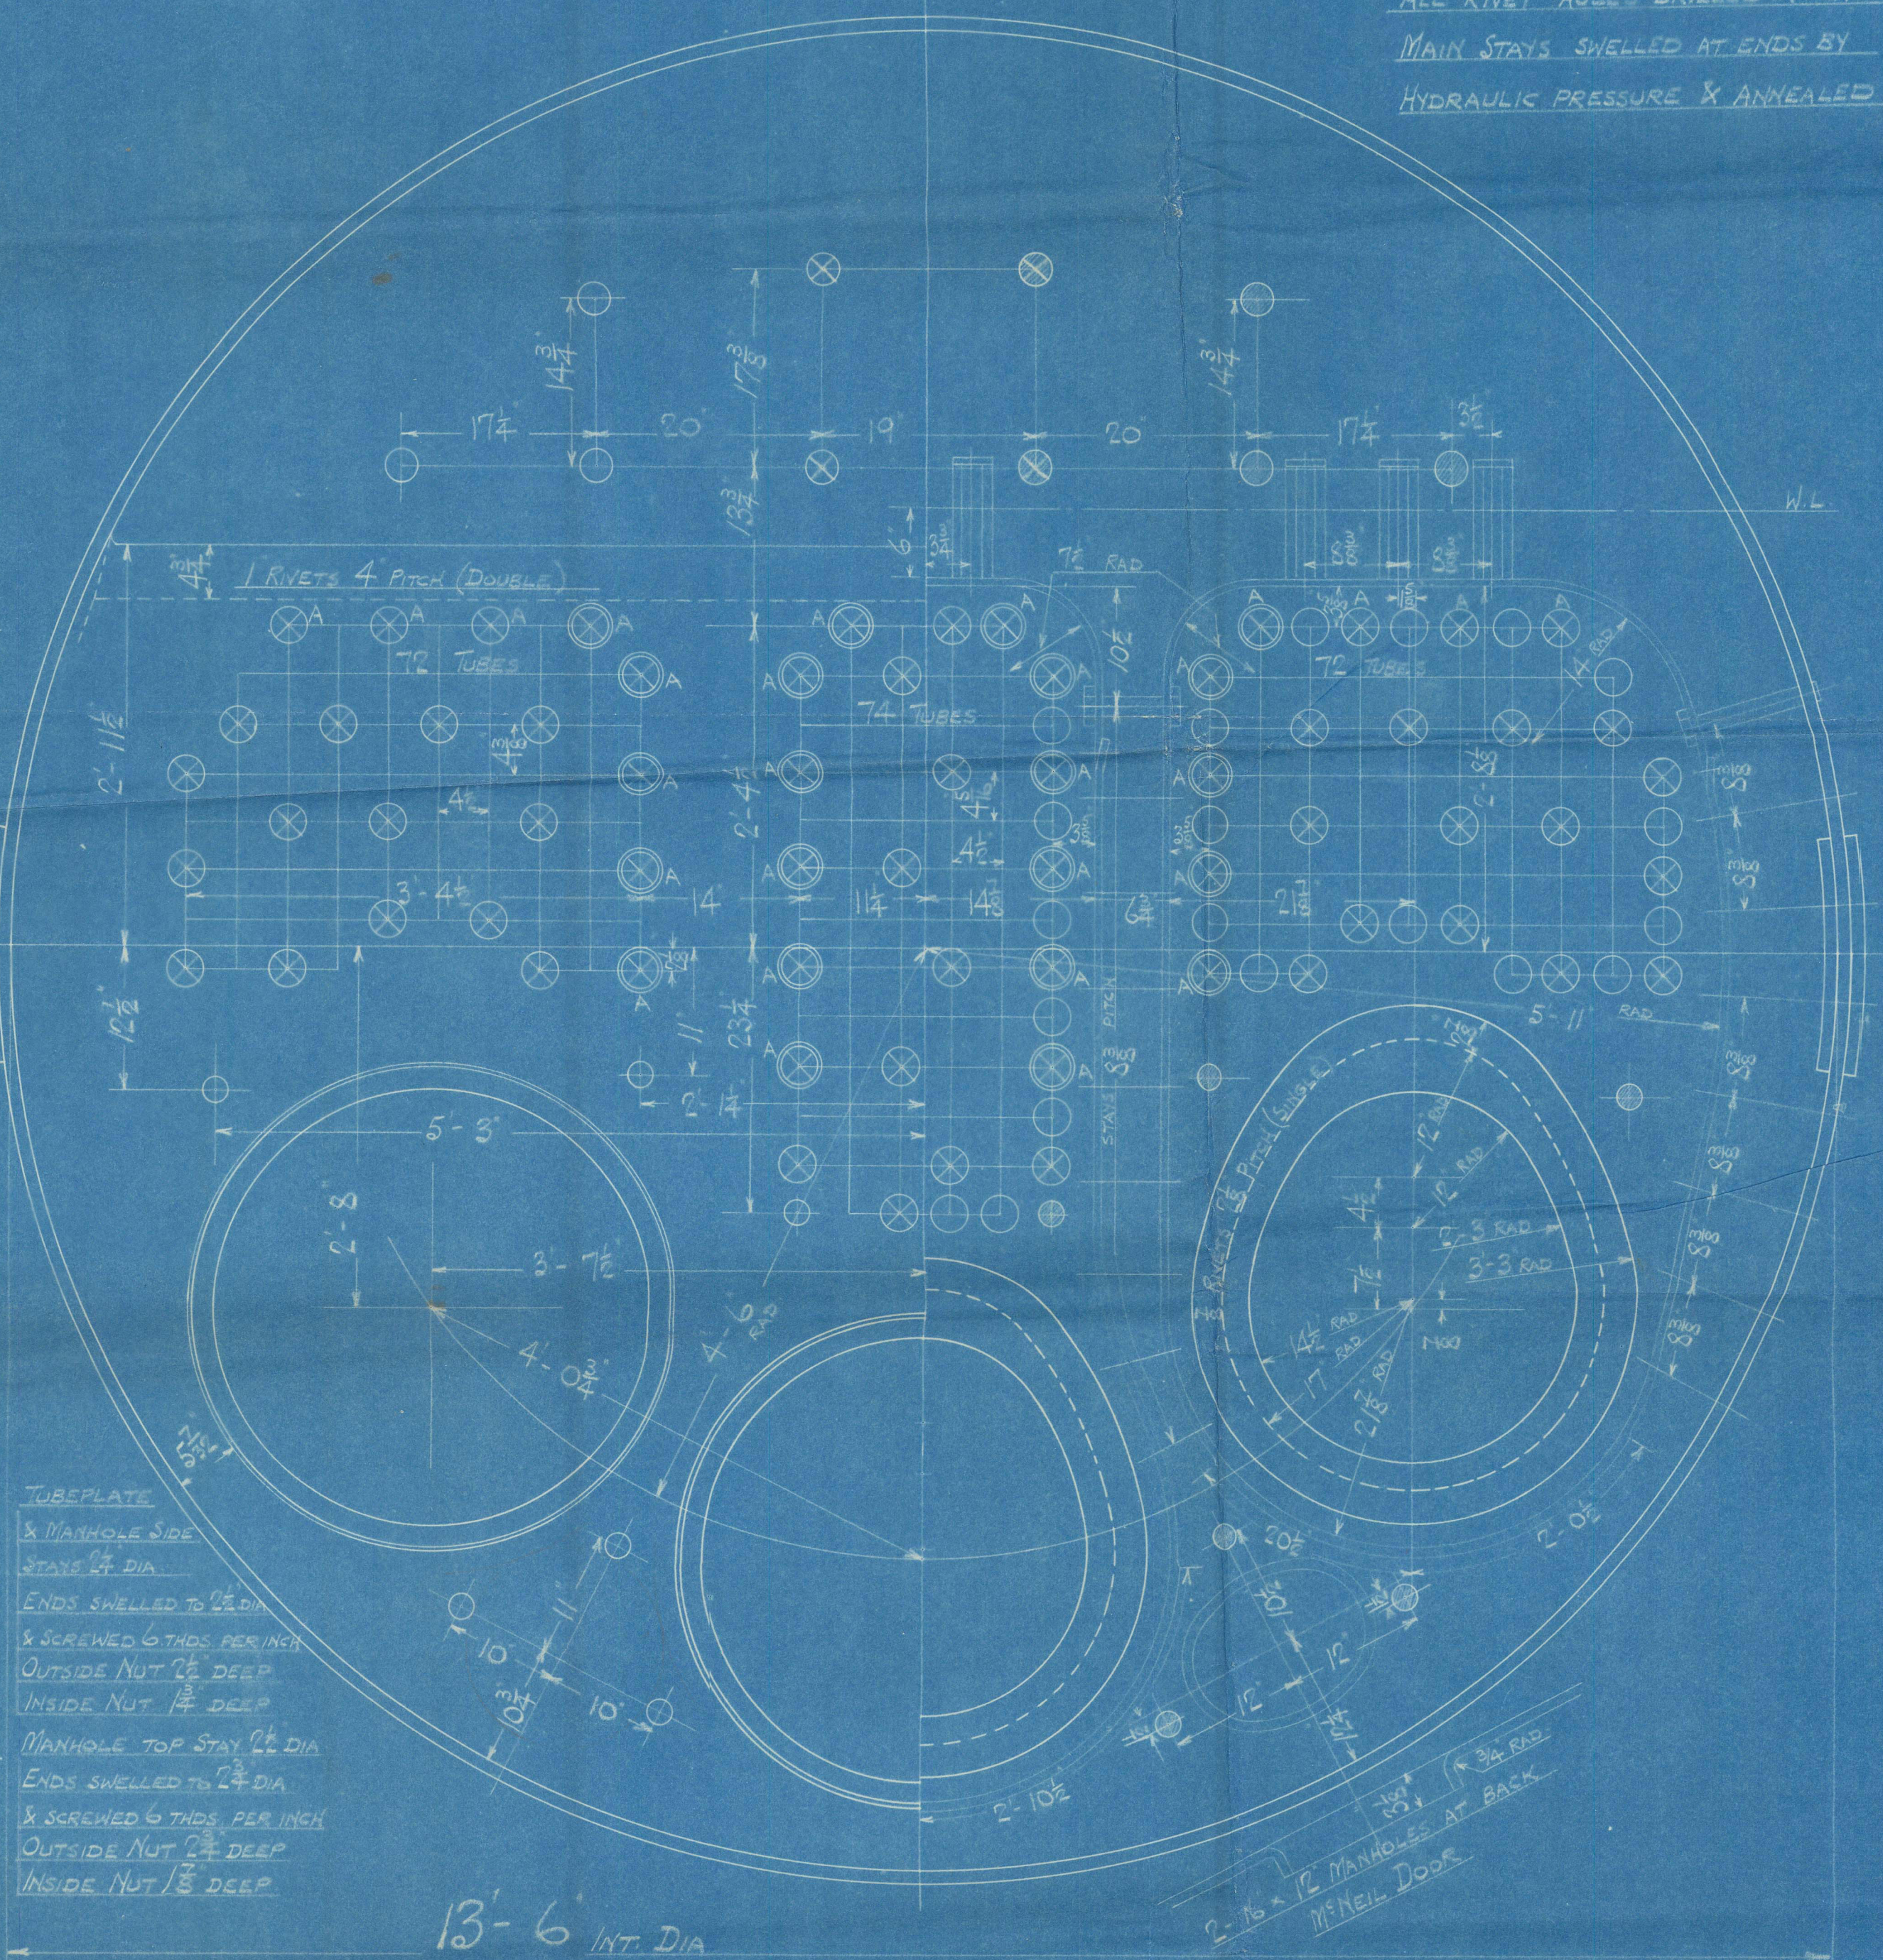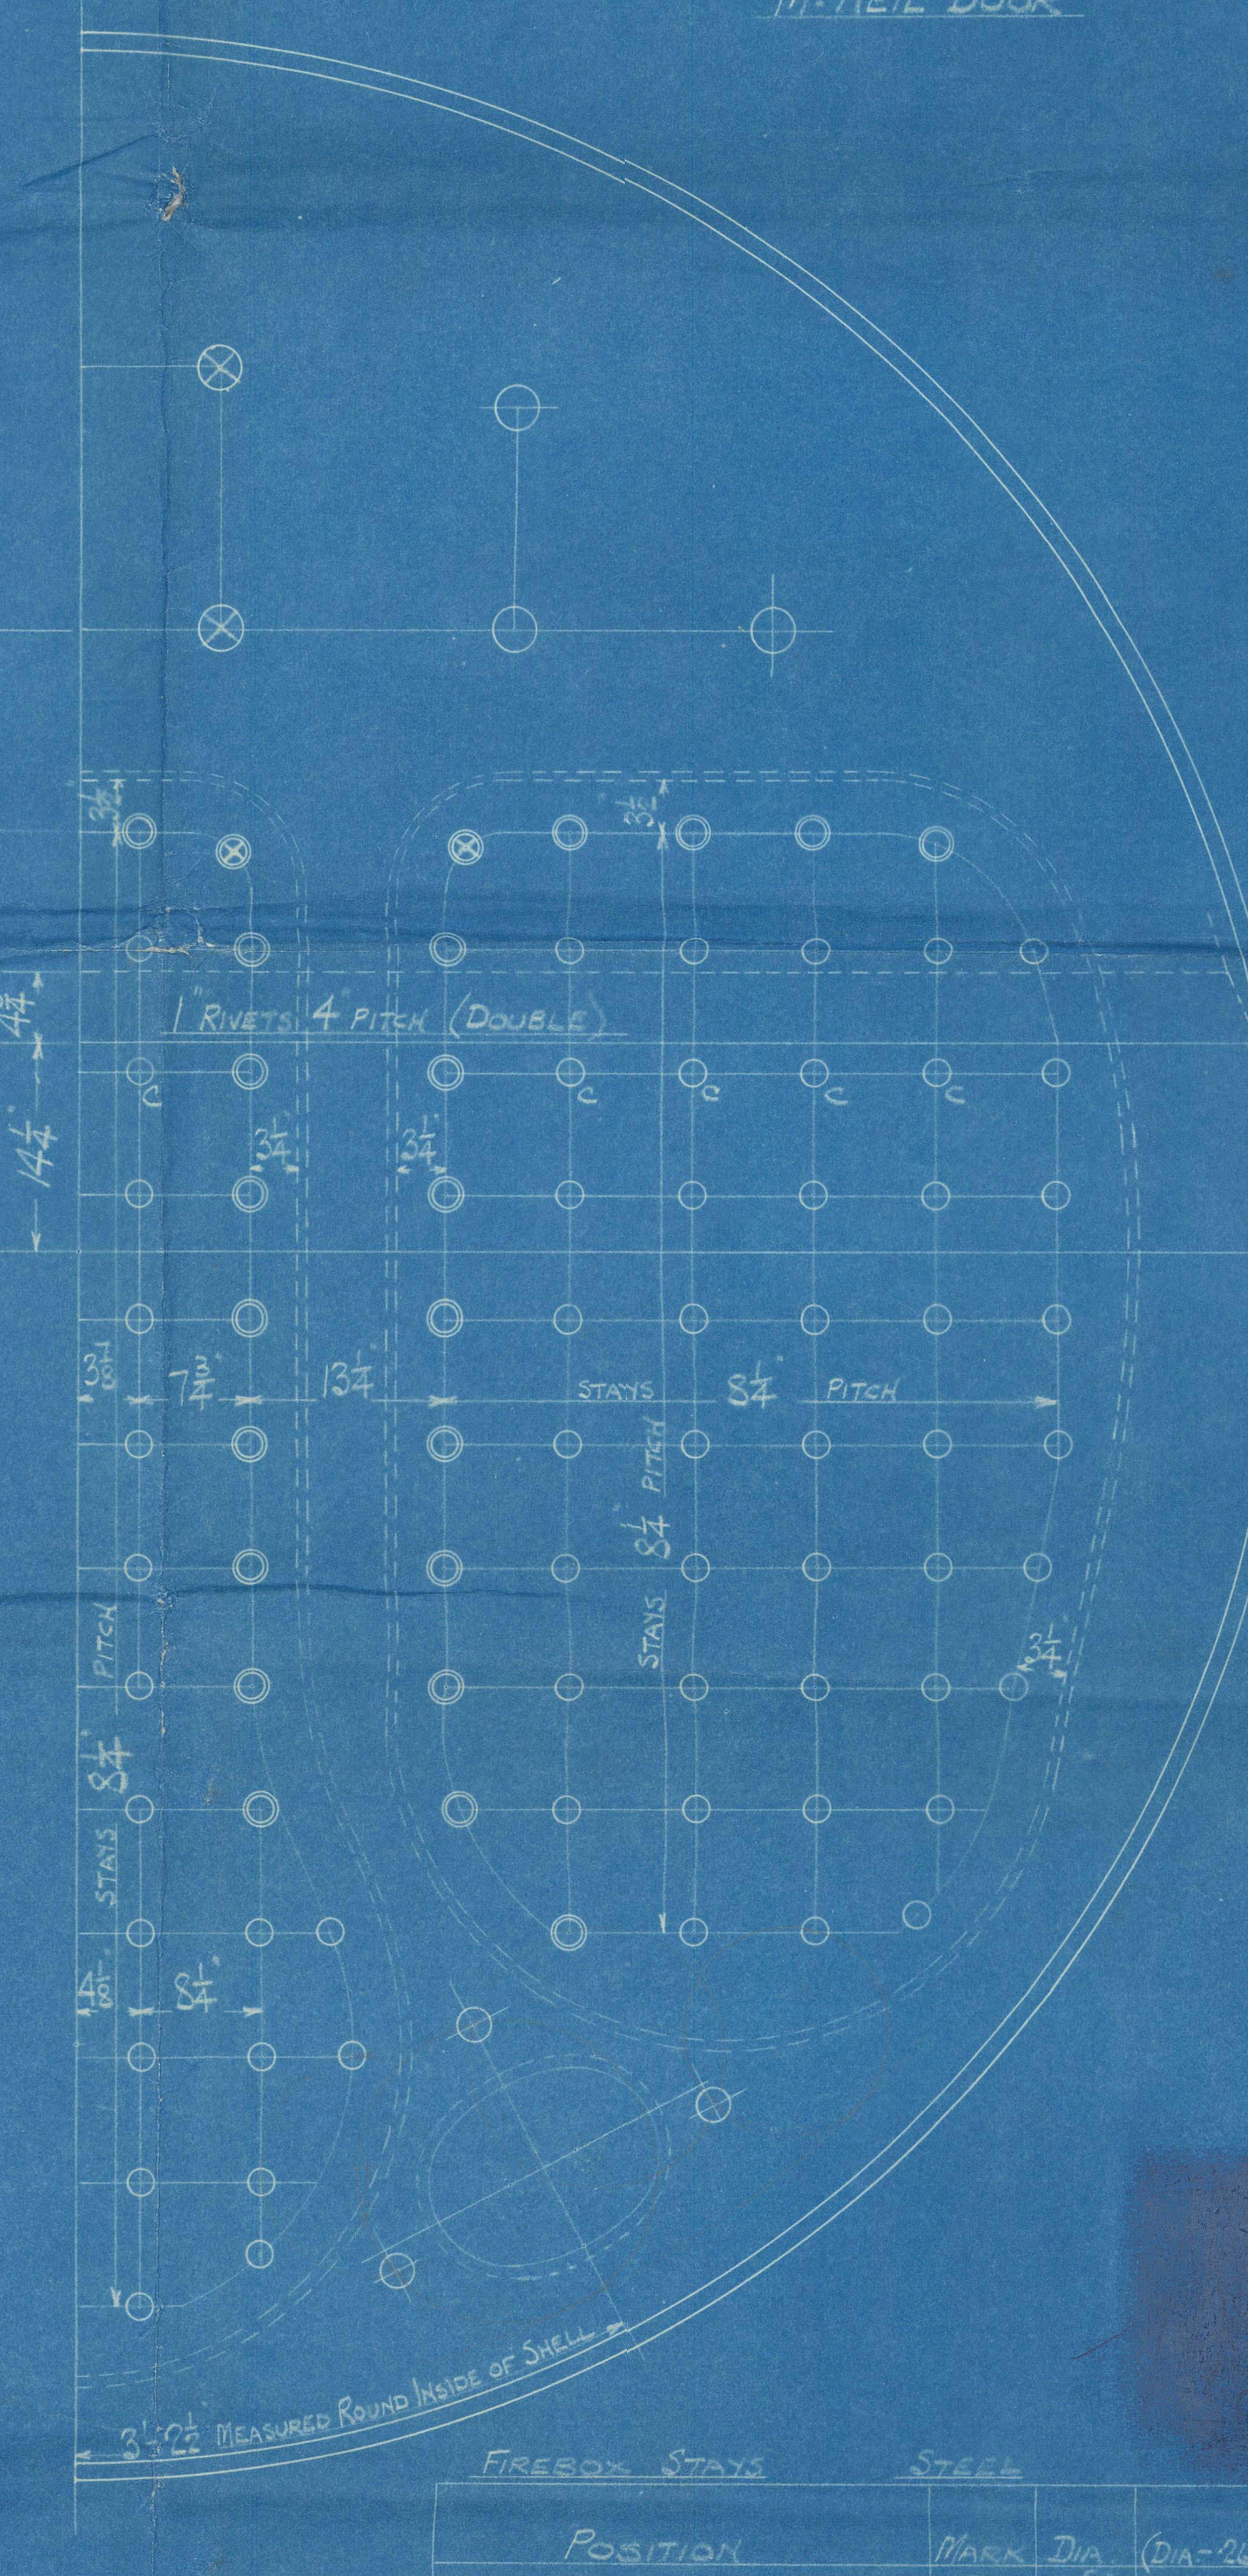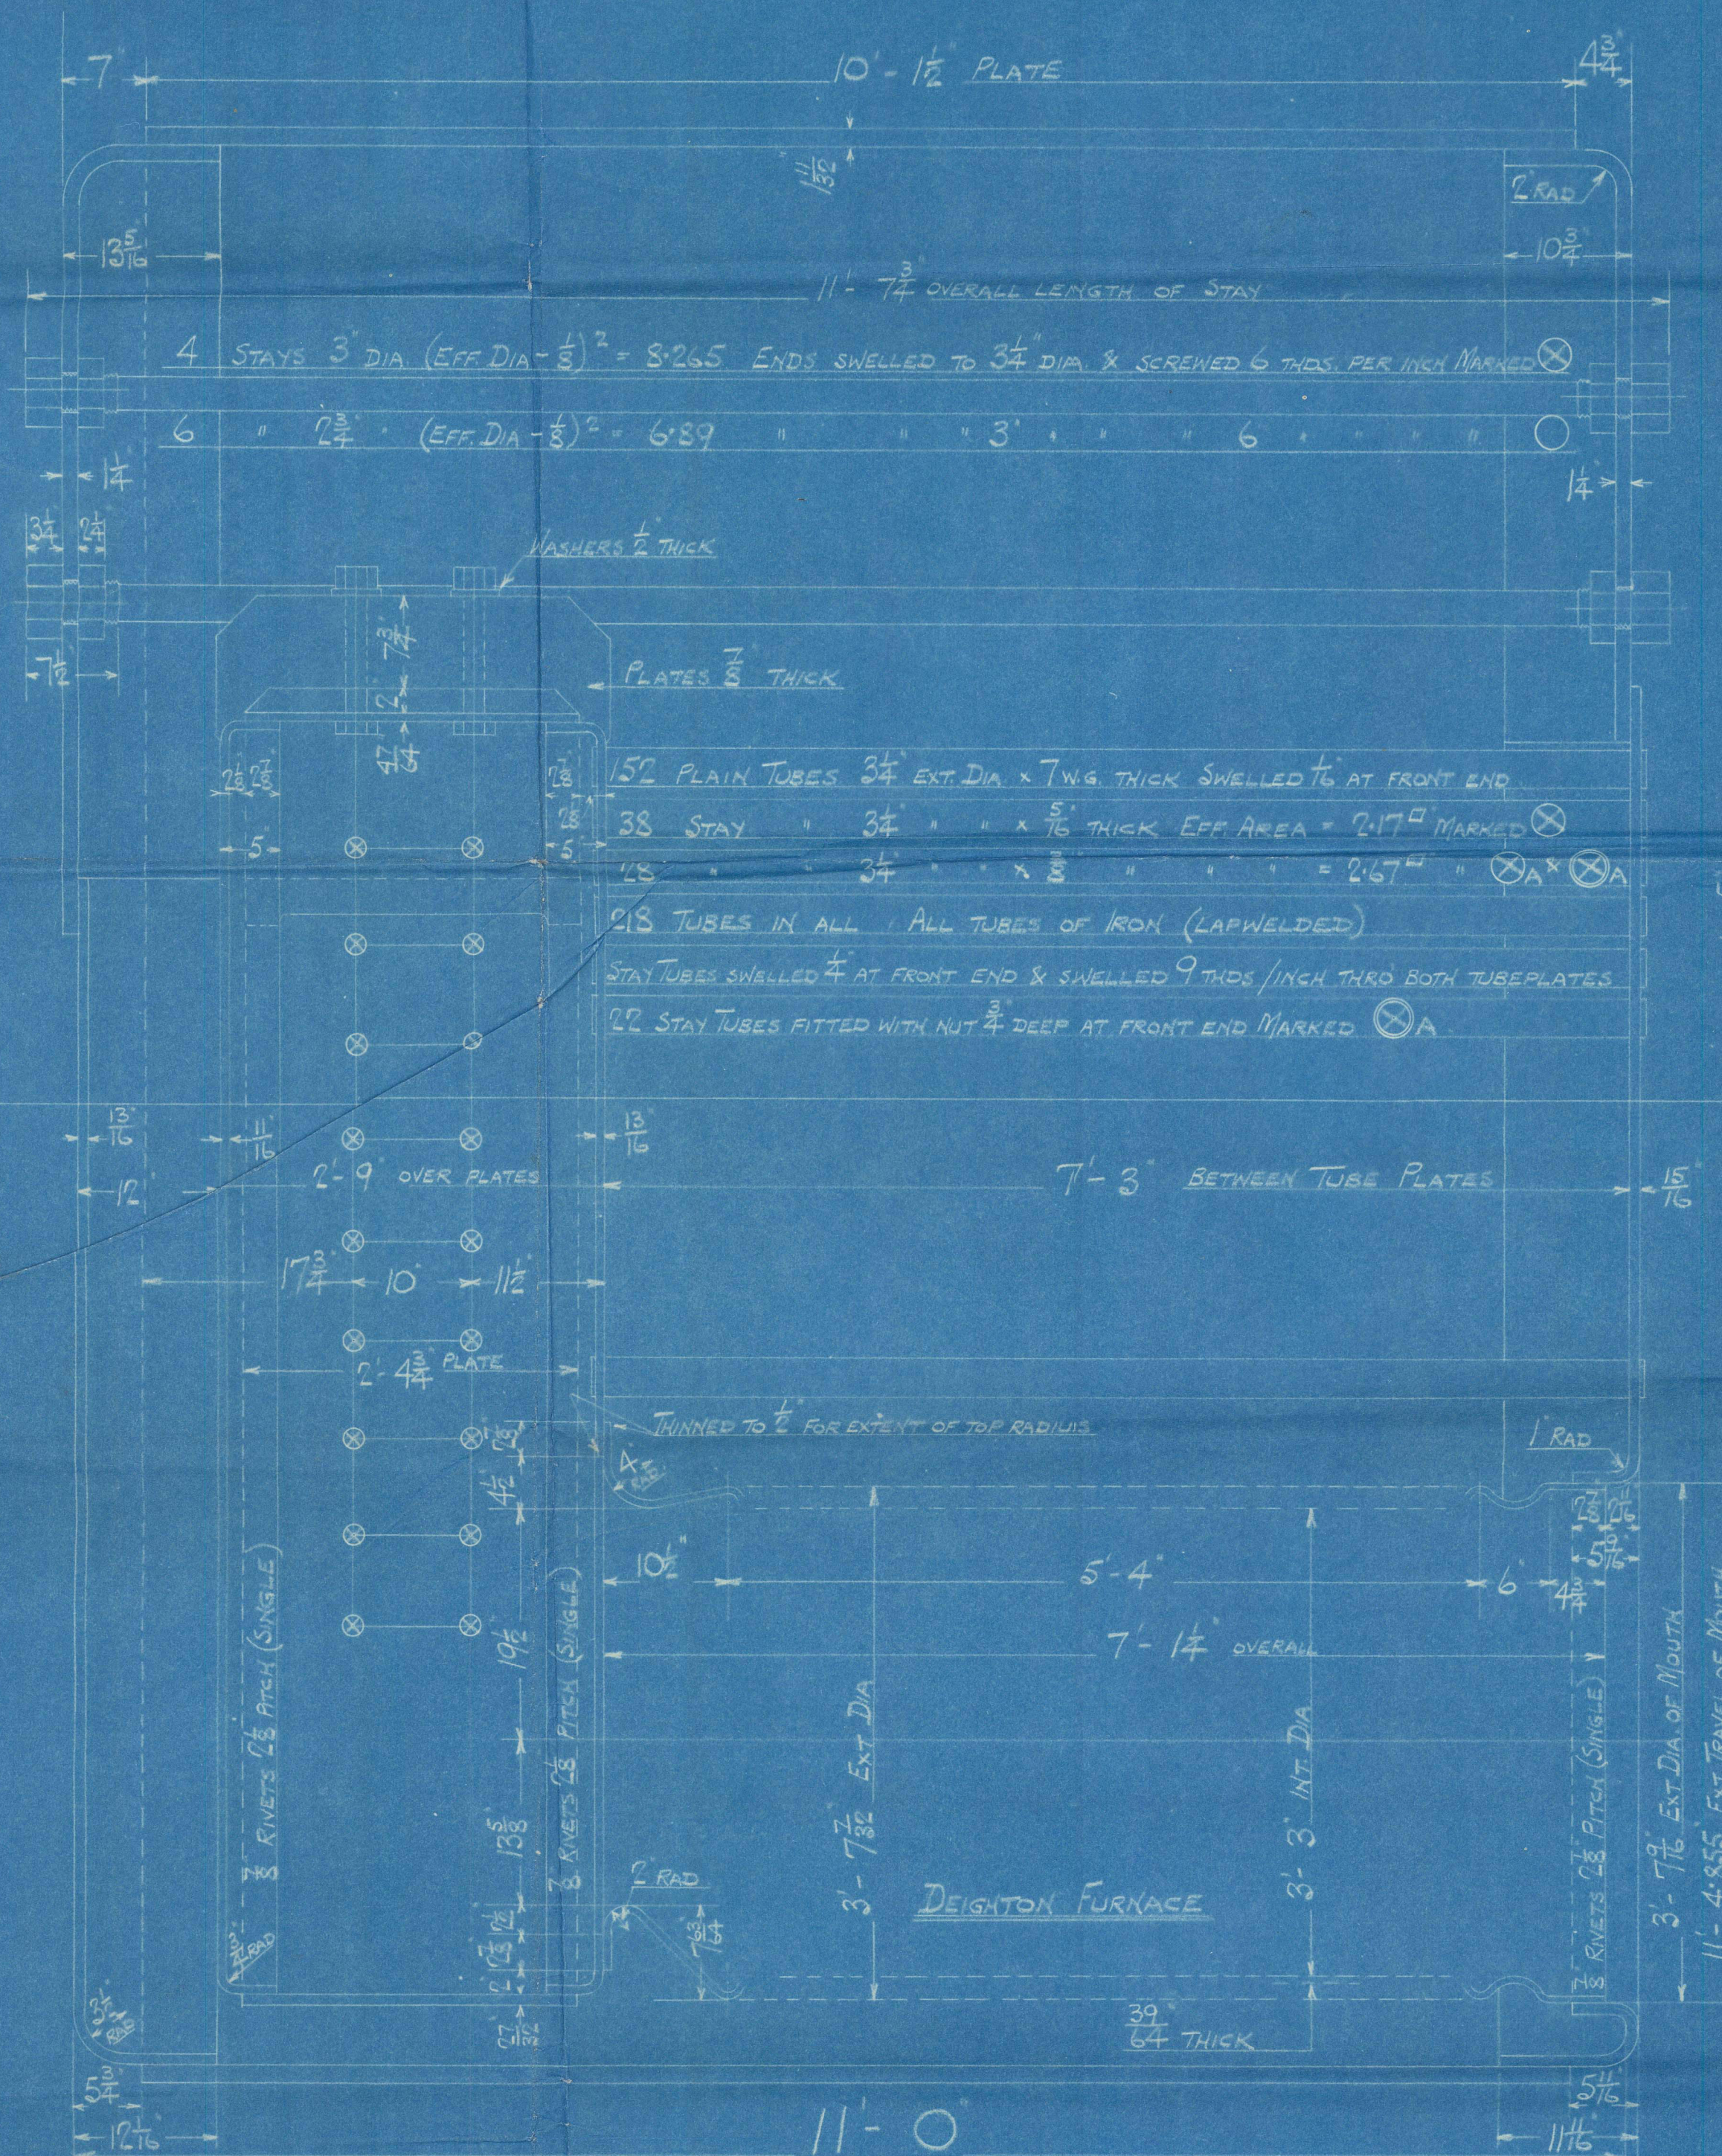

TUBEPLATE & MANHOLE SIDE
STAYS 3/4" DIA
ENDS SWELED TO 1/2" DIA
& SCREWED 6 THDS PER INCH
OUTSIDE NUT 3/8" DEEP
INSIDE NUT 1/2" DEEP
MANHOLE TOP STAY 1/2" DIA
ENDS SWELED TO 1/2" DIA
& SCREWED 6 THDS PER INCH
OUTSIDE NUT 3/8" DEEP
INSIDE NUT 1/2" DEEP

13'-6 INT. DIA

2'-10 x 1/2 MANHOLES AT BACK
MCNEIL DOOR

AUXILIARY BOILER

ONE OFF
CONT. N° 848

WORKING PRESSURE 220 LBS. PER SQUARE INCH

TEST 380


TO PASS LLOYD'S SURVEY

SCALE: 1" = 1/2" ONE FOOT

POSITION	MARK	DIA	(DIA-24) THRS/INCH	SCREWED
BACK	○	1/8	1.844	9
TOP & SIDES	○	1/8	2.199	9
BACK WIDE SPACE & TOP ROW	○	1/8	2.555	9
" TOP CORNER	○	1/8	3.932	9

ALL FIREBOX STAYS SCREWED THRU BOTH PLATES AND NOT FITTED AT EACH END EXCEPT STAYS FROM WING FIREBOX TO SHELL AND STAYS MARKED S IN BACK BOTTOM END WHICH PROJECT 3" AND ARE CAULKED ALL 1/8" NUTS 3" DEEP EXCEPT ON GIRDER TOPS WHERE THE OUTSIDE NUTS ARE 1 1/2" DEEP
ALL 1/8" NUTS 1" DEEP & 2 1/4" NUTS 1 1/2" DEEP

O.T. 3/1880 A. 2021

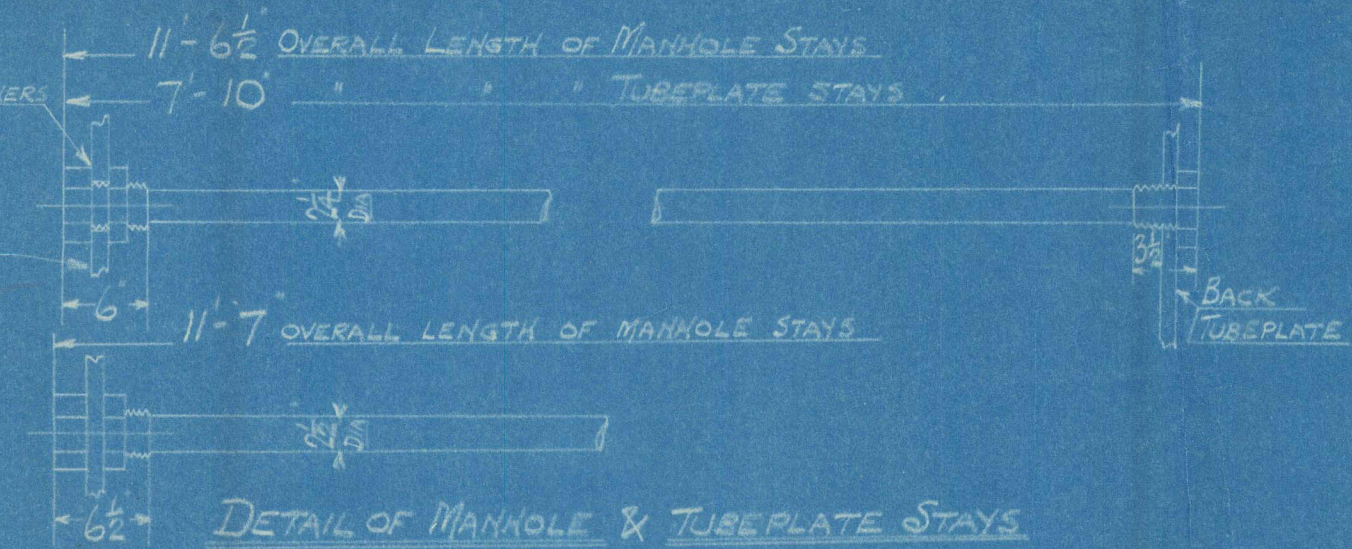

GLASGOW

D. ROWAN & CO. LTD.
AUXILIARY BOILER
No 848

AS FITTED

SEE ALSO
APPROVED PLAN

Beveridge

GLASGOW REPORT No 46855

RETAIN
© 2021
Lloyd's Register
Foundation

W024 - 0036 (2/2)