

14-11-19

S.S. "KILDONAN." — "KILFREE" "KILFINNEY" "KILDWICK" "KILDRESS"

MIDSHIP SECTION.

SCALE 2" = 1 FOOT


STEEL SCREW VESSEL.

TO CLASS 100 A1

DIMENSIONS - 213' 6" L x 29' 10" MLD x 16' 6" MLD

EQUIPMENT

|                                  |                       |
|----------------------------------|-----------------------|
| 2 BOWER ANCHORS                  | 2 1/4 CWT. STOCKLESS. |
| 1 ANCHOR                         | 18                    |
| 1 KEDGE                          | 2 3/4                 |
| 1 STREAM                         | 5 1/2                 |
| 20 FATHS. 1 3/8" STUD LINK CABLE |                       |
| 60 " 3/4" F.S.N.R. STREAM WIRE   |                       |
| 90 " 3" TONWIRE                  |                       |
| 90 " 6" HANSE                    |                       |
| 90 " 5" HARP                     |                       |

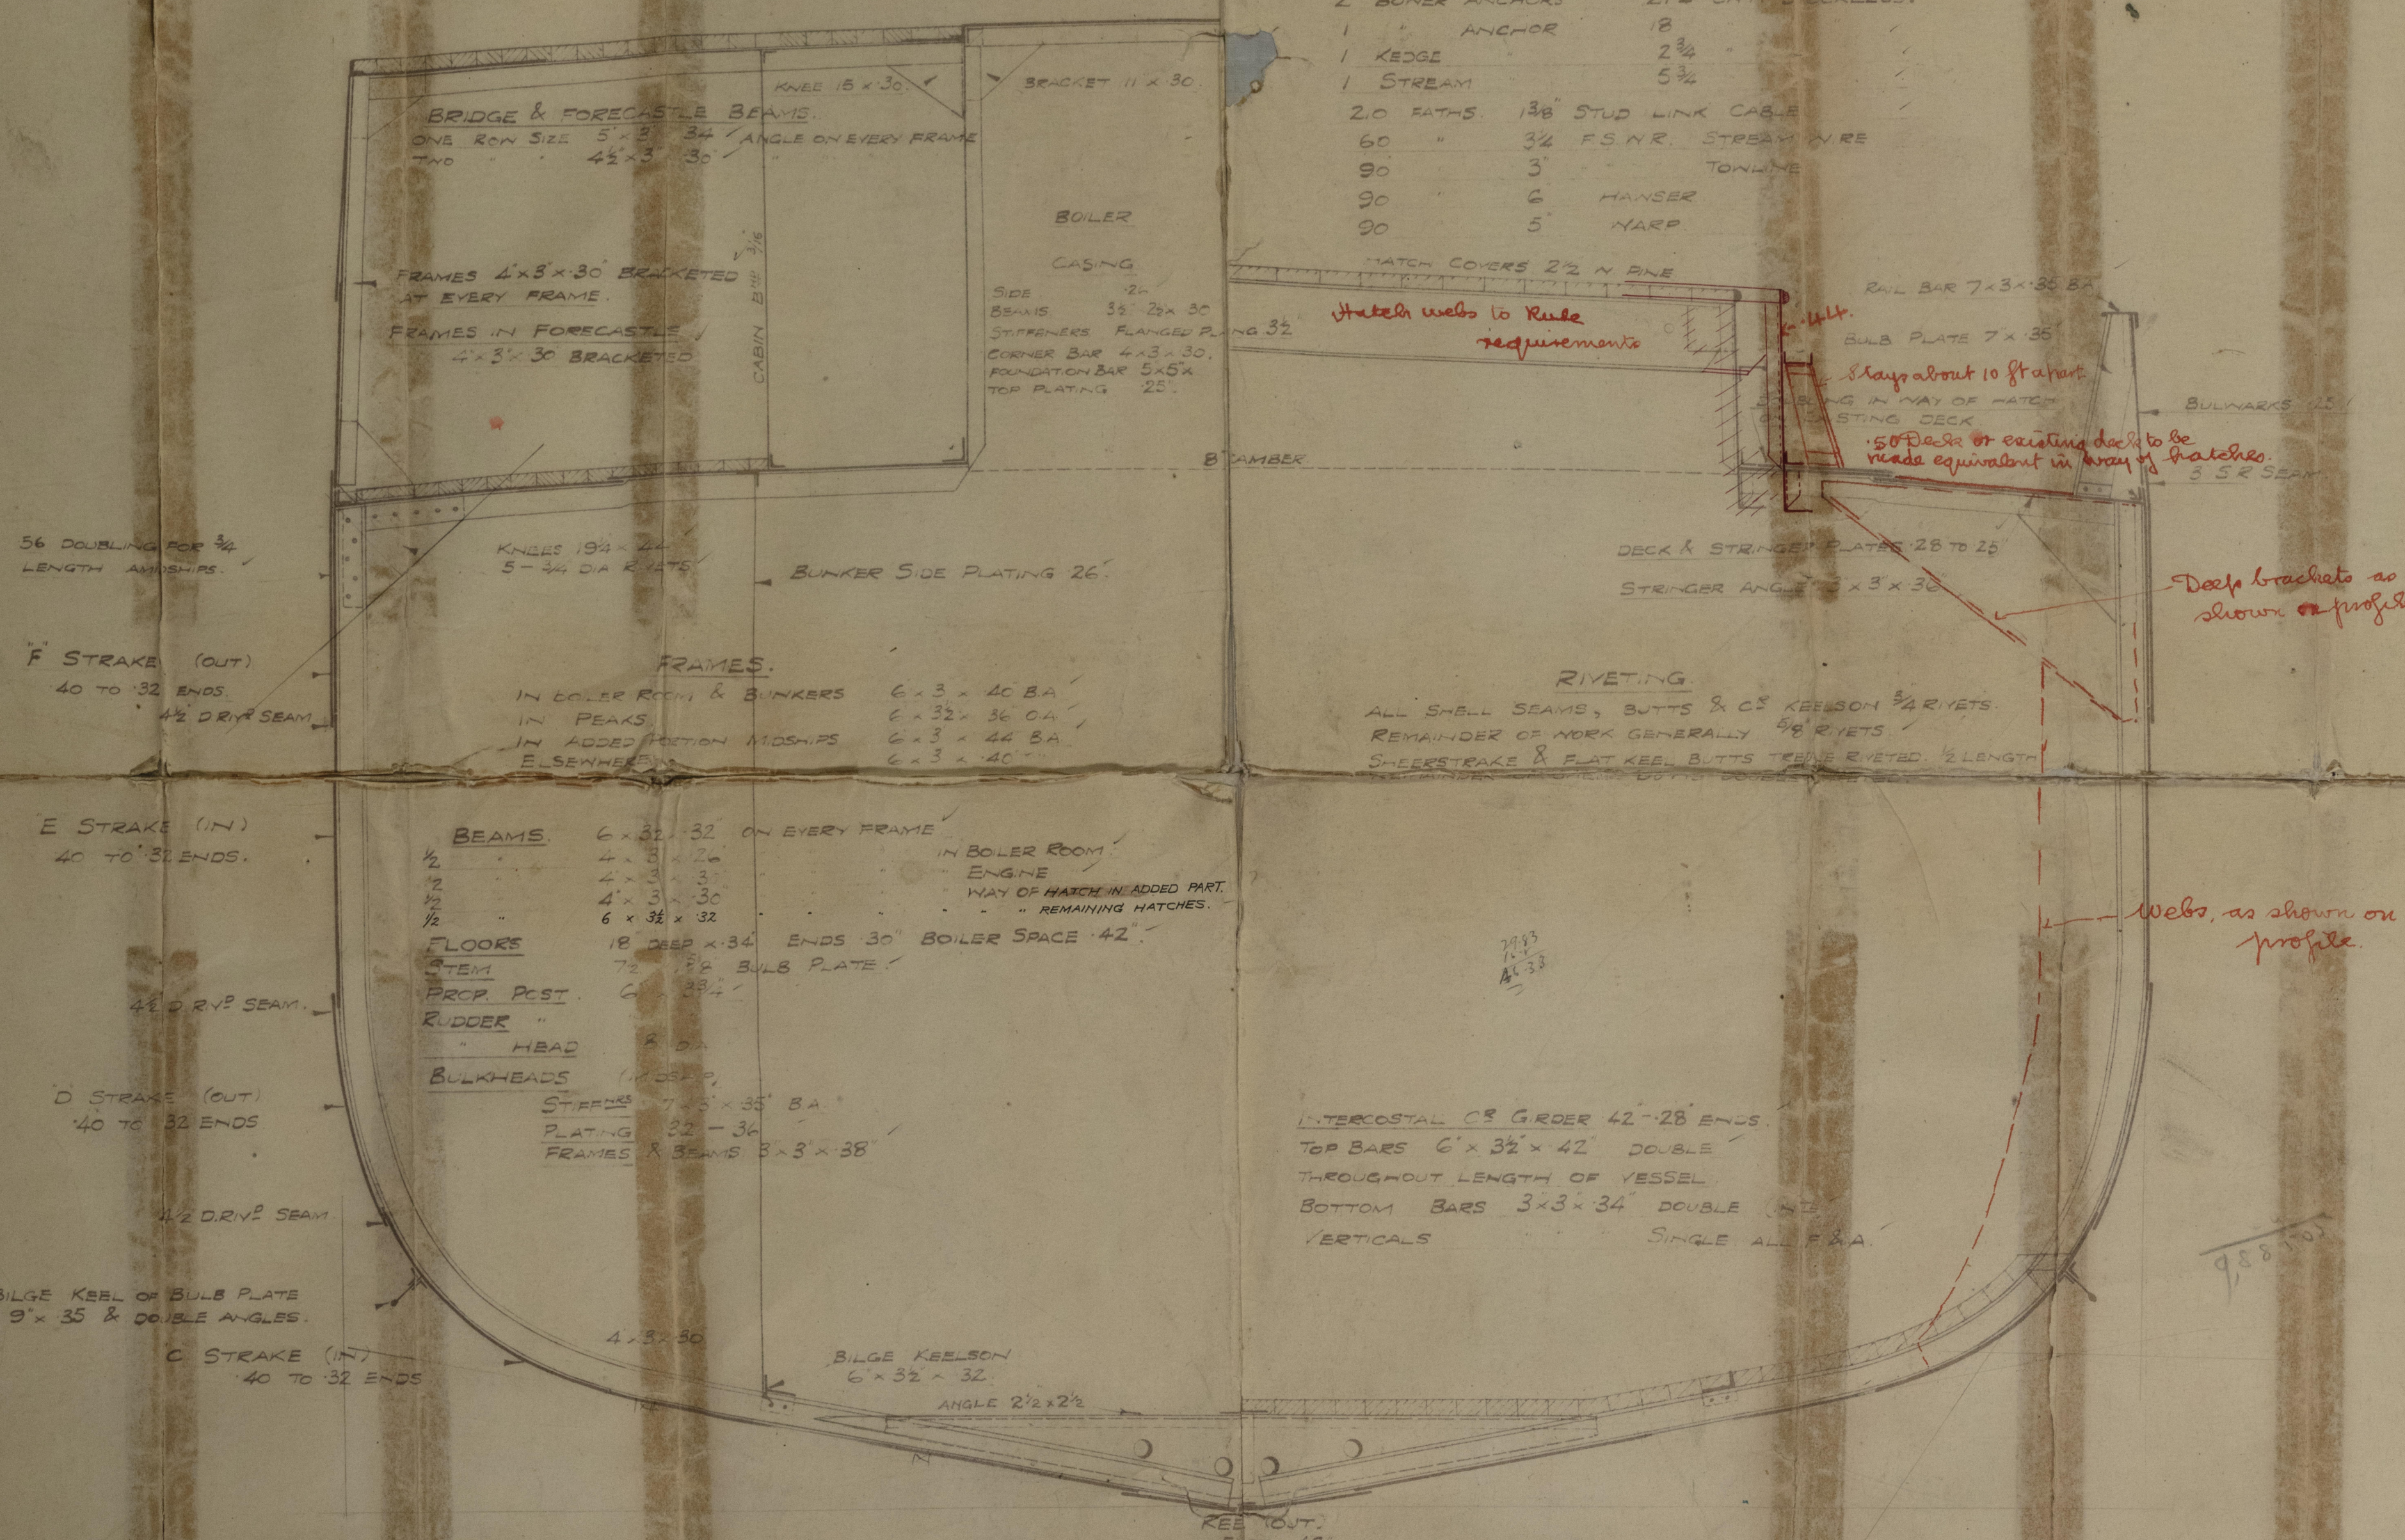

14.11.19



354/19



W1124-0148


Messrs J. A. Thornycroft Ltd

Southampton

S. S. <sup>WATKIN</sup> ~~Kildonan~~ 10559.

Mid ship section.

also for <sup>"PORTMINSTER"</sup> ~~Kilfee~~ Kilfinny Kildwick  
- "Kildress"

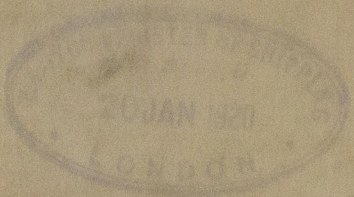

Now named "Watkin"

"Gledwald"

W 877

File with

S.S. "Bjornvik"  
(in Kildress.)

See Rept No. 10740.

RETAIN



© 2021

Lloyd's Register  
Foundation