


9245  
 10/5/10. R.R.  
 10/5/10. R.R.

N<sup>o</sup>s 468-9

DIMS 130-0" x 22-6" EX x 12-7" ML<sup>o</sup>

SCALE  $\frac{1}{2}'' = 1 \text{ FOOT}$

TO CLASS 100A.1 AT LLOYDS FOR FISHING PURPOSES. DECK PLATED  
OVER IN WAY OF MACHINERY SPACE. ENGINE & BOILER CASINGS,  
AS PREVIOUSLY APPROVED.

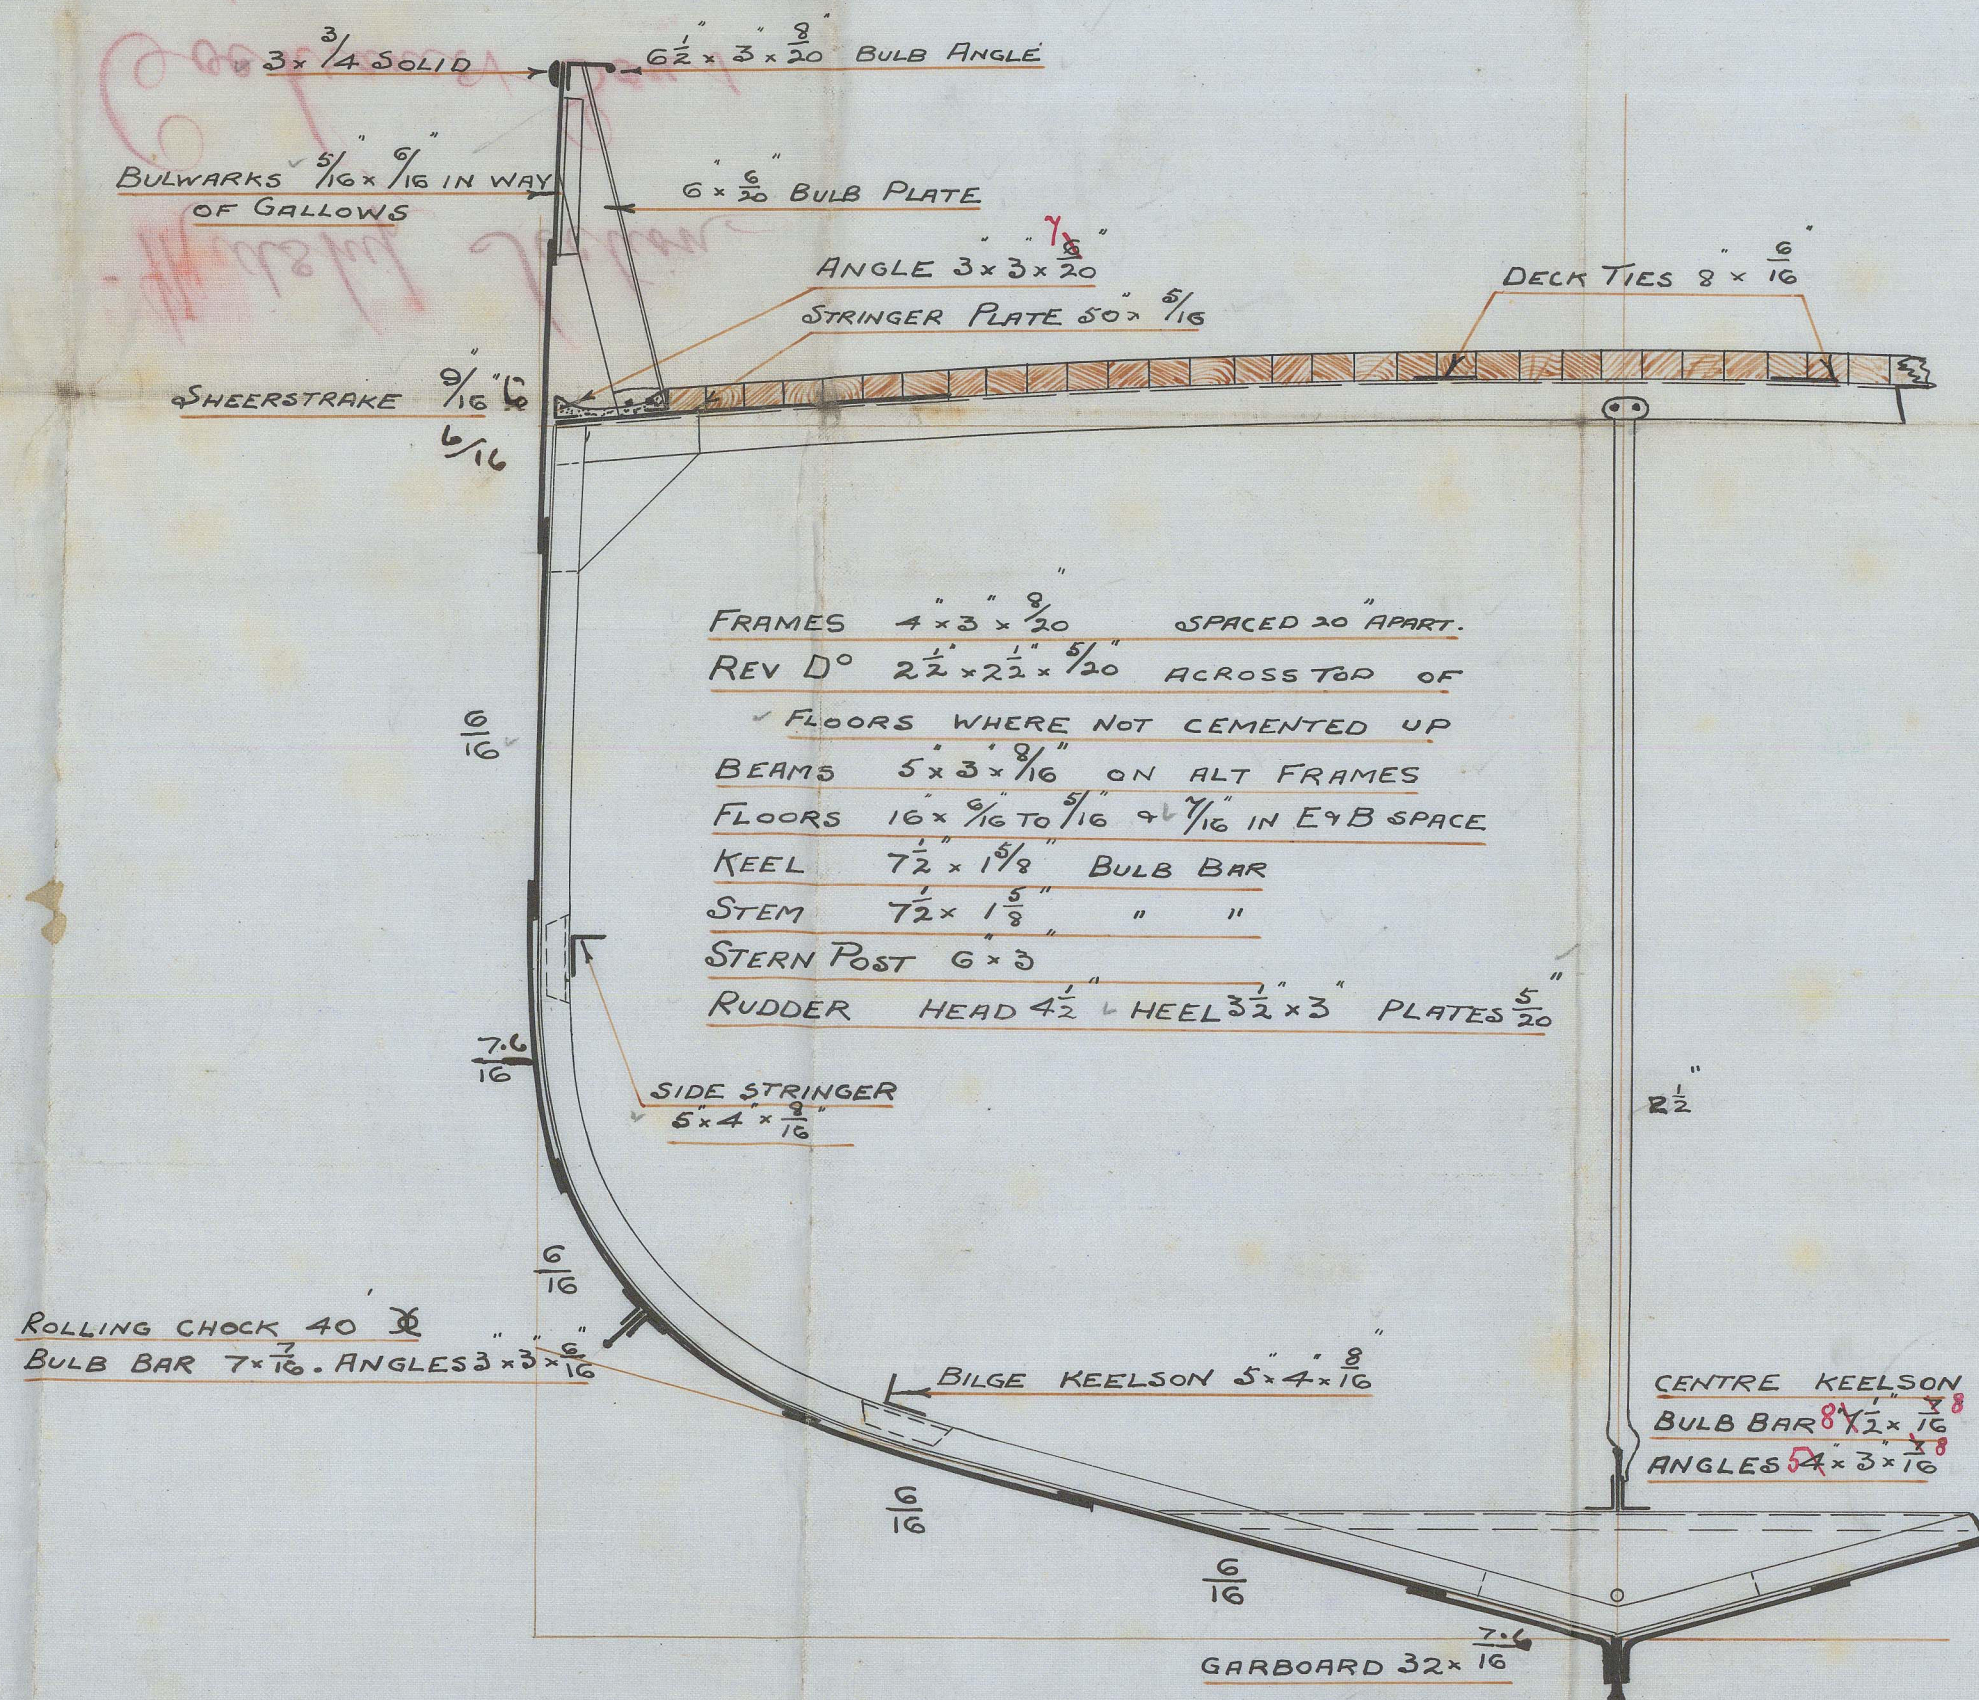

B + D. 34.95 1<sup>ST</sup> NO

L x (B + D). 4543.50 2<sup>ND</sup> NO

L	
D	10.33
L	
B	✓ 5.71

1 <sup>ST</sup>	BOWER ANCHOR	5 <sup>3</sup> / <sub>4</sub>	cwts	EX	STOCK
2 <sup>ND</sup>	"	5 <sup>1</sup> / <sub>4</sub>	"	"	"
	KEDGE ANCHOR	3	"	"	"
	105 FATHOMS	1 <sup>1</sup> / <sub>2</sub>	G	CABLE	
	60 "	6	G	HAWSER	
	60 "	5 <sup>a</sup>		WARP	

BUTTS OF SHELL PLATING LAPPED & DOUBLE  
RIVETED EXCEPT GARBOARD & SHEERSTRAKE  
WHICH ARE TO BE STRAPPED & DOUBLE RIVETED  
LANDINGS DOUBLE RIVETED. BULWARKS  
SINGLE RIVETED

C.F.  
12/5/10

NOV. 5 3000

LLOYD'S REGISTER  
OF SHIPPING.  
11 MAY. 1910  
+ HULL +

Copy 2. 1800

marked quantities




W1125-0005

Midship Section

"  
Cabo S. Vicente"

12/2/10  
C.S.

HUL. 23000

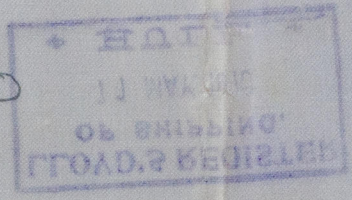







© 2021

Lloyd's Register  
Foundation

W1125-0092



- Midship Section

Cochranes Sons

Nos 468-469

W

/ H. A. S. Russell  
Hull Report

No: 23000

/ S. L. Haldane  
Hull Report

No: 23024


Captain Vicente

1872

1872-10



W1125-0082 © 2021

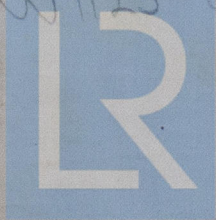

Lloyd's Register  
Foundation