

12-5-10

PLAN No 9246
Mess. Lloyd's Surveyors.
Hull.
COCHRAN & SONS
SHEPHERD
10/5/10. R.R.



PROFILE & DECK PLAN

Nos 468-9

DIM^{NS} LENGTH 130'-0" B.P. x 22'-6" B.K. x 12'-7" DEPTH MOULDED

SCALE 1/4" = ONE FOOT.

NOTE ALL PILLARS TO SURVEYOR'S SATISFACTION

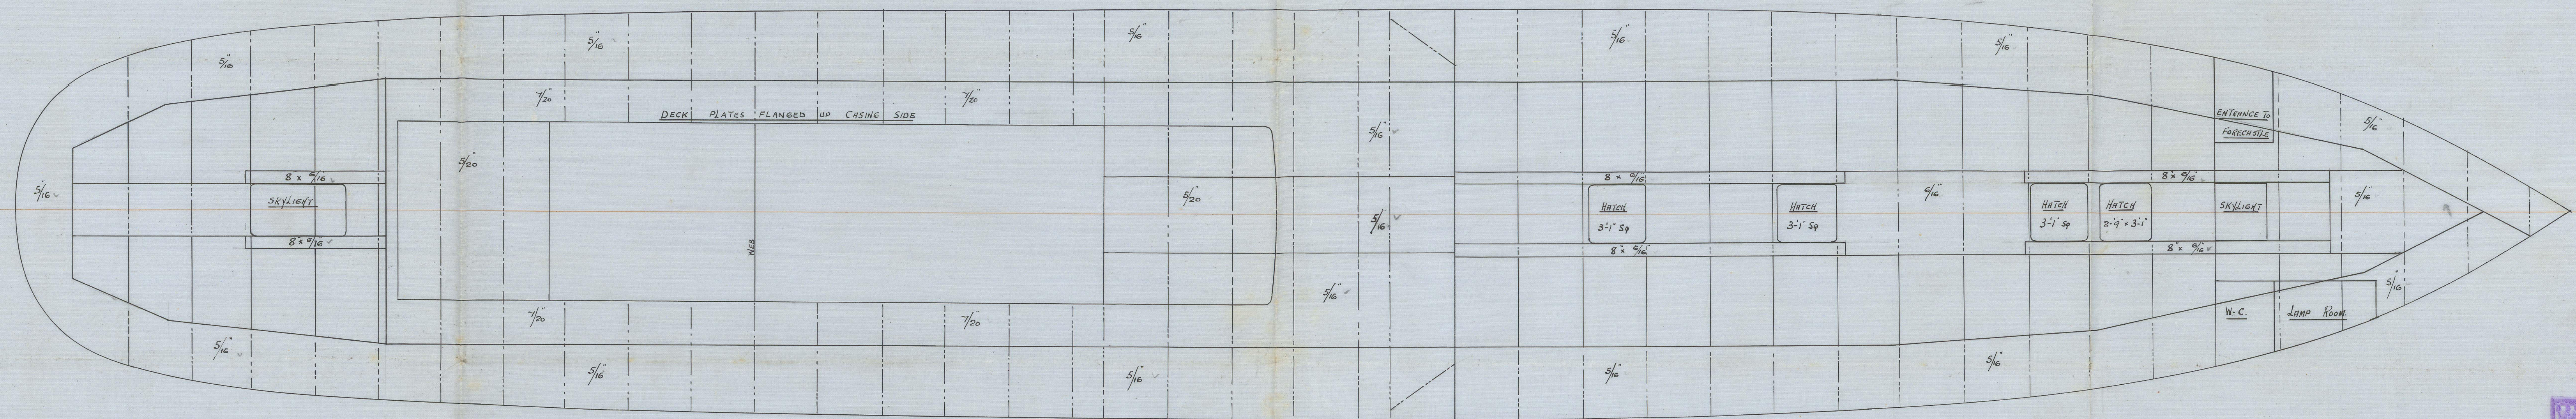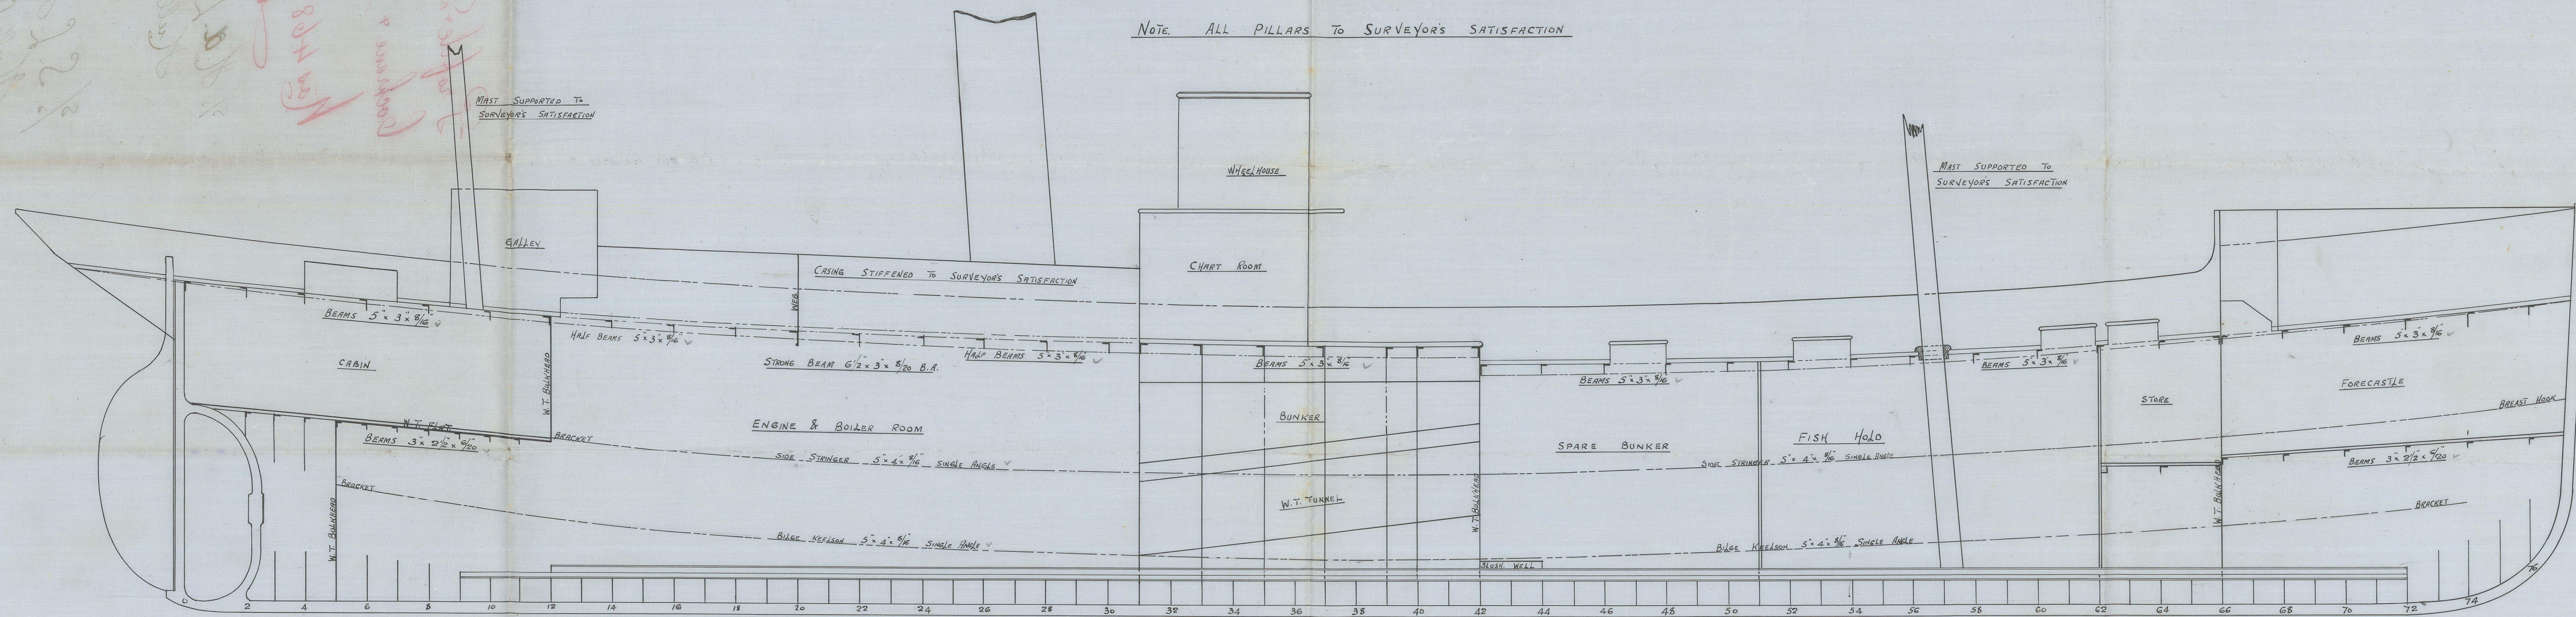

COCHRAN & SONS
SHEPHERD
10/5/10

COCHRAN & SONS
SHEPHERD
10/5/10

Profile & Deck Plan -

Cochrane & Sons

Nos 468 & 469

—

S/ H. A. L. Russell

Hull Report

No: 23000

S/ S. L. Haldane

Hull Report

No: 230³⁰~~29~~

"Cabo S. Vicente"



© 2021

Lloyd's Register
Foundation

W125-0093