

6.1.05  
30.1.05  
3.2.05  
11.2.05  
18.3.05  
18.3.05

T.S.S. N<sup>o</sup> 442 AND 3

MIDSHIP SECTION

DIMENSIONS LBP 550' 0" 65' 0" BM 40' 0" DM

CLASS 100AL LLOYD'S 3RD AND SHELTER D<sup>2</sup> RULE.

SCALE 1/4" = 1' FOOT

LLAND NUMERALS

BREADTH 32' 00"  
DEPTH 41' 00"  
GIRTH 67' 00"  
FRAME N<sup>o</sup> 134  
PLATING N<sup>o</sup> 73762

EQUIPMENT NUMERALS  
BREADTH 32' 00"  
DEPTH 41' 00"  
GIRTH 67' 00"  
FRAME N<sup>o</sup> 134  
PLATING N<sup>o</sup> 73762

Boat deck  
Upper from  
lower from  
Shelter deck

EQUIPMENT N<sup>o</sup> UNDER 26500

LOWER ANCHOR 9' CWTs EX STOCK  

Thickness in way  
of after opening  
see profile  
gradually reduced to  
satisfactory  
18/20  
18/20  
18/20

T. SHEET PILE 24" x 12" FOR LENGTH 10' AT ENDS  
DOUBLE BUTT STRAPS, TANGS RIVETED FOR SEAMEN  
FORWARD AND 2' 6" 1/2 BUTT STRAPS AT ENDS  
QUADRUPLE IN WAY OF BREAK  
DIVIDED IN WAY OF BREAK AS SHOWN ON PROFILE


20  
18

20  
18

18  
16

SHIELD RIVETING  
BUTTS LAPPED & TANGS RIVETED  
LANDINGS DOUBLE RIVETED

LANDINGS MARKED THUS X TO BE  
TANGS RIVETED IN  
as per rule - 15' to be rivetted 15'

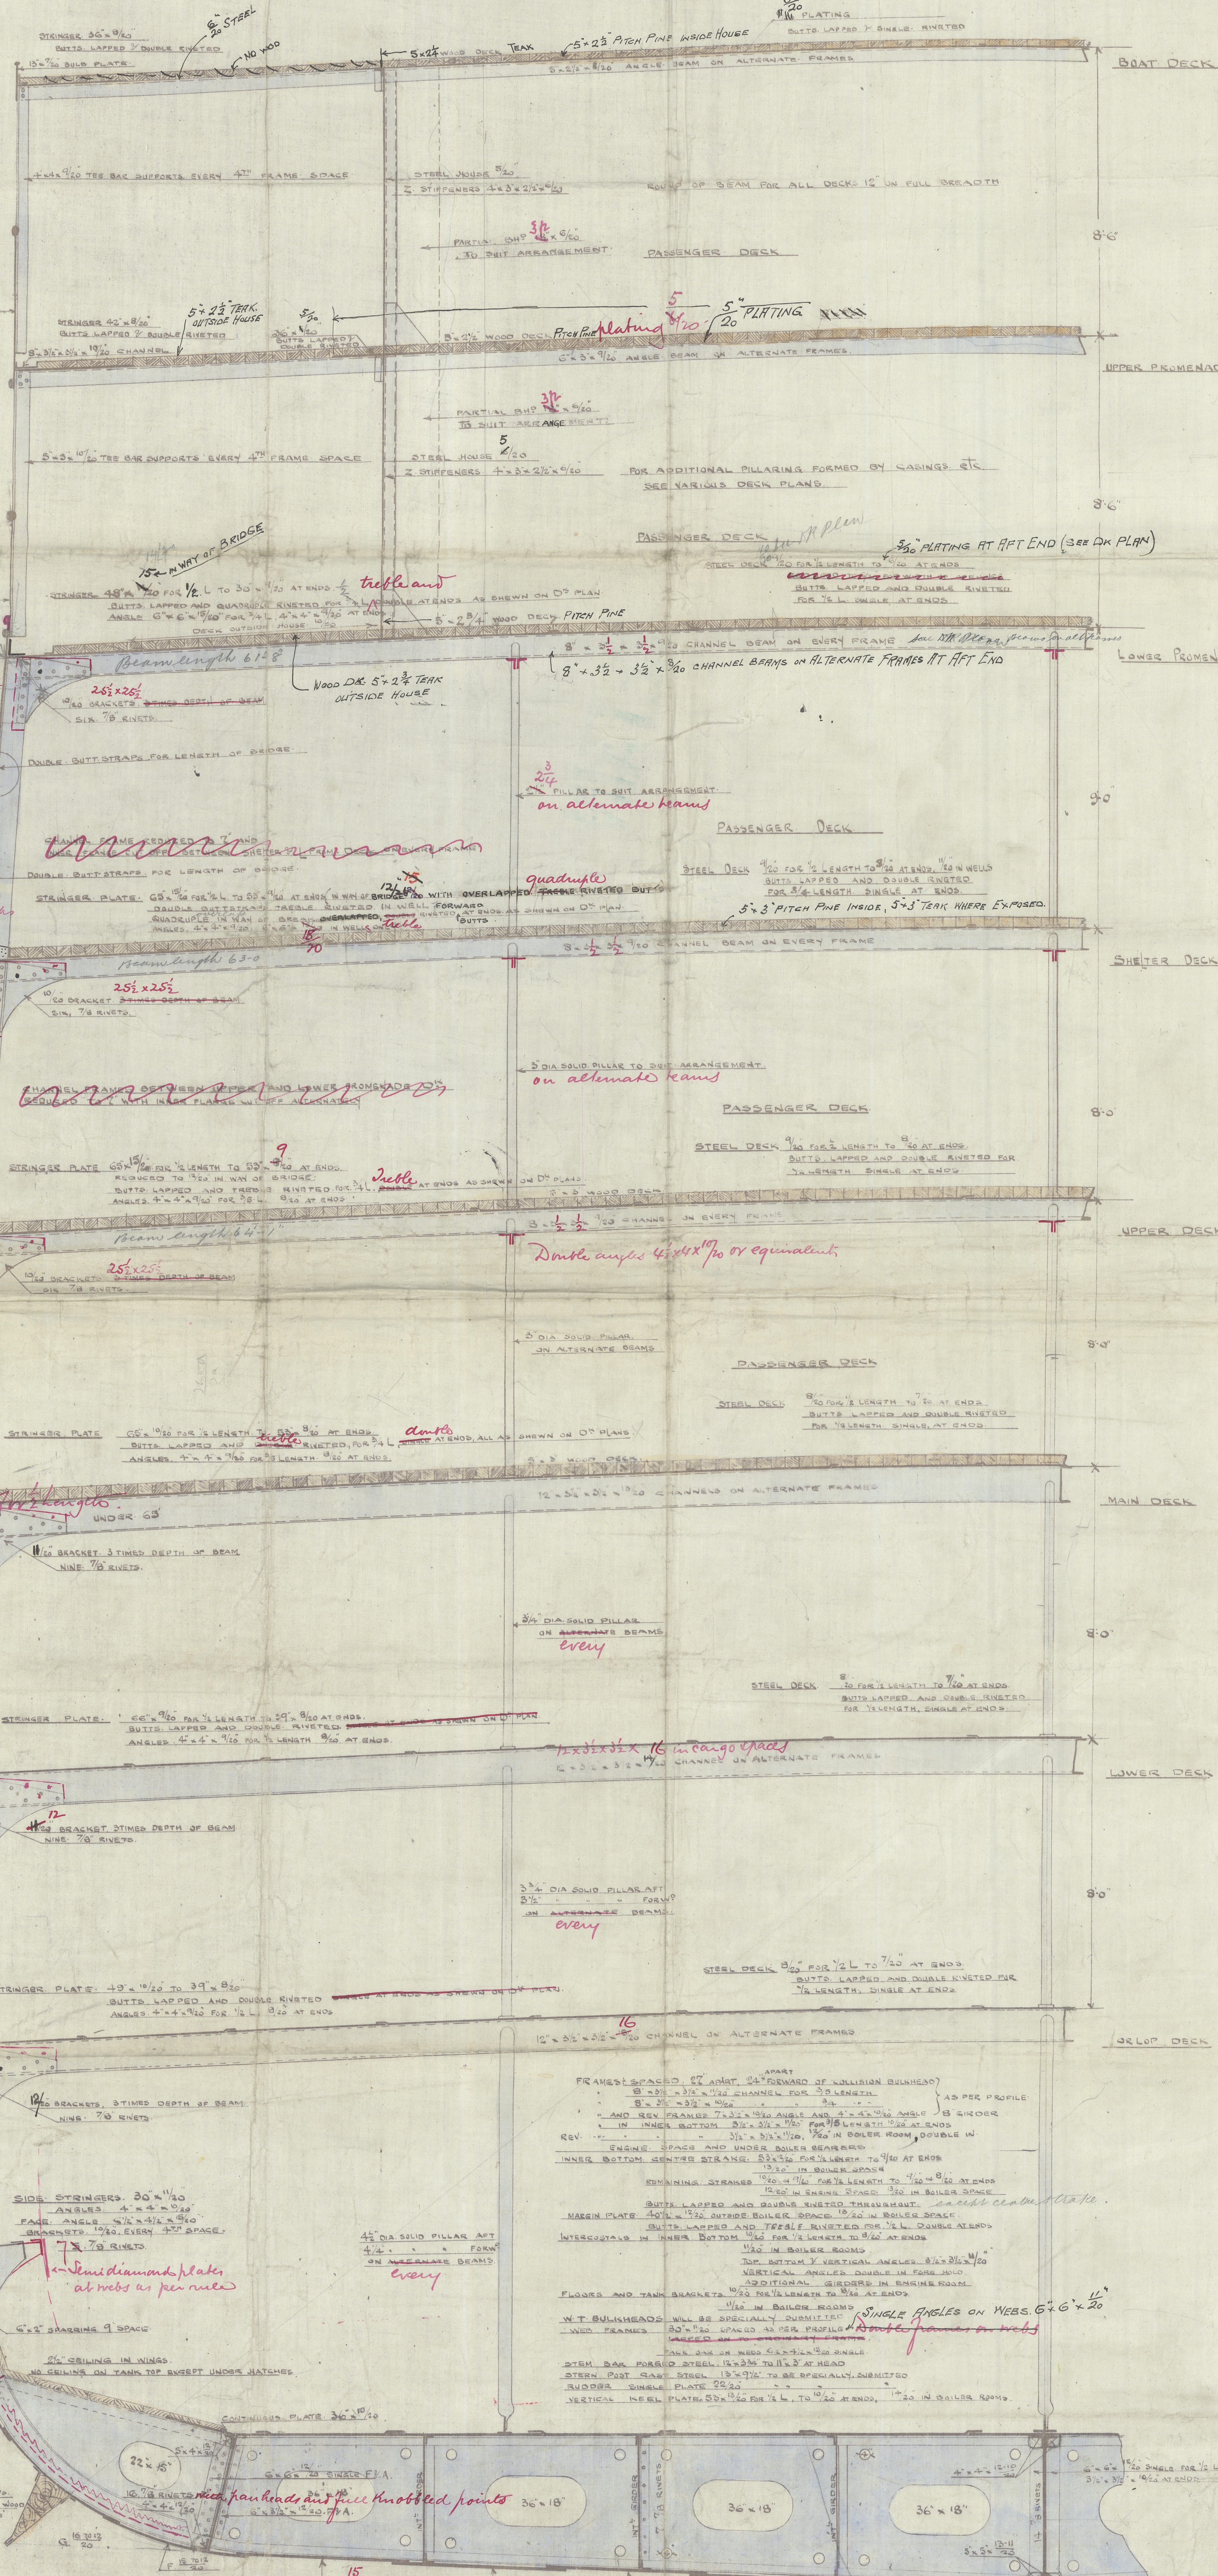

No reduction in way of double bottoms.

18/3/05  
18/3/05  
18/3/05



The Fairfield Ship B & Eng Co

W1127-0031

No. 442443

Midship Section



Empress of Britain  
"Empress of Britain"  
Gls. Report No 23957.

"Empress of Ireland"  
Gls. rpt. No. 24118



RETAIN



© 2020

Lloyd's Register  
Foundation