


— T.S.S. N^{OS} 442-3 —
 — ORLOP DECK, SHEWING BEAMS, —
 — WEB FRAMES & PILLARS IN WAY OF —
 1/4" 2.05 — ENGINE & BOILER SPACES —
 — SCALE 1/4" = 1 FOOT —

MILITARY

 

Stappling of Bunker Mass, to Surveyor's satisfaction

14/2/05




Fairfield S.B. & E.C.

1885 44 43 44 48
LONDON

Web Frames Beams

4 Pillars in
E & B space

Orlop Deck Plan

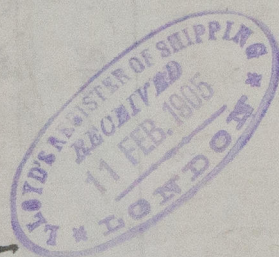

Empress of Britani

Gls. Report No 23909.

Empress of Ireland

Gls. rpt. No. 24118

RETAIN



© 2020

Lloyd's Register
Foundation