

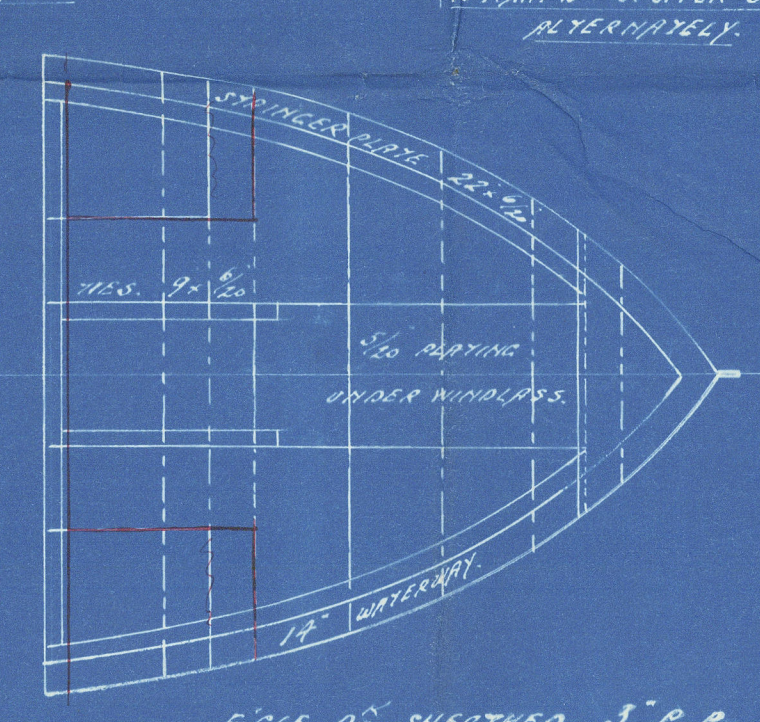
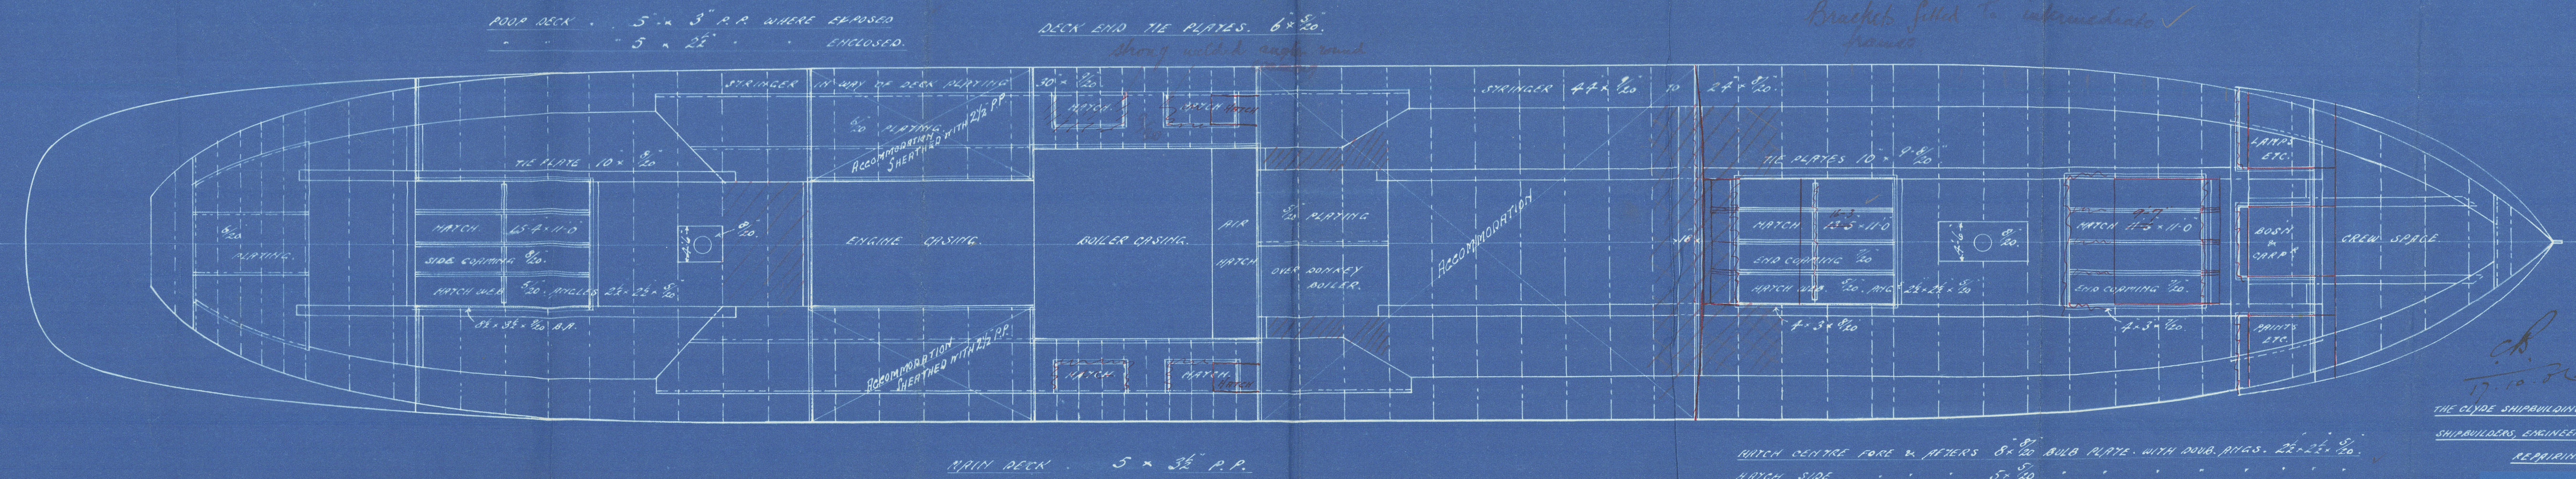


17-11-06

PROFILE & DECK PLANS.  
 S. S. N° 273. SCALE 1/8" = 1 FOOT.  
 LENGTH B.P. 210'0"  
 BREADTH M.P. 31'3"  
 DEPTH M.P. 17'3"  
 70 CLASS 100A.1. LLOYDS.

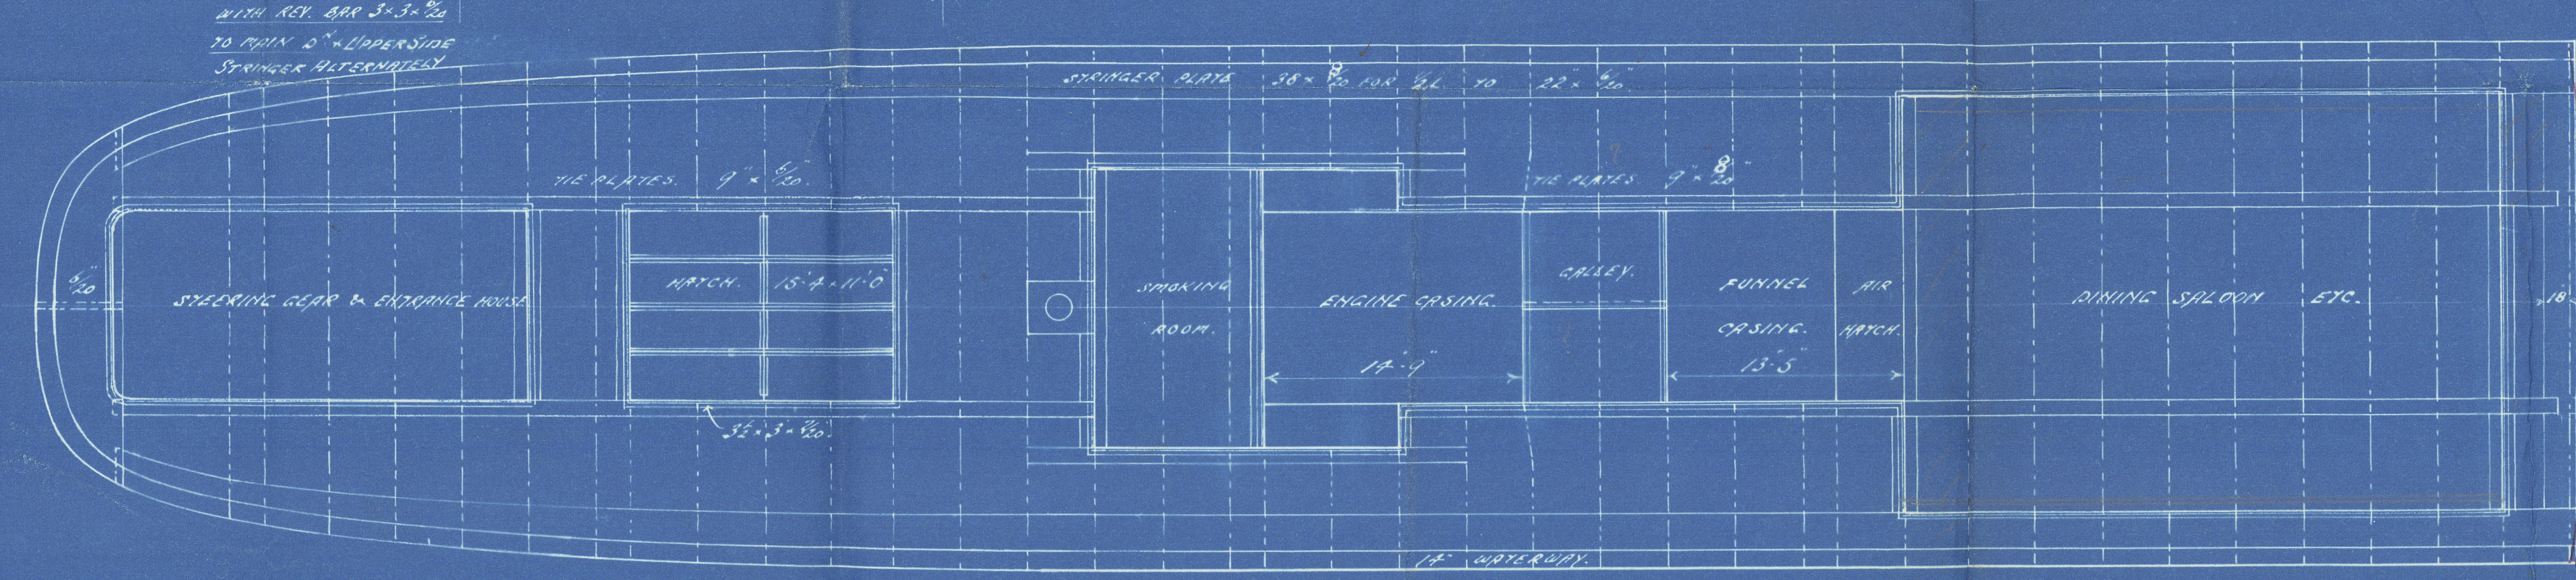

THE CLYDE SHIPBUILDING & ENGINEERING CO. LTD.  
 SHIPBUILDERS, ENGINEERS & BOILERMAKERS.  
 REPAIRING DOCKS.  
 GLENGOW.  
 DATE 12-10-06

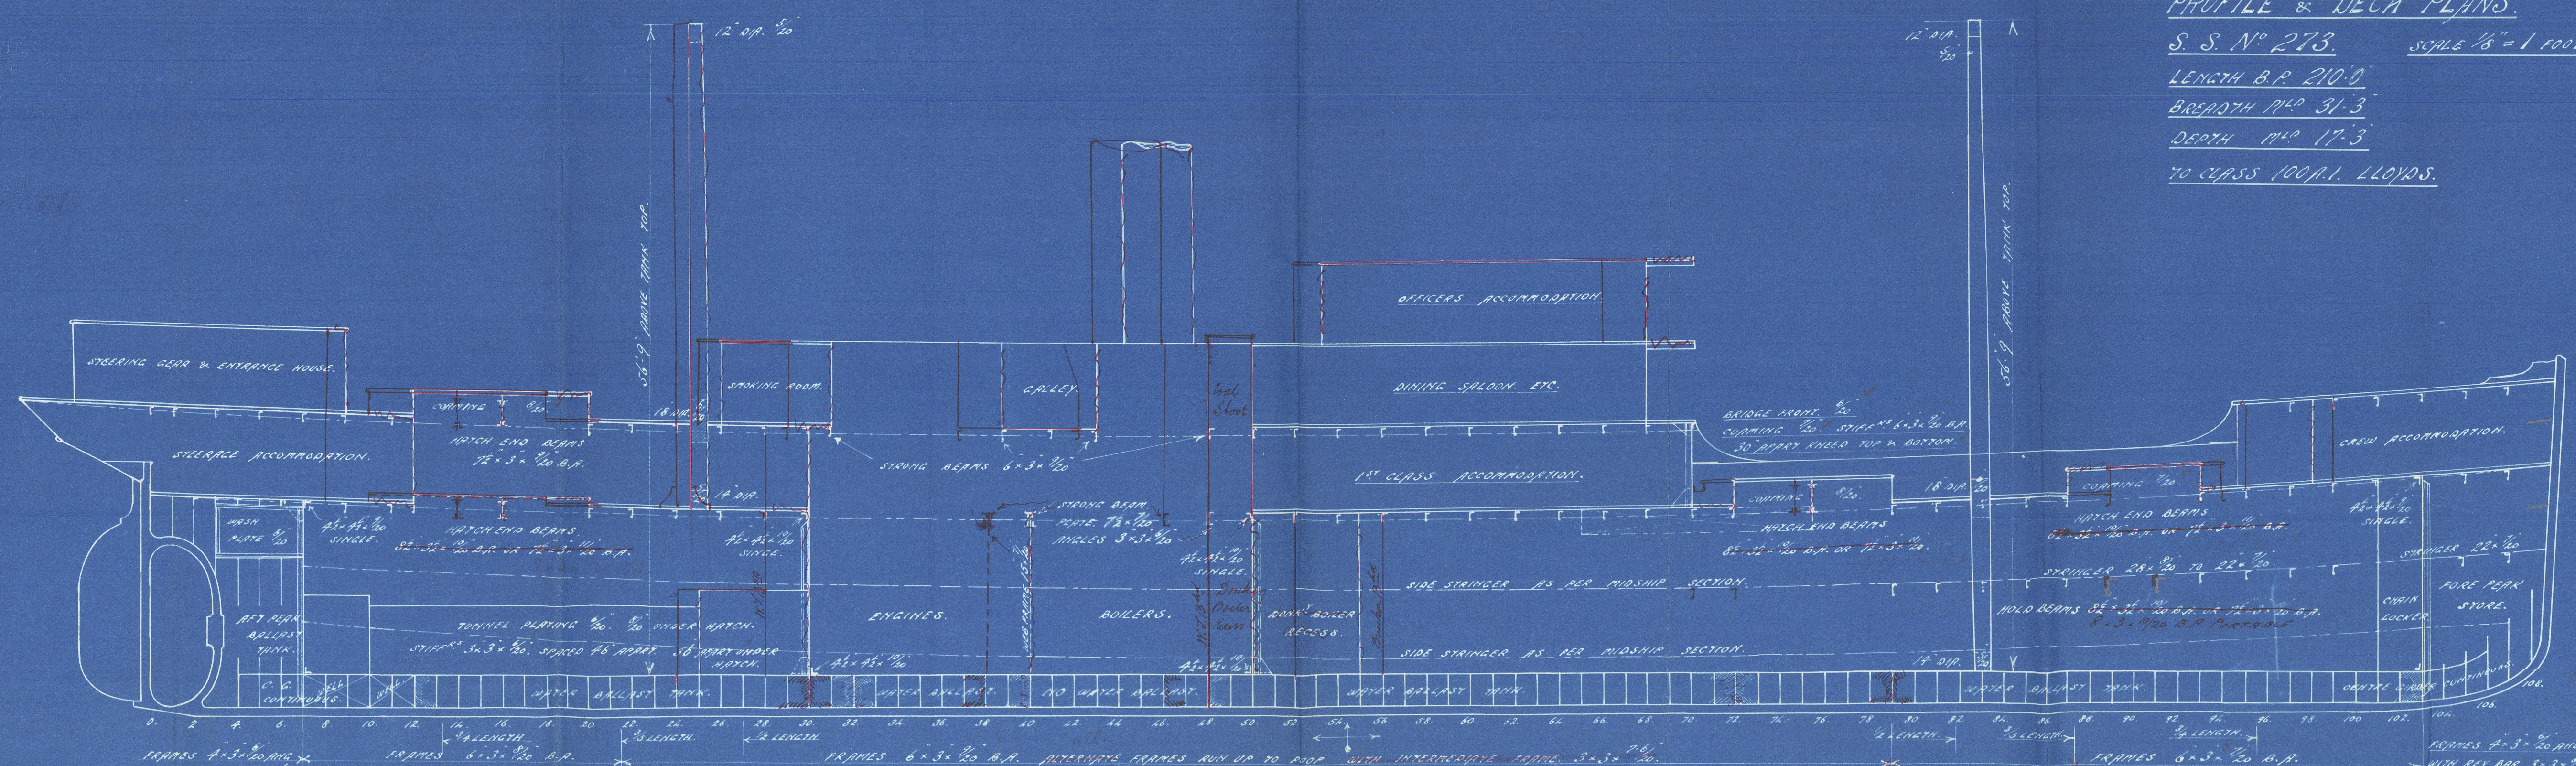

Profile & Deck Plan.  
Clyde SB ring co.  
No 273

---

S.S. "Makambo"  
Gen report No 15026

---

RETAIN



© 2020

Lloyd's Register  
Foundation