

PRINCIPAL DIMENSIONS:

LENGTH SPAN DECK	242' 0"
LENGTH OVERALL	242' 0"
BEAM MOULDED	39' 0"
DEPTH TO UPPER DECK	31' 0"
DEPTH TO SHELTER DECK	39' 0"
DEPTH TO LOWER DECK	18' 0"

CLASS-LLLOYDS+100AH

TRANSVERSE NO. = (B+D) = 90.67

LONGITUDINAL NO. = L(B+D) = 40393

11-17

EQUIPMENT NO.

LONGITUDINAL NO.	40393
SHELTER DECK	2673
HOUSE ON SHELTER DECK	115
HOUSE ON SHELTER DECK MIDDLE	230
HOUSE ON SHELTER DECK	43721

EQUIPMENT

2 STOCKLESS BOWER ANCHORS	5674
STOCKLESS BOWER ANCHORS	7336
STOCKLESS BOWER ANCHORS	3010
STOCKLESS BOWER ANCHORS	1400
100 PATHS 5/8" STEEL WIRE FOR STEAM ANCHOR	
100 PATHS 5/8" STEEL WIRE TOWLINE	
4 LENGTHS 100 PATHS EACH 5/8" MANILA HAWSER	

CHANGE

1	11-17
---	-------

ATTN

1	11-17
---	-------

ATTN

1	11-17
---	-------

Merchant S.B. Corpth N^o 385.

Midship Section.


Empire Seal^{ea}

S/S. "CALIFORNIAN."

REPORT N^o 4376

130

~~PLANS TRANSFERRED
TO SISTER VESSEL~~

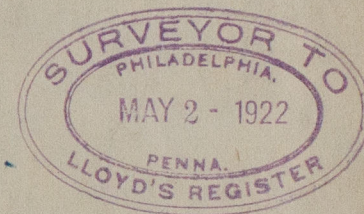

Note: First Entry Report Flamena

no 4376. forwarded
on May 8th, 1922.

"EMPIRE SEAL"

Built 1922

M.M. 1128



© 2020

Lloyd's Register

W1128-0023
Foundation