


28 FEB 1949

COPY.

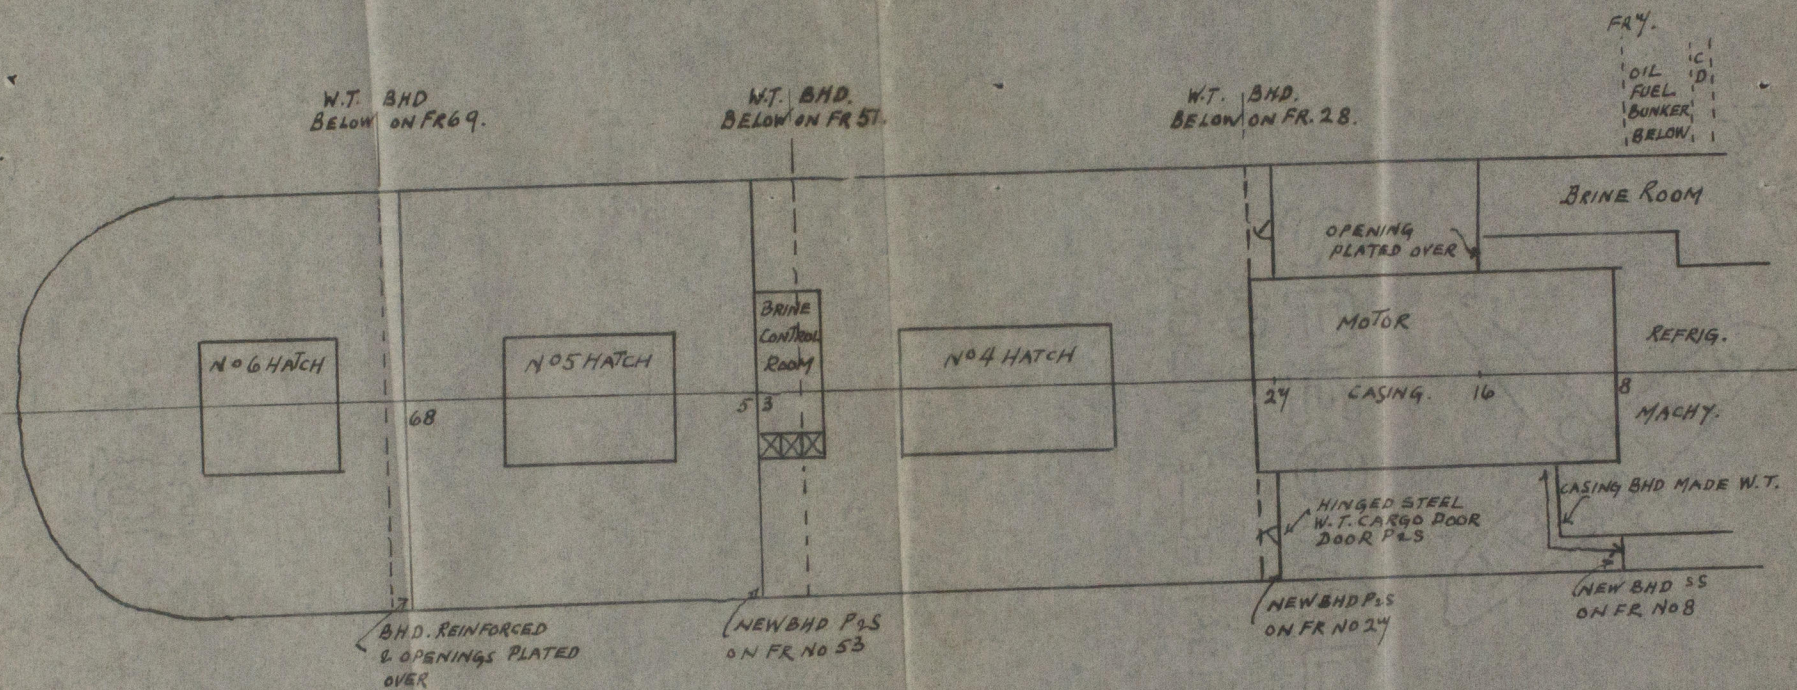

M.V. 'EMPIRE STAR'

SKETCH SHEWING POSITION OF TWEEN DECK  
BULKHEADS NOW FITTED IN AFTER BODY OF SHIP

NOTE IT IS CONSIDERED THAT THE STEEL BHD'S ORIGINALLY  
FITTED IN TWEEN DECKS IN FORE BODY OF SHIP AND NOW  
INSULATED ON BOTH SIDES MIGHT BE ACCEPTED WITHOUT  
BEING MODIFIED. THE M.O. W.T. SURVEYOR HAS BEEN  
CONSULTED AND CONCURS.

© 2020

Lloyd's Register  
W1128 D262



