

For the information of Surveyors and the Committee only.

Received at _____ Office _____ 19

Lloyd's Register of Shipping.

(Report on Vessel No. _____ Port Bideford)

SHIP FORGINGS OR CASTINGS.

I have to report that the undermentioned Iron or ~~Steel~~ Forgings or Castings, manufactured by Messrs J. S. Forster & Sons Ltd Sunderland for the Vessel No. 14, being built British Construction Co of Barnstaple have been inspected by me as set forth below and found to be, so far as can be seen, Sound

ings or Castings.

Lloyd's
2167



D. D. Williamson

Sunderland, 27-5-20




	STERN FRAME.	RUDDER FRAME.	STEM.
...	<u>Scrap Iron</u>	<u>Scrap Iron</u>	/
...	<u>Forged</u>	<u>Forged</u>	
...	<u>6 x 3 1/2 x 5 3/4 x 3 1/2</u>	<u>3 1/2" dia to 3" dia</u>	
Inspection ...	<u>Finished</u>	<u>Forged & Finished</u>	
Inspected	<u>4-2-20</u>	<u>23-2-20 & 26-5-20</u>	
STANDARDS.			
Standard Test Pieces.			
... square inch			
... or cent. ...			
... g Test—			
... fracture			
... ground ...			
Test—			
... rding to Rules / satisfactory ...			

SKETCHES OF FRAMES SHOWING POSITION AND DESCRIPTION OF WELDS OF FORGINGS.

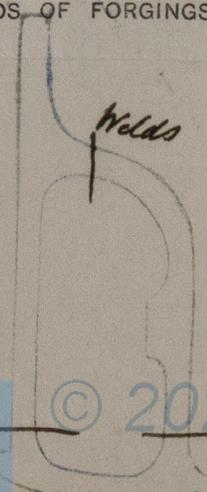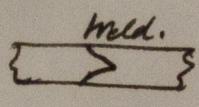

(any chargeable) £
to be paid at ✓

state whether scrap or puddled Iron. If of Steel, state whether made on the Open Hearth process.

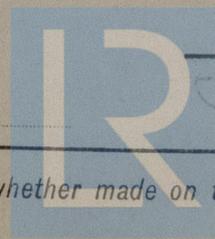

© 2020

Lloyd's Register Foundation

W113-0015