


NOTE:  
HULLS 96-99 & 101-103 INCL., LLOYDS RULES  
HULLS 104 AND 105 INCL. ~~AMERICAN~~  
AMERICAN BUREAU OF SHIPPING RULES, 1912.  
~~DUPLICATE FOR TODD HULLS~~  
~~NO. 8, 17 INCL.~~

PRINTS ISSUED	
PRINT	DATE
1. TACOMA	7-18-17
1. MARSE TOR	10-3-17
4. 1. LOT	11-14-17
1. MARSE TOR	11-16-17
1. TACOMA	12-11-17
2. SHIP YARD	11-28-17
1. SURF CITY	12-28-17
1. SHIP YARD	2-9-18
1. LOT	
2. MR. MICKUM	7-23-18
4. TACOMA	12-13-18
1. 1. MTR	
1. WHEELS	3-13-18
1. SHIPYARD	5-16-18
1. MARSE TOR	5-18-18
5. OFFICE	5-18-18
2. SHIPYARD	7-10-18
1. SHIPYARD	6-11-18
1. SHIPYARD	6-17-18
3. 1. MTR	6-17-18
3. 1. MTR	6-17-18

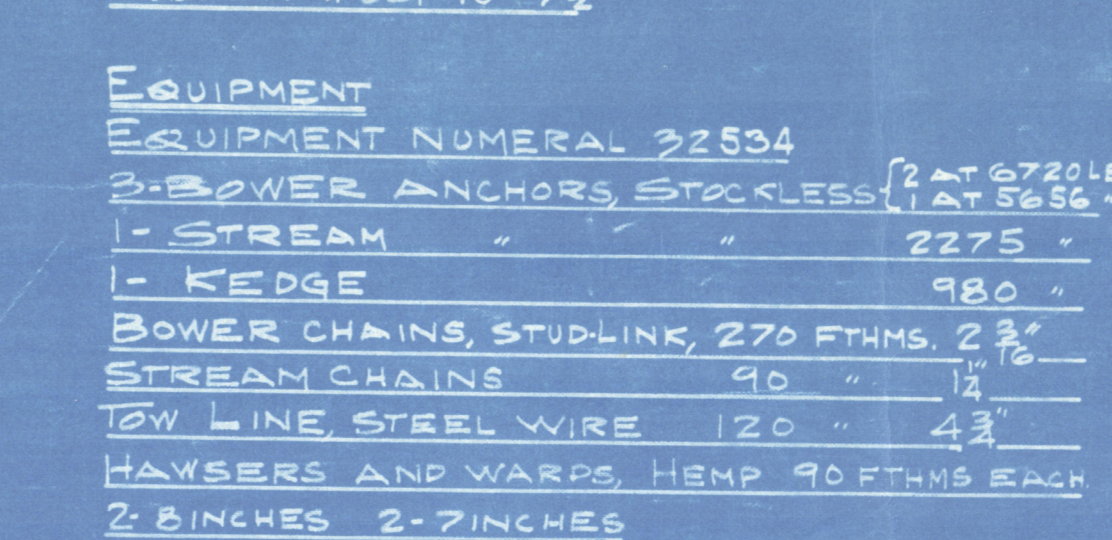

NOTE  
SPACING FOR SIDE BULGE LONGS  
TO BE MAINTAINED FOR EAPTS  
SHOWN.  
LIGHTENING HOLES TO BE KEPT NOT  
LESS THAN 9" CLEAR OF NOTCHES  
FOR LONGS.  
ALL NOTCHES TO HAVE WELL ROUNDED CORNERS  
NO LIGHTENING HOLES TO BE PUNCHED IN  
SIDE TRANS.

Empire Mallard

Lodd Dry Dock & Boat Corp  
Vessel No 101 S/S Anacortes  
Midship Section

Sea 675.

RETAIN



© 2020

Lloyd's Register  
Foundation

W1131-0033