
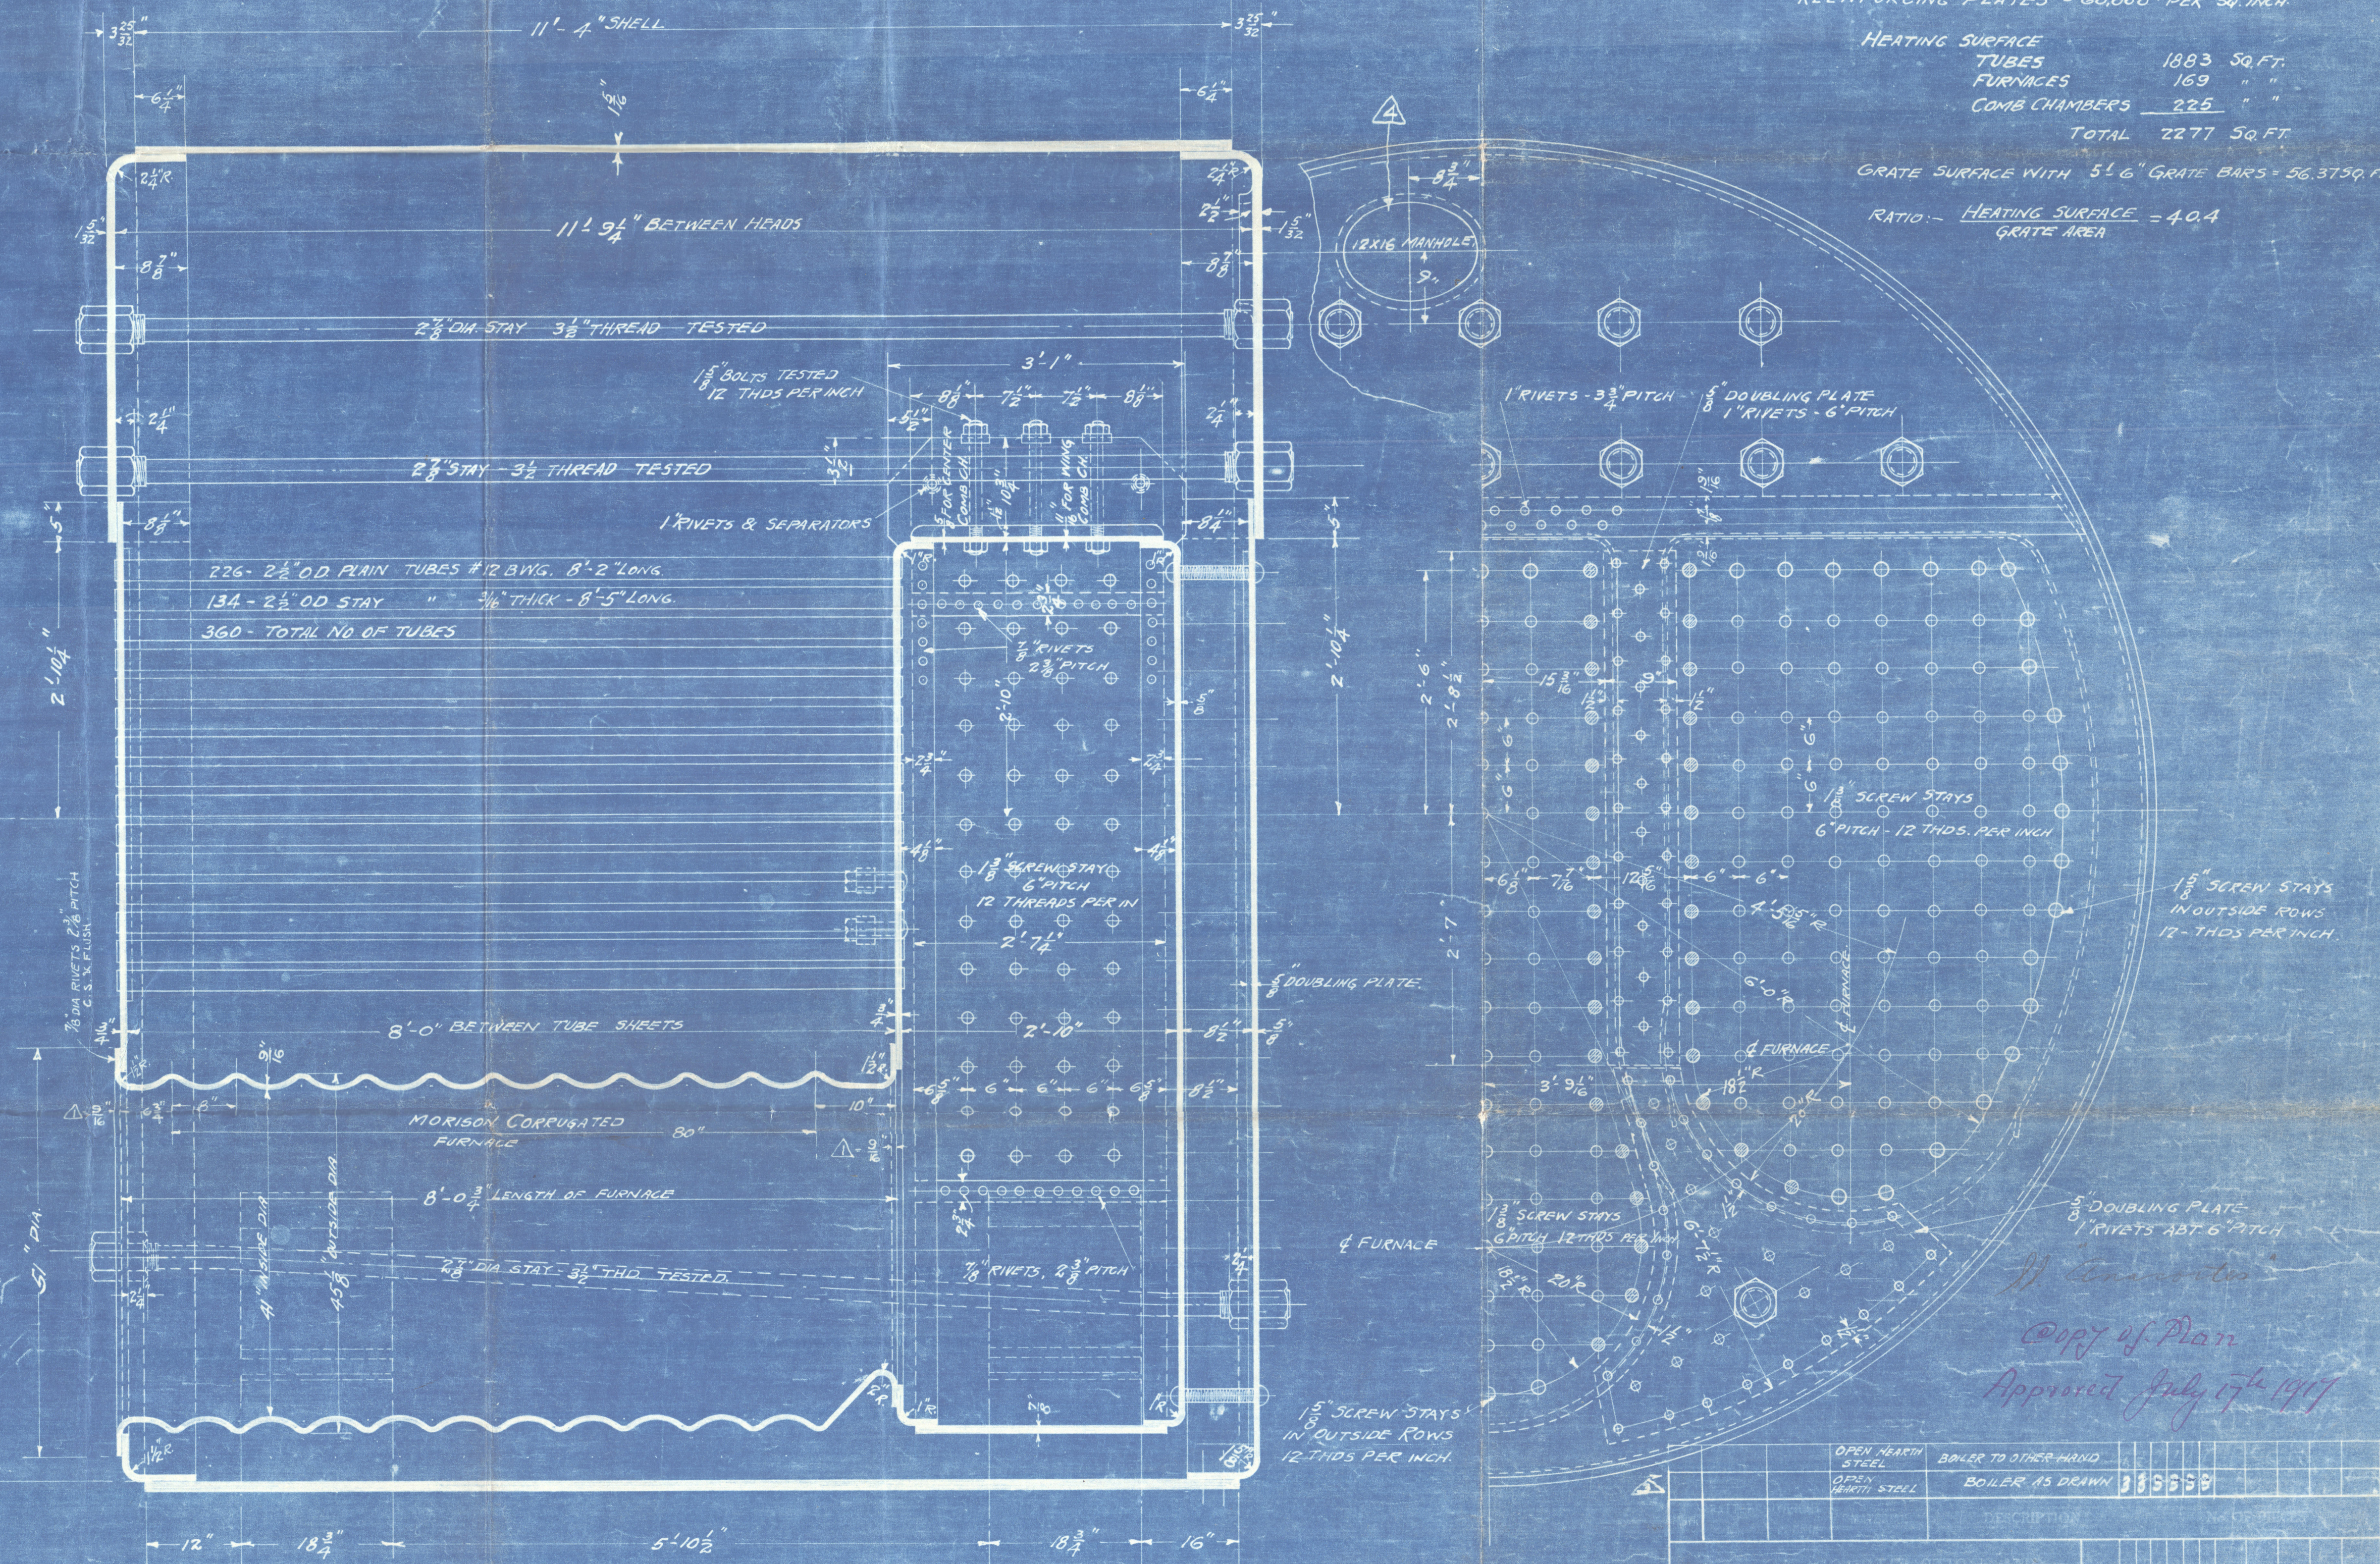
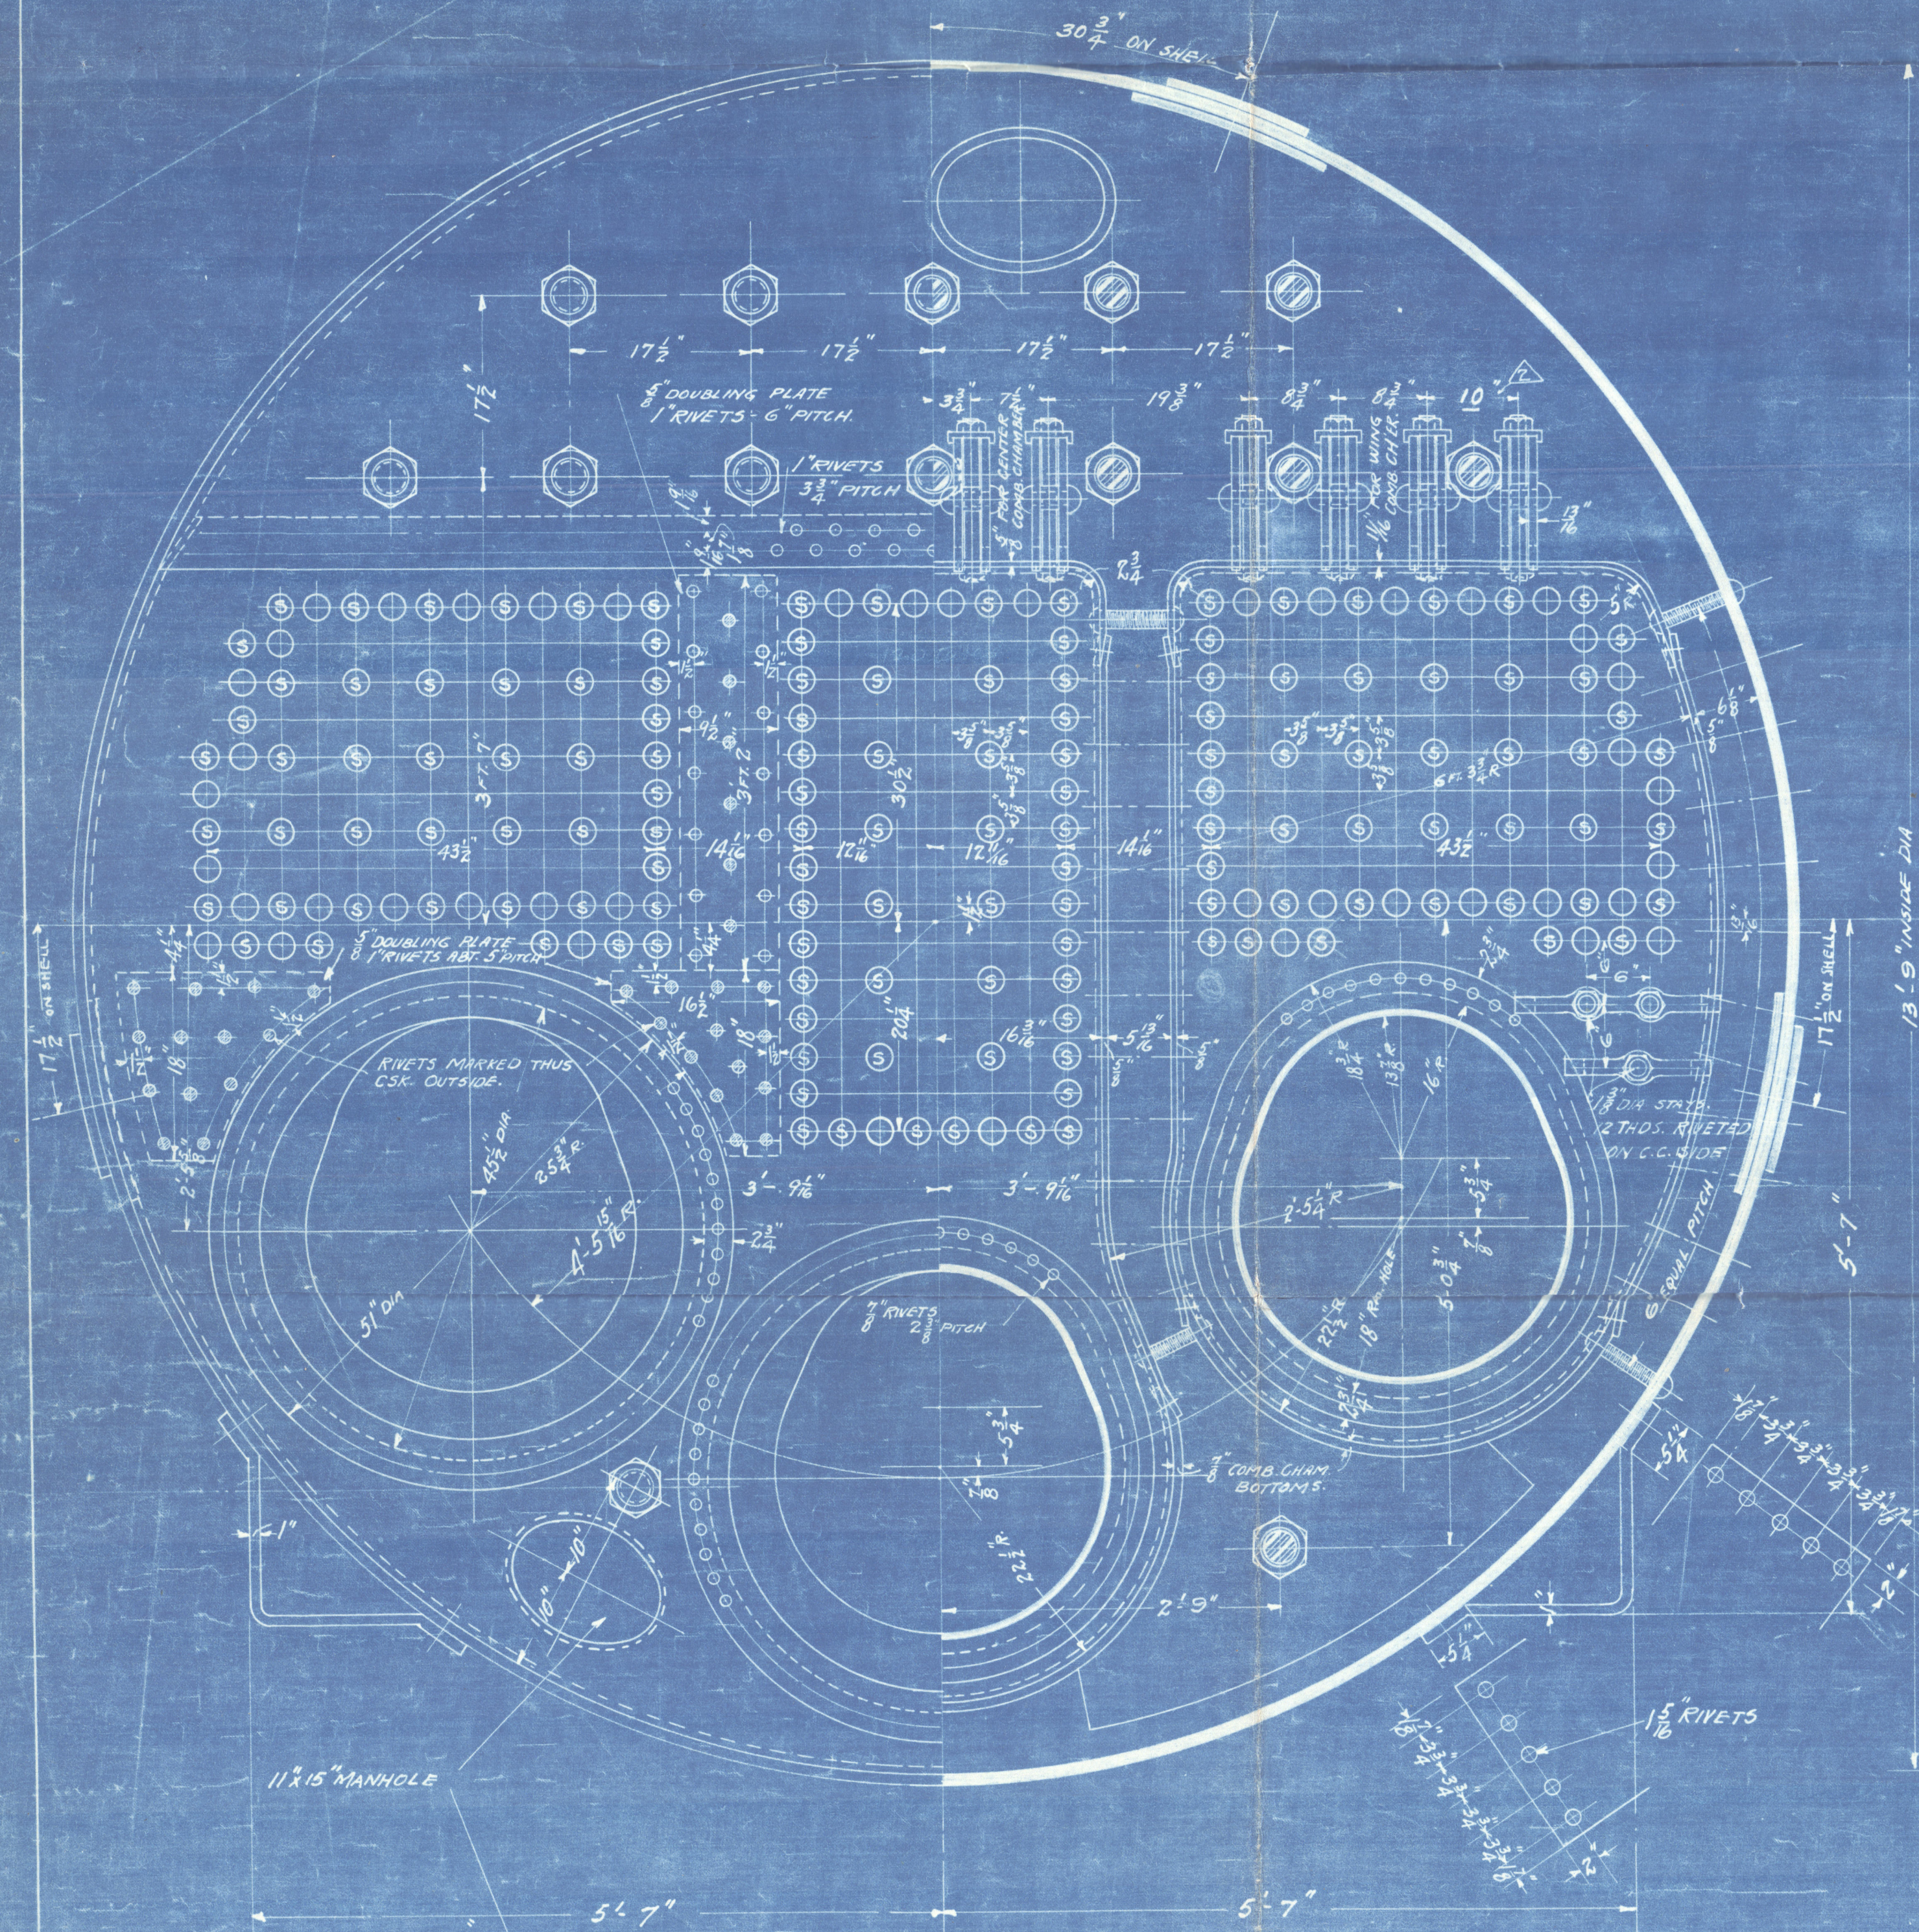


HEATING SURFACE	
TUBES	1883 SQ. FT.
FURNACES	169 " "
COMB CHAMBERS	225 " "
TOTAL	2277 SQ. FT.

$$\text{RATIO:- } \frac{\text{HEATING SURFACE}}{\text{GRATE AREA}} = 40.4$$


W1131-0035

"Empire Mallard"

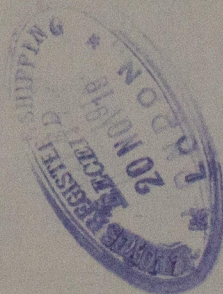

© 2020

Lloyd's Register
Foundation

W1131-0035

"Empire Mallard"

S.S. Anacortes .

Sea. 675.

Boiler plan.

RETAIN



© 2020

Lloyd's Register
Foundation