


# **Nos 463-4** **MIDSHIP SECTION**

**SCALE 3/4" = 1 FOOT**  
**CLASS 100 A1 LLOYDS**  
**- DIMENSIONS -**  
**LENGTH B.P. 142' 0"**  
**BREADTH MLD 25' 0"**  
**DEPTH MLD 12' 7"**

**LLOYDS NUMERALS**  
 TRANSVERSE NO = 37.58  
 LONGITUDINAL NO = 5836.36  
 1/2" TO UPPER DECK = 142/2.58. 11.3  
 1/2" TO R.Q. DECK = 142/6.58. 8.6  
 1/2" TO UPPER DECK = 11.28  
 1/2" TO R.Q. DECK = 15.33

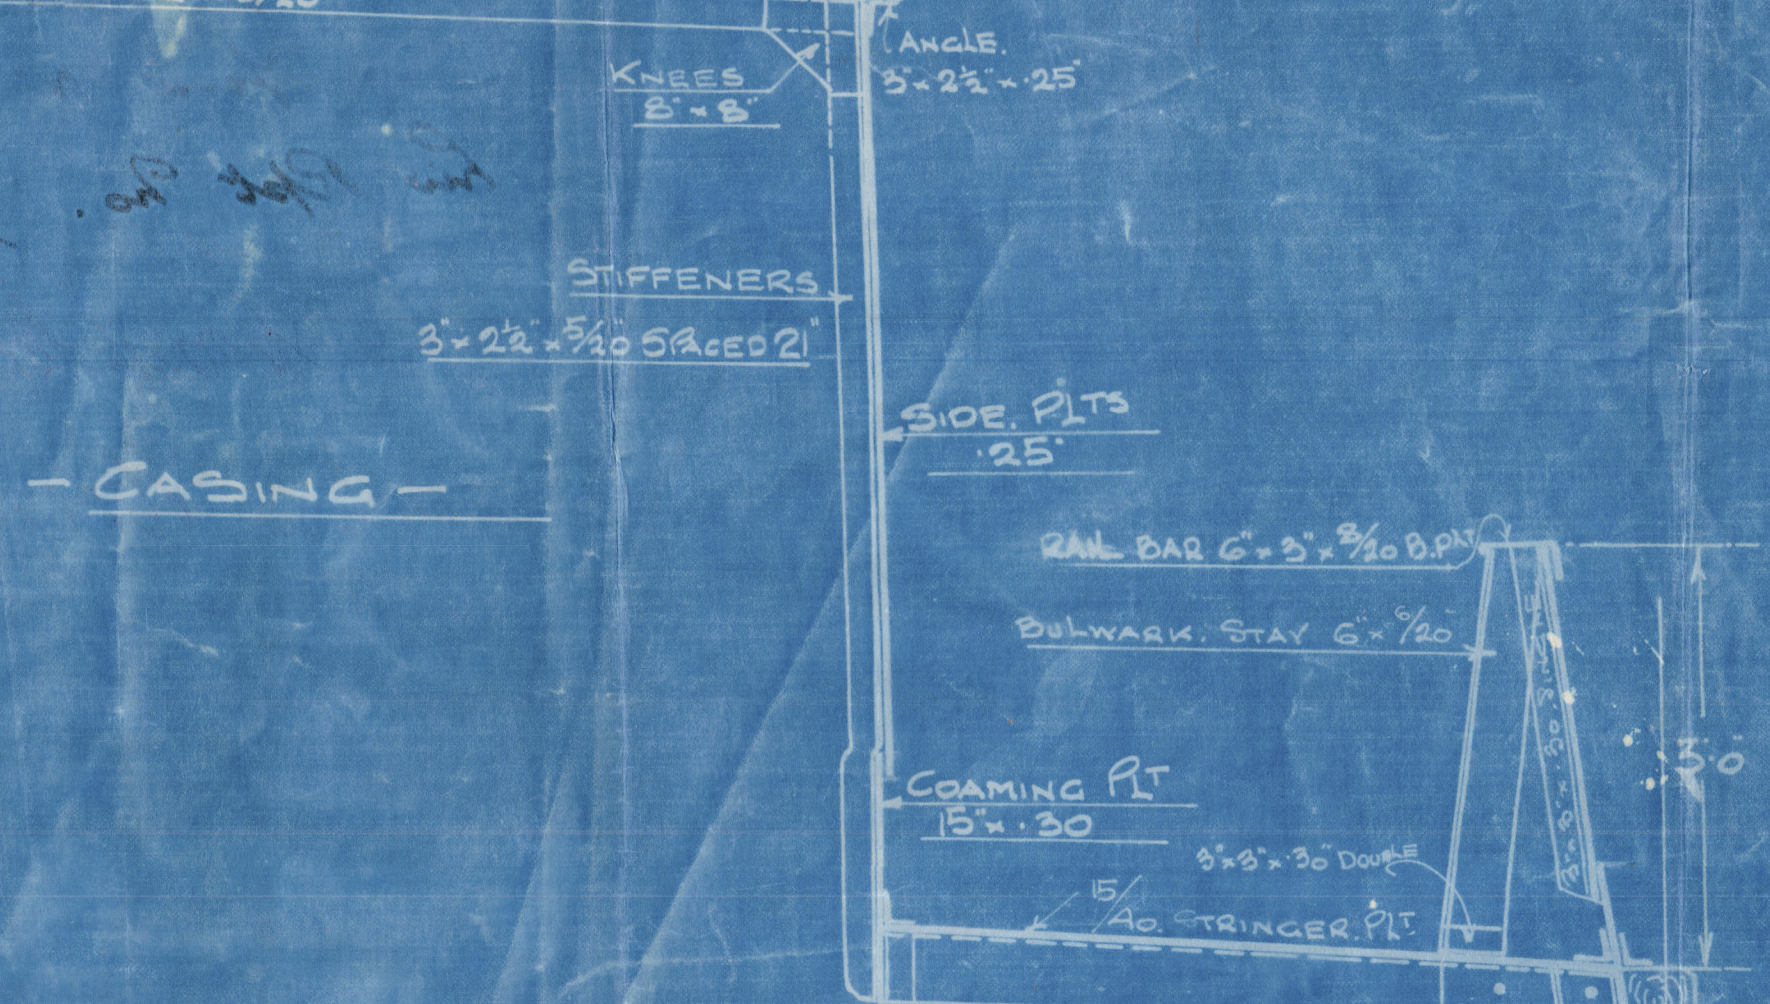

**EQUIPMENT. NO 5960.**  
 2. BOWER STOCKLESS ANCHORS EACH 9CWTs  
 1. STREAM ANCHOR EX STOCK 3"  
 1. KEDGE. " " " 1 1/4"  
 105. FATHOMS 1" STUD LINK MAIN. CABLE  
 15 " 2 3/4" STEEL WIRE  
 30 " 5 1/2" HAWSER  
 75 " 2 1/2" S.W. TOWLINE

**KEEL .52 - .42 AT ENDS**  
**A. STRAKE .34 FOR FULL LENGTH**  
**B. STRAKE .34 FOR 1/2 L TO 30 AT ENDS**  
**C. STRAKE .34 FOR 1/2 L TO 30**  
**D. STRAKE .38 " " .34**  
**E. STRAKE .40 " " .34**  
**F. SHEER STRAKE IN WAY OF MAIN DECK**  
**.40 FOR 1/2 L TO 34 AT END**  
**DOUBLED IN WAY OF BREAK**  
**F. STRAKE IN WAY OF QUARTER DECK**  
**.40 FOR 1/2 LENGTH TO 30 AT END**  
**G. STRAKE .36 FOR 1/2 L TO 30 AT END. .42 AT BRIDGE**  
**BULWARK .25**  
**FORECASTLE SIDE PLATING .32 x .30**  
**DOUBLE FRAMES TO TURN OF BILGE FROM 1/2 L**  
**AMIDSHIPS TO RULE POSITION OF COLLISION B.H.**  
**DECK STRINGER 15/40 - 12/40**  
**PLATING 12/40 STRINGER ANGLE 3" x 30**

**EXTRA KEELSON FROM 1/2 L FORWARD**  
**INTERCOSTAL PLATE 9/20**  
**TOP ANGLE 3" x 3" x 1/20. BOTT ANGLE 3" x 3" x 1/20**

**BILGE KEEL**  
**7/2 x 3/8 B.P.T**  
**5" x 3" x 1/40 ANGLE**



Maritime Section

S. P. Cornish Merchant

Mem J. J. Abada + Initialed

Yara N° 463

Rev Rpt No. M/M-1132

"Fawcett Rose"

S. S. Cornish Merchant

LIVERPOOL

Report No. 86169

W1132-0087

Maritime Section

Abada + Initialed

463



© 2021

Lloyd's Register  
Foundation