

30 4 20


DIMENSIONS

LENGTH B.P. = 142'-0"

BEAM M^{LD} = 25' - 0'

DEPTH " = 12' - 7"

SCALE $\frac{1}{4}$ - 1 FOOT

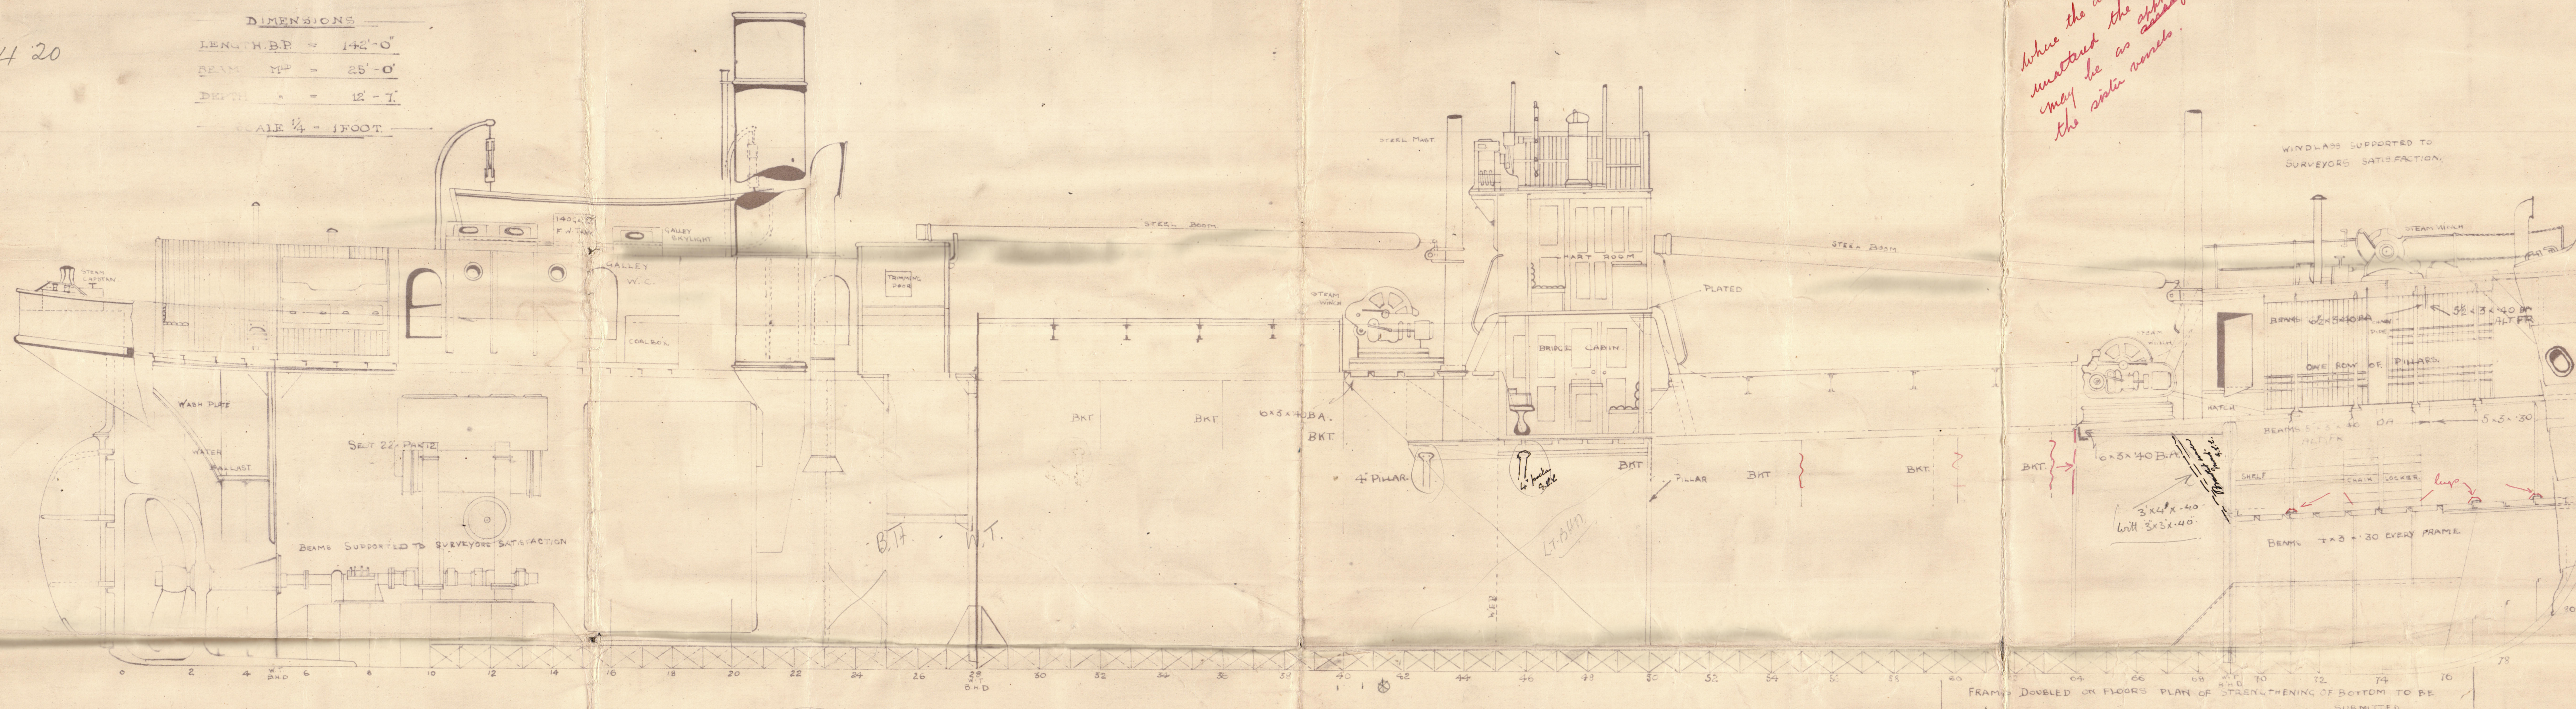

where the arrangements are
unattended the detail plans
may be as ~~shown~~ ^{arranged}
the sister novels.

YARD № 463-4

ISAAC J ABDELA MITCHELL LTD
SHIPBUILDERS & ENGINEERS
QUEENFERRY, CHESTER

Recd. Liverpool
27. 4. 20

R.M.M.
30.4.20



Lloyd's Register
Foundation
W1132-0089

General arrangement

No 463-4

Adela Mitchell

"Fowey Rose"

S.S.

ex Cornish Merchant

LIVERPOOL

Report No.

P/169

M/M 1132



© 2021
63

Lloyd's Register
Foundation

W1132-0034