

22. 11. 07
23. 12. 07.
7. 1. 08
17. 1. 08
31. 1. 08

LOYDS NUMBERS			
DEATH	31.46		
1 BIRTH	22.4		
2 BIRTH	52.89		
	109.99		
DEATH	7.35		
	102.44	EXCESS NUMBER	
	386.6		
LONG	39770	PLATING NUMBER	
EQUIPMENT NUMBER			
HILL	109.99	356.6	- 4237.6
POOP	94.92	7.5 x 1.5	- 105.9
BIDGE	27.05	7.5 x 1.5	- 305
			- 454
FORECASTLE	40.35	7.5 x 1.5	-
EQUIPMENT NUMBER			44303

2 BOWER ANCHORS 60. CMT STOCKLESS.
1. " ANCHOR 503. " ✓
1. STREAM " 164. " Ex STOCK ✓
1 KEDGE " 7. " ✓
270. FATHOMS 2 3/4" STUO CHAIN CABLE ✓
90. " STEEL STRAIN WIRE 4 3/4 ✓
120. " WIRE TONLINE 4 1/2 ✓
2. MARILLA HANSEAS 8" EACH 90. ✓
2. " " 7 1/2 " 90 ✓

ALL PLATING AND FRAMING JOGGLED WHERE PRACTICAL
EXCEPT SHELL AND EXPOSED WEATHER DECK.







C.B.
22.11.07

SWAN, HUNTER & WIGHAM RICHARDSON, LTD.
SHIPBUILDERS & ENGINEERS
DATE NOVEMBER 20TH '07.
PLAN No. 16312
WALLSEND SHIPYARD
WALLSEND, N-TYNE

S. H. H. R. W1134-0207

Section

815-

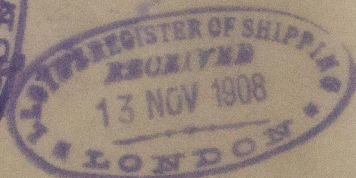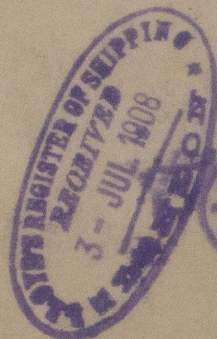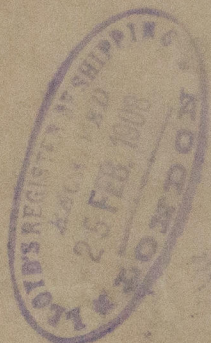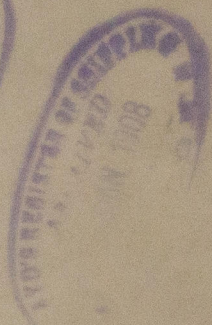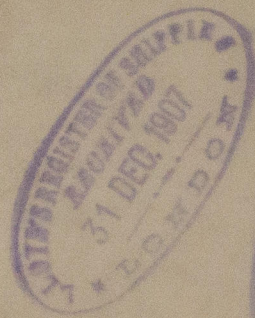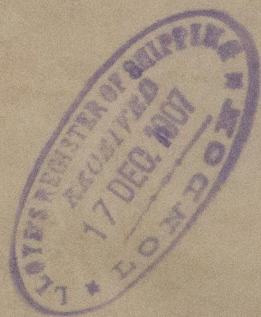

S.S. "Cheryenne"

Newcastle Report

N^o 55920

RETAIN



© 2020

Lloyd's Register
Foundation