
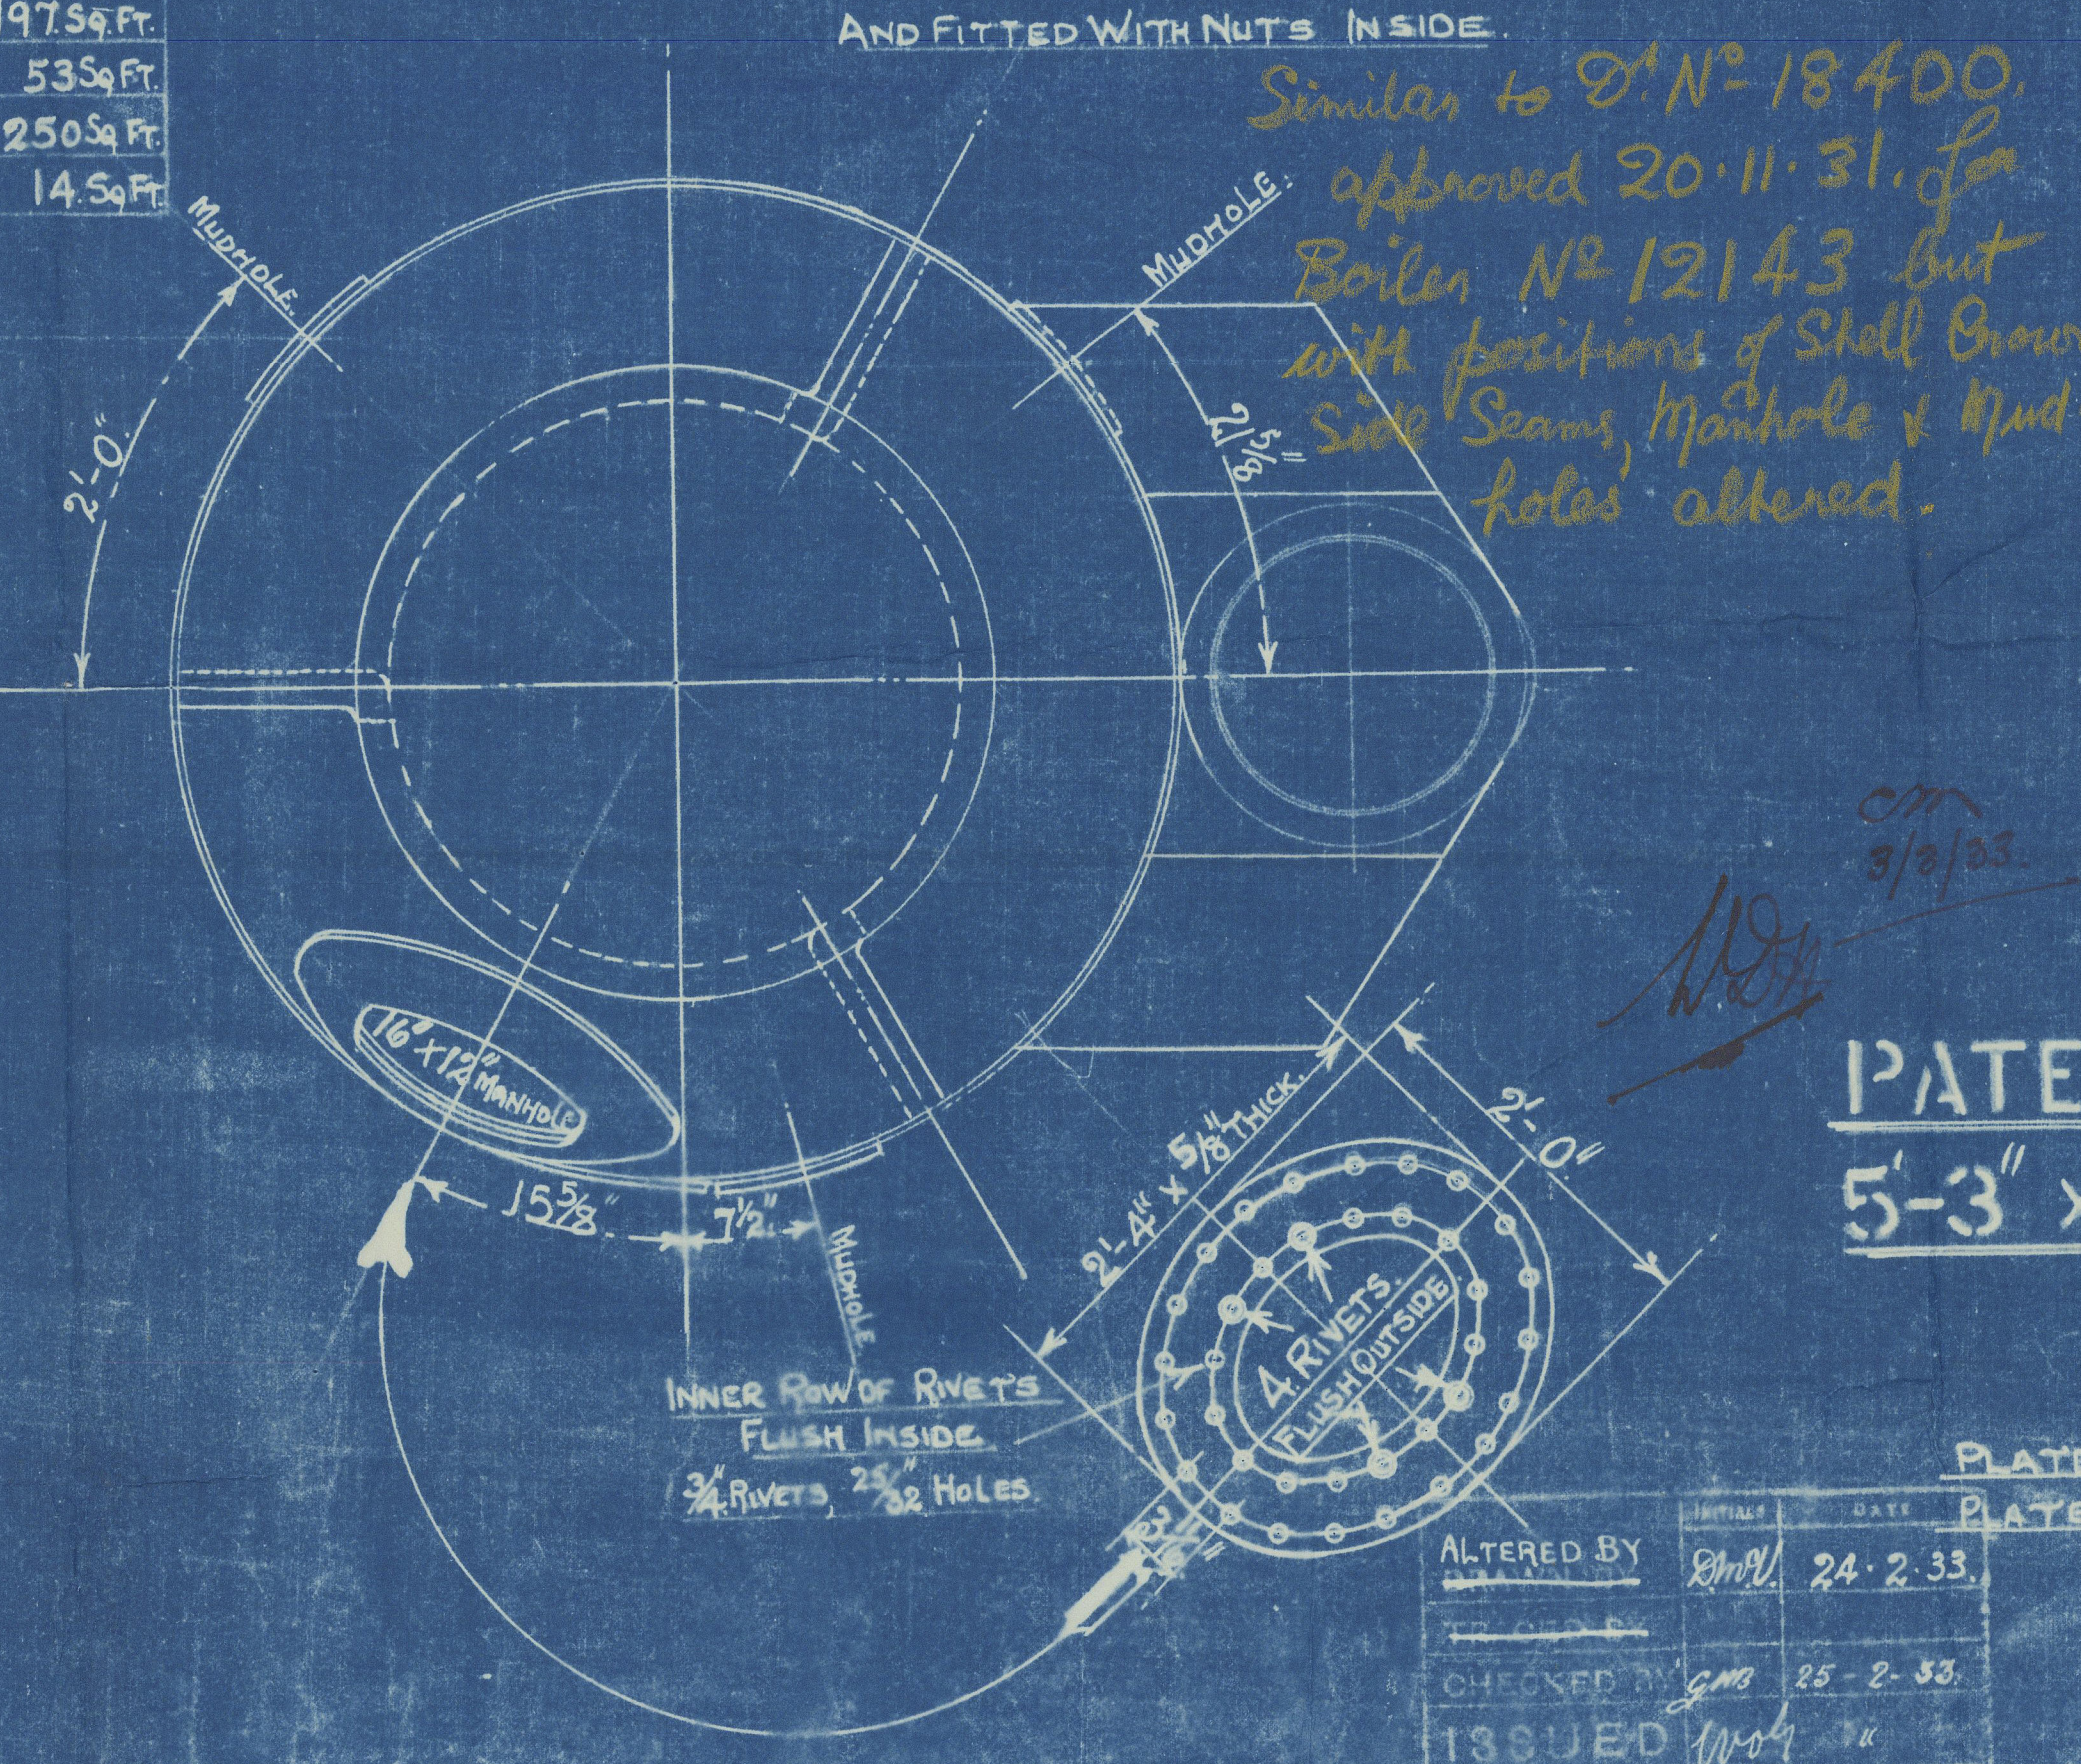
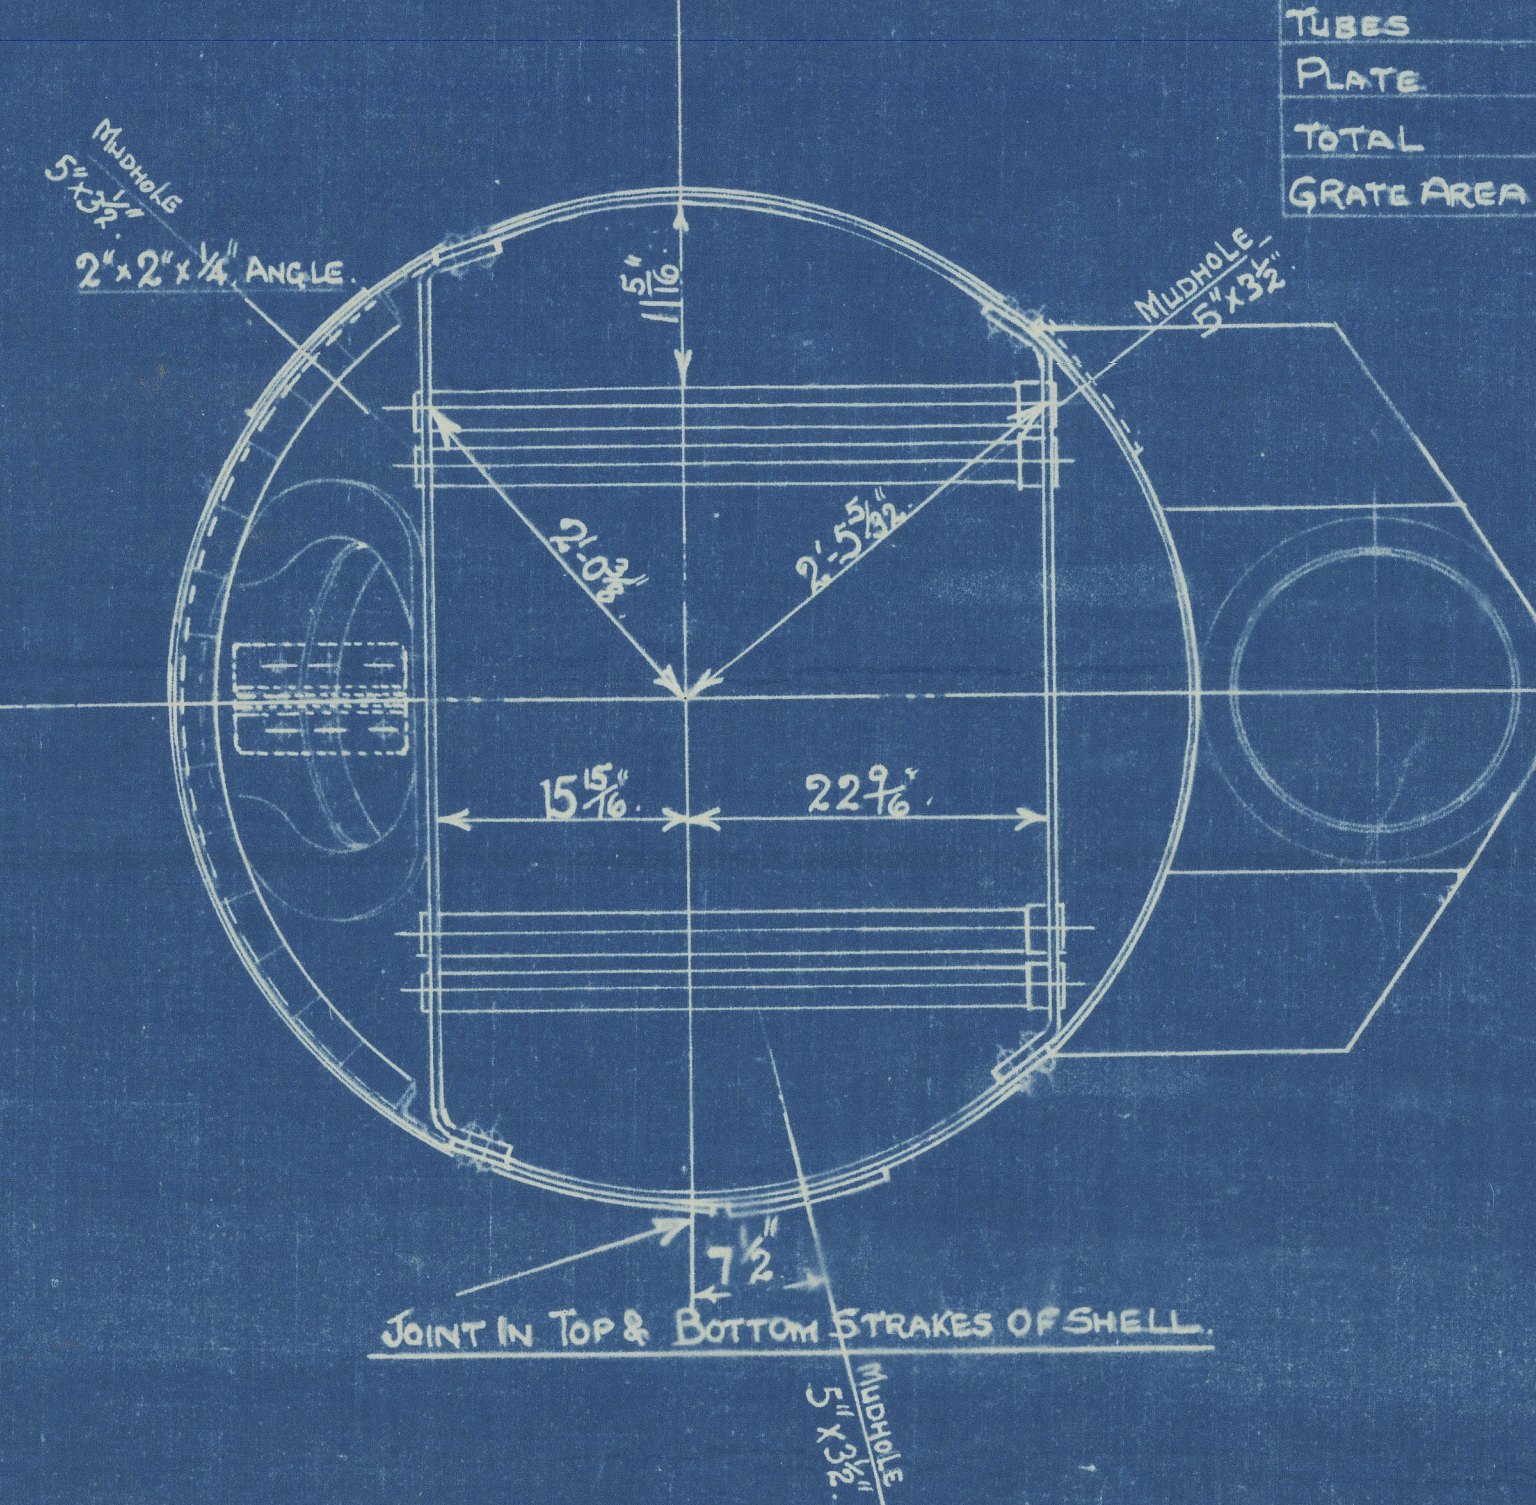
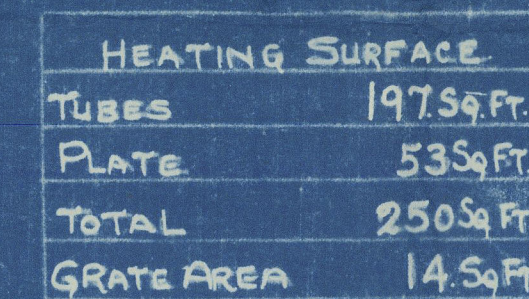


HORIZONTAL FLUE TUBES

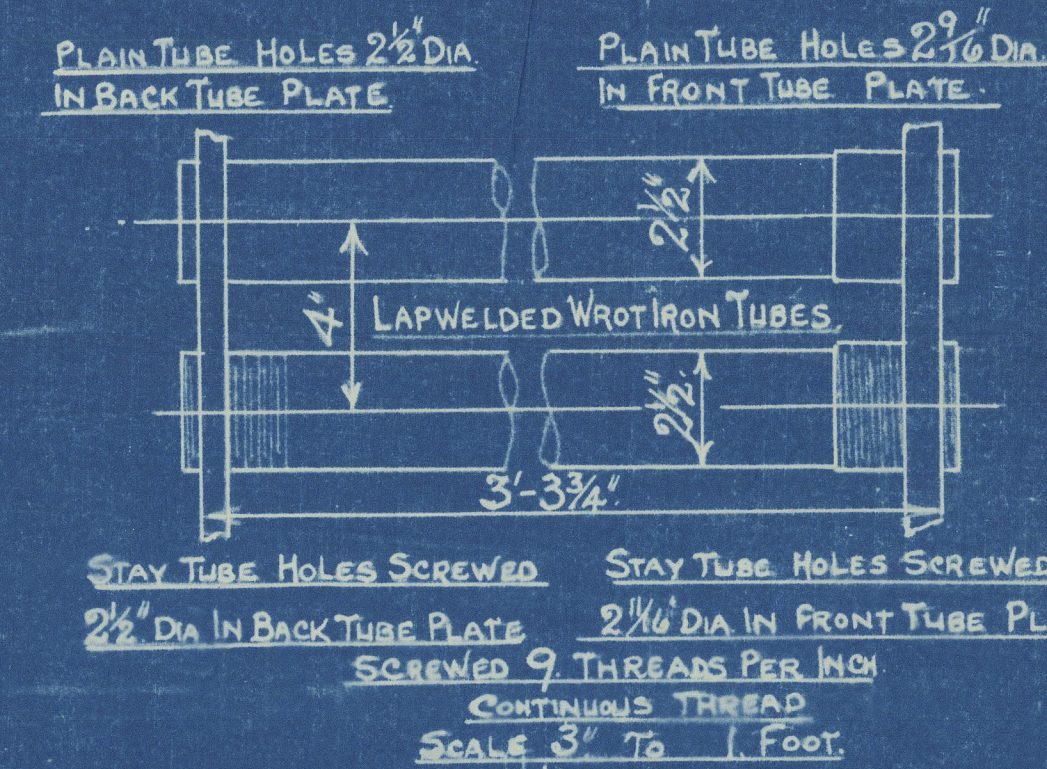

NHP - 25

EVAPORATION FROM AND AT 21.2°F

5'-3" x 11'-9" x 250 # HS x 100 LB. W.P.

SCALE 1 INCH TO 1 FOOT.

SIEMENS MARTIN MILD STEEL PLATES.

TENSILE TESTS.

PLATES NOT EXPOSED TO FLAME OR FLANGED 28 TO 32 TONS

PLATES EXPOSED TO FLAME OR FLANGED & PIVETS 26 TO 30 TONS

DRAWING NO. 19708.

SURVEY-LOYDS.

COCHRAN & CO., ANNAN, L.D.

Boiler No. 12463

Drawing No. 19708

WP-100H

GLASGOW REPORT No. 53537

D. Rowan & Co.

Contract N^o 959

Mark

No 19232

LLOYD'S TEST

200LBS

100 " WP

JH 26/5/33

PULBOROUGH.

OW

RETAIN



© 2020

Lloyd's Register
Foundation

W1135-0235