49,024. Pelton. 90/1925 Hull

For the information of Surveyors and the Committee only.

Received at 11 APR 1925 Office 19

Lloyd's Register of Shipping.

(Report on Vessel No. 36459 Port Hull)

SHIP FORGINGS ~~OR CASTINGS~~.

have to report that the undermentioned Iron ~~or Steel~~ Forgings ~~or~~ ~~s~~, manufactured by Messrs J. S. Forster & Son Ltd Sunderland for the Vessel No. 474, being built k Wellon & Gemmell Ltd of Beverley n inspected by me as set forth below and found to be, so far as can Sound

~~ings~~.

D. D Williamson

6-4-25 Sunderland. 5-4-25

	STERN FRAME.	RUDDER FRAME.	STEM.
...	Scrap Iron		
...	Forged		
...	6" & 3½"		
...	Forged & Finished		
(	3-4-25 to 6-4-25		

RAMES SHOWING POSITION AND DESCRIPTION OF WELDS OF FORGINGS.

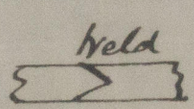

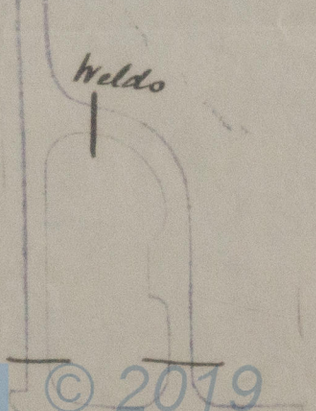

ble) £ : :

ap or puddled Iron. If of Steel, state whether made on the Open Hearth process.

© 2019 Lloyd's Register Foundation

WR37-0030

ngston-upon-Hull. -- Manager --.