

SCALE $\frac{1}{2}$ INCH = ONE FOOT.



W1138-0117


The GUTHRIE & SONS

No 387

S.S. "War Briton"

Profile & Deck Plans
as built

Genl Rept No 17344

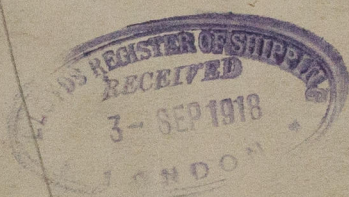

St. Agnes

War Wreck

RETAIN



© 2020

Lloyd's Register
Foundation