
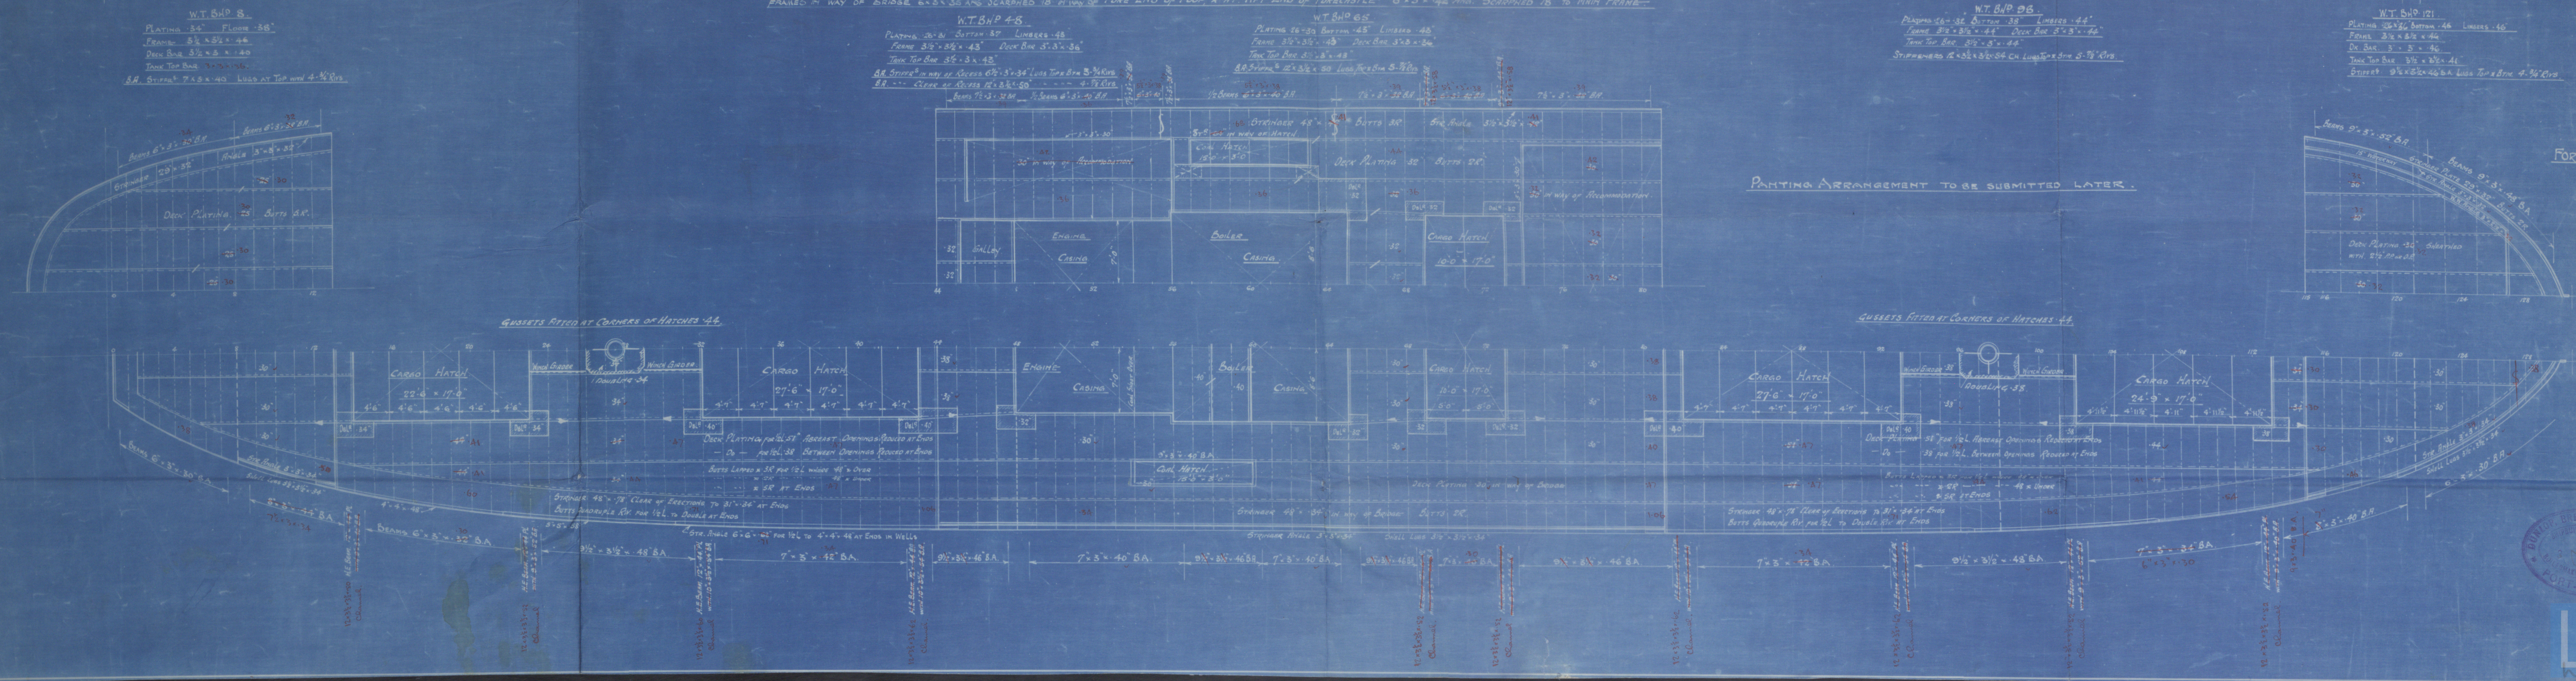


N^o 350-1 PROFILE & DECK PLANS

SCALE - 1/8" = 1 FOOT.

LENGTH ON LWL 312'-0" x 46'-11" x 23'-4 3/4" MLD.
 TO CLASS 100 A1 AT LLOYDS FULL SCANTLING VESSEL.

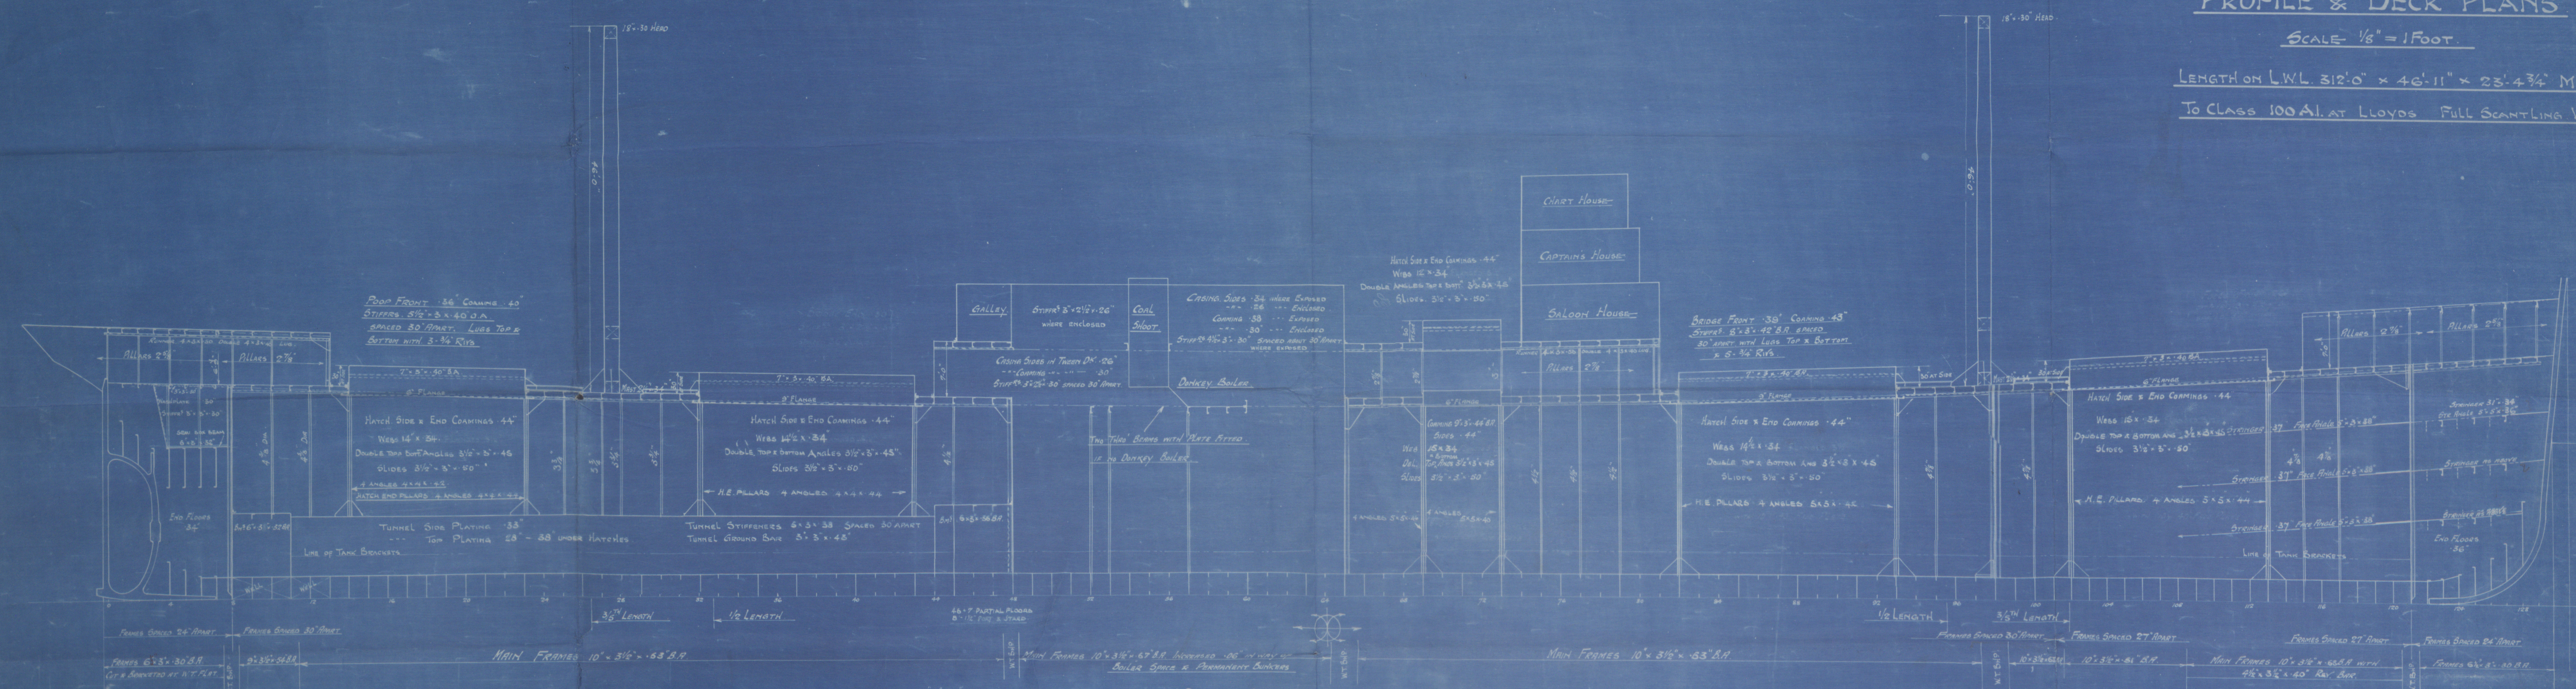

Dunlop Bremner.

Dunlop Bremner & Co.

N^o 350.

S. S "QUERCUS"

Profile & Decks.
(as built).

Grk Rep L^o 18530.

RETAIN



© 2020

WU 39 - 0063

Lloyd's Register
Foundation