






COOK WELTON + GEMMELS

N<sup>o</sup> 359-60-1-2-~~3~~+~~4~~

PROFILE

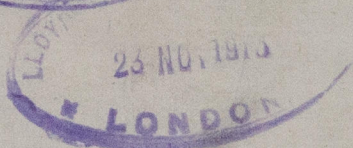

1/5 Remind<sup>o</sup> Bull Rpt No 29875

1/5 Refundo Hull Rpt No 30070

- John Birmingham - - - ~~30077~~

1/5 Remindo - - - 30,147


3634 4 cancelled see amended plans

W114-0018 Foundation