

© 2020  
DATE SUBMITTED: FEB 5<sup>TH</sup> 1916  
LLOYD'S REGISTER  
FOUNDATION  
114-0019




COOK WERTON & GEMMELL

N<sup>o</sup> 359-60-1-2-3+4

MIDSHIP SECTION

\* Remilo Hull Rpt No 29875  
2/3 Refundo Hull Rpt No 30070  
2/5 Remundo - 30,147  
" Resercho - 30,182

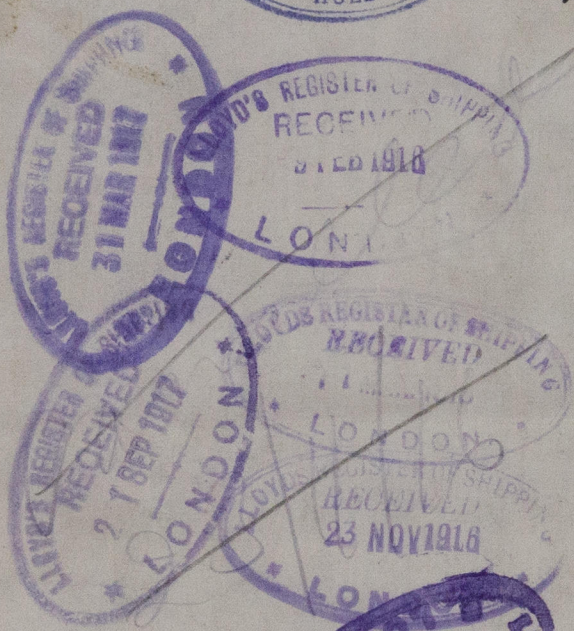

363/4 Cancelled see amended plans

W/114-0019



© 2020

Lloyd's Register Foundation