




— PROFILE NOS 465 -8.—  
— DIMENSIONS :- 440' B.P x 56'-9" x 33'-11" M<sup>LD</sup> TO UPPER DECK.—

SCALE 1/8" = ONE FOOT.

 

\* OWNERS EXTRA SCANTLINGS  
TANK TOP & FLOORS UNDER BOILERS INCREASED 15 IN THICKNESS WITH  
AN ADDITIONAL 10 INCREASE ON FLOORS UNDER BOILER BEARERS  
E.R. FLOOR CORNERS 18-25 (INC) TO KEEL TO BE DOUBLE.  
THE SCANTLINGS SHOWN ON THIS PLAN DO NOT INCLUDE ABOVE INCREASES.

\* TANK TOP PLATING  
MID. STRAKE 46x52 WES 1/4 58 IN B.S.  
OTHER STRAKES 52 WES 1/4 58 IN B.S.

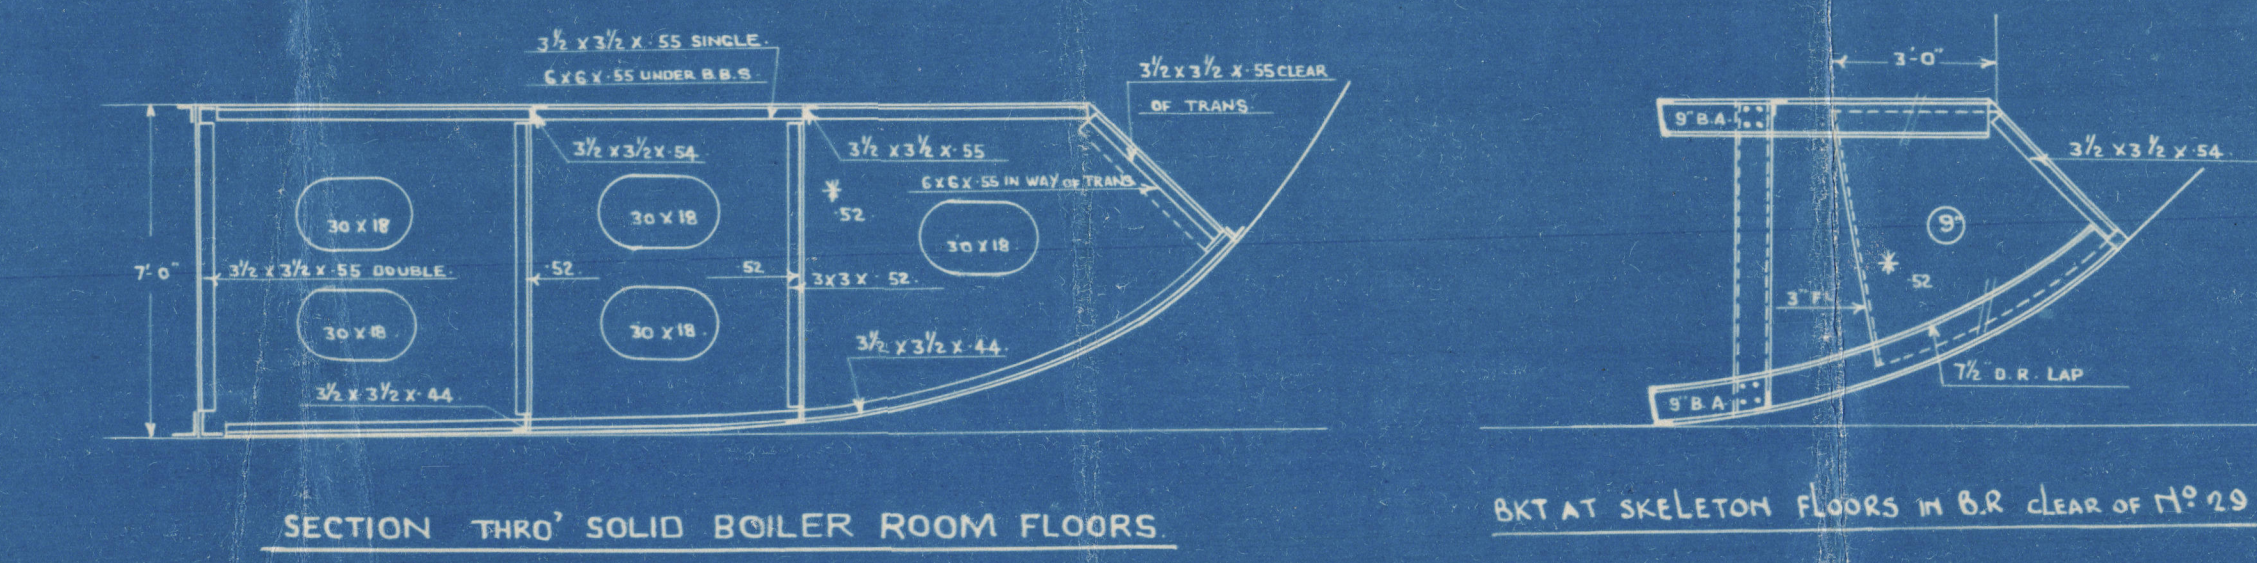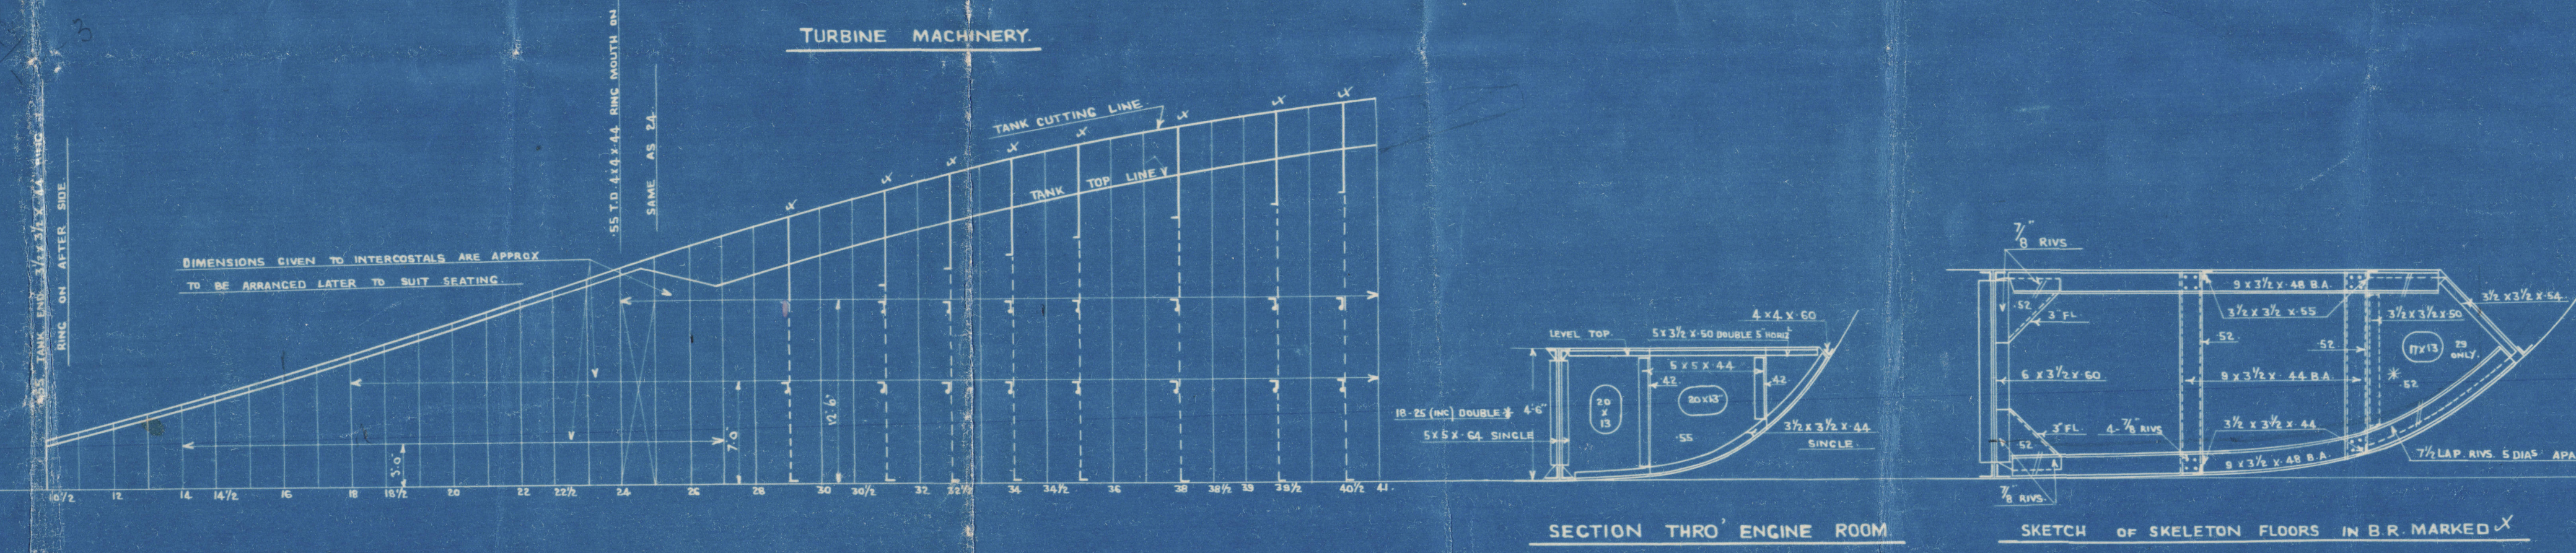

W140-0130



W1140-0170

Amended Profile  
Workman Clark 8/00 hrs.

465-8

S. B. Workman

Blf 8134

© 2020

Lloyd's Register  
Foundation