



28/8/24

 

Profile a Deck plan
for Nakslov Skibsværft's
Yard No. 26. +28

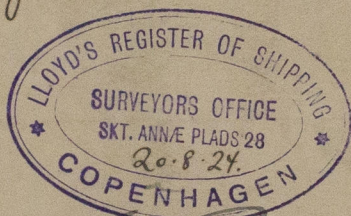

1/3 Tacoma

+ War Wreck

(Astoria)

RETAIN



© 2020
W1142-0093

Lloyd's Register
Foundation