

19/8/25

SHIP No 26 28

MIDSHIP SECTION

EQUIPMENT NUMBER

2ND LONGT. NUMBER 33915

FORECASTLE DECK 180

DECKHOUSE AND CASING 417

34512

LENGTH BETWEEN APAS PER RULES 380'-0"

BREADTH MOULDED 53'-3"

DEPTH TO SECOND DECK 28'-0"

TO UPPER DECK 36'-0"

DRAUGHT LOADED Summer moulded draught 25'-0" 26'-6"

L/D = 380 ÷ 36 = 10.555 FIRST LONGITUDINAL NO

L × (B/D) = 380 × (53.25 ÷ 36) = 43915 SECOND

B/D = 53.25 ÷ 36 = 1.48

α = 2.32

2.32

2 OFF STOCKLESS ANCHORS EACH 60 CWT

1 --- --- 50# ---

1 --- STREAM --- 16# CWT + 25% STOCK

270 FATH 2 3/4" STUO CHAIN CABLES MIN. WEIGHT 645 3/4 CWT

30 --- 4 3/4" STEEL WIRE

120 --- 4 3/4" ---


2 OFF 90 FATH 8" MANILA OR 2 3/4" STEEL WIRE

2 OFF 90 FATH 7" --- OR 2 1/2" ---

CLASS: LLOYD'S REGISTER 100 AT WITH A FREEBOARD
 CORRESPONDING TO A DRAUGHT NOT EXCEEDING THAT CONTEM
 PLATED BY THE RULES FOR A COMPLETE SUPERSTRUCTURE VESSEL.

MATERIAL: STEEL WITH STEEL RIVETS.

SCALE 1/2" = 1'-0"

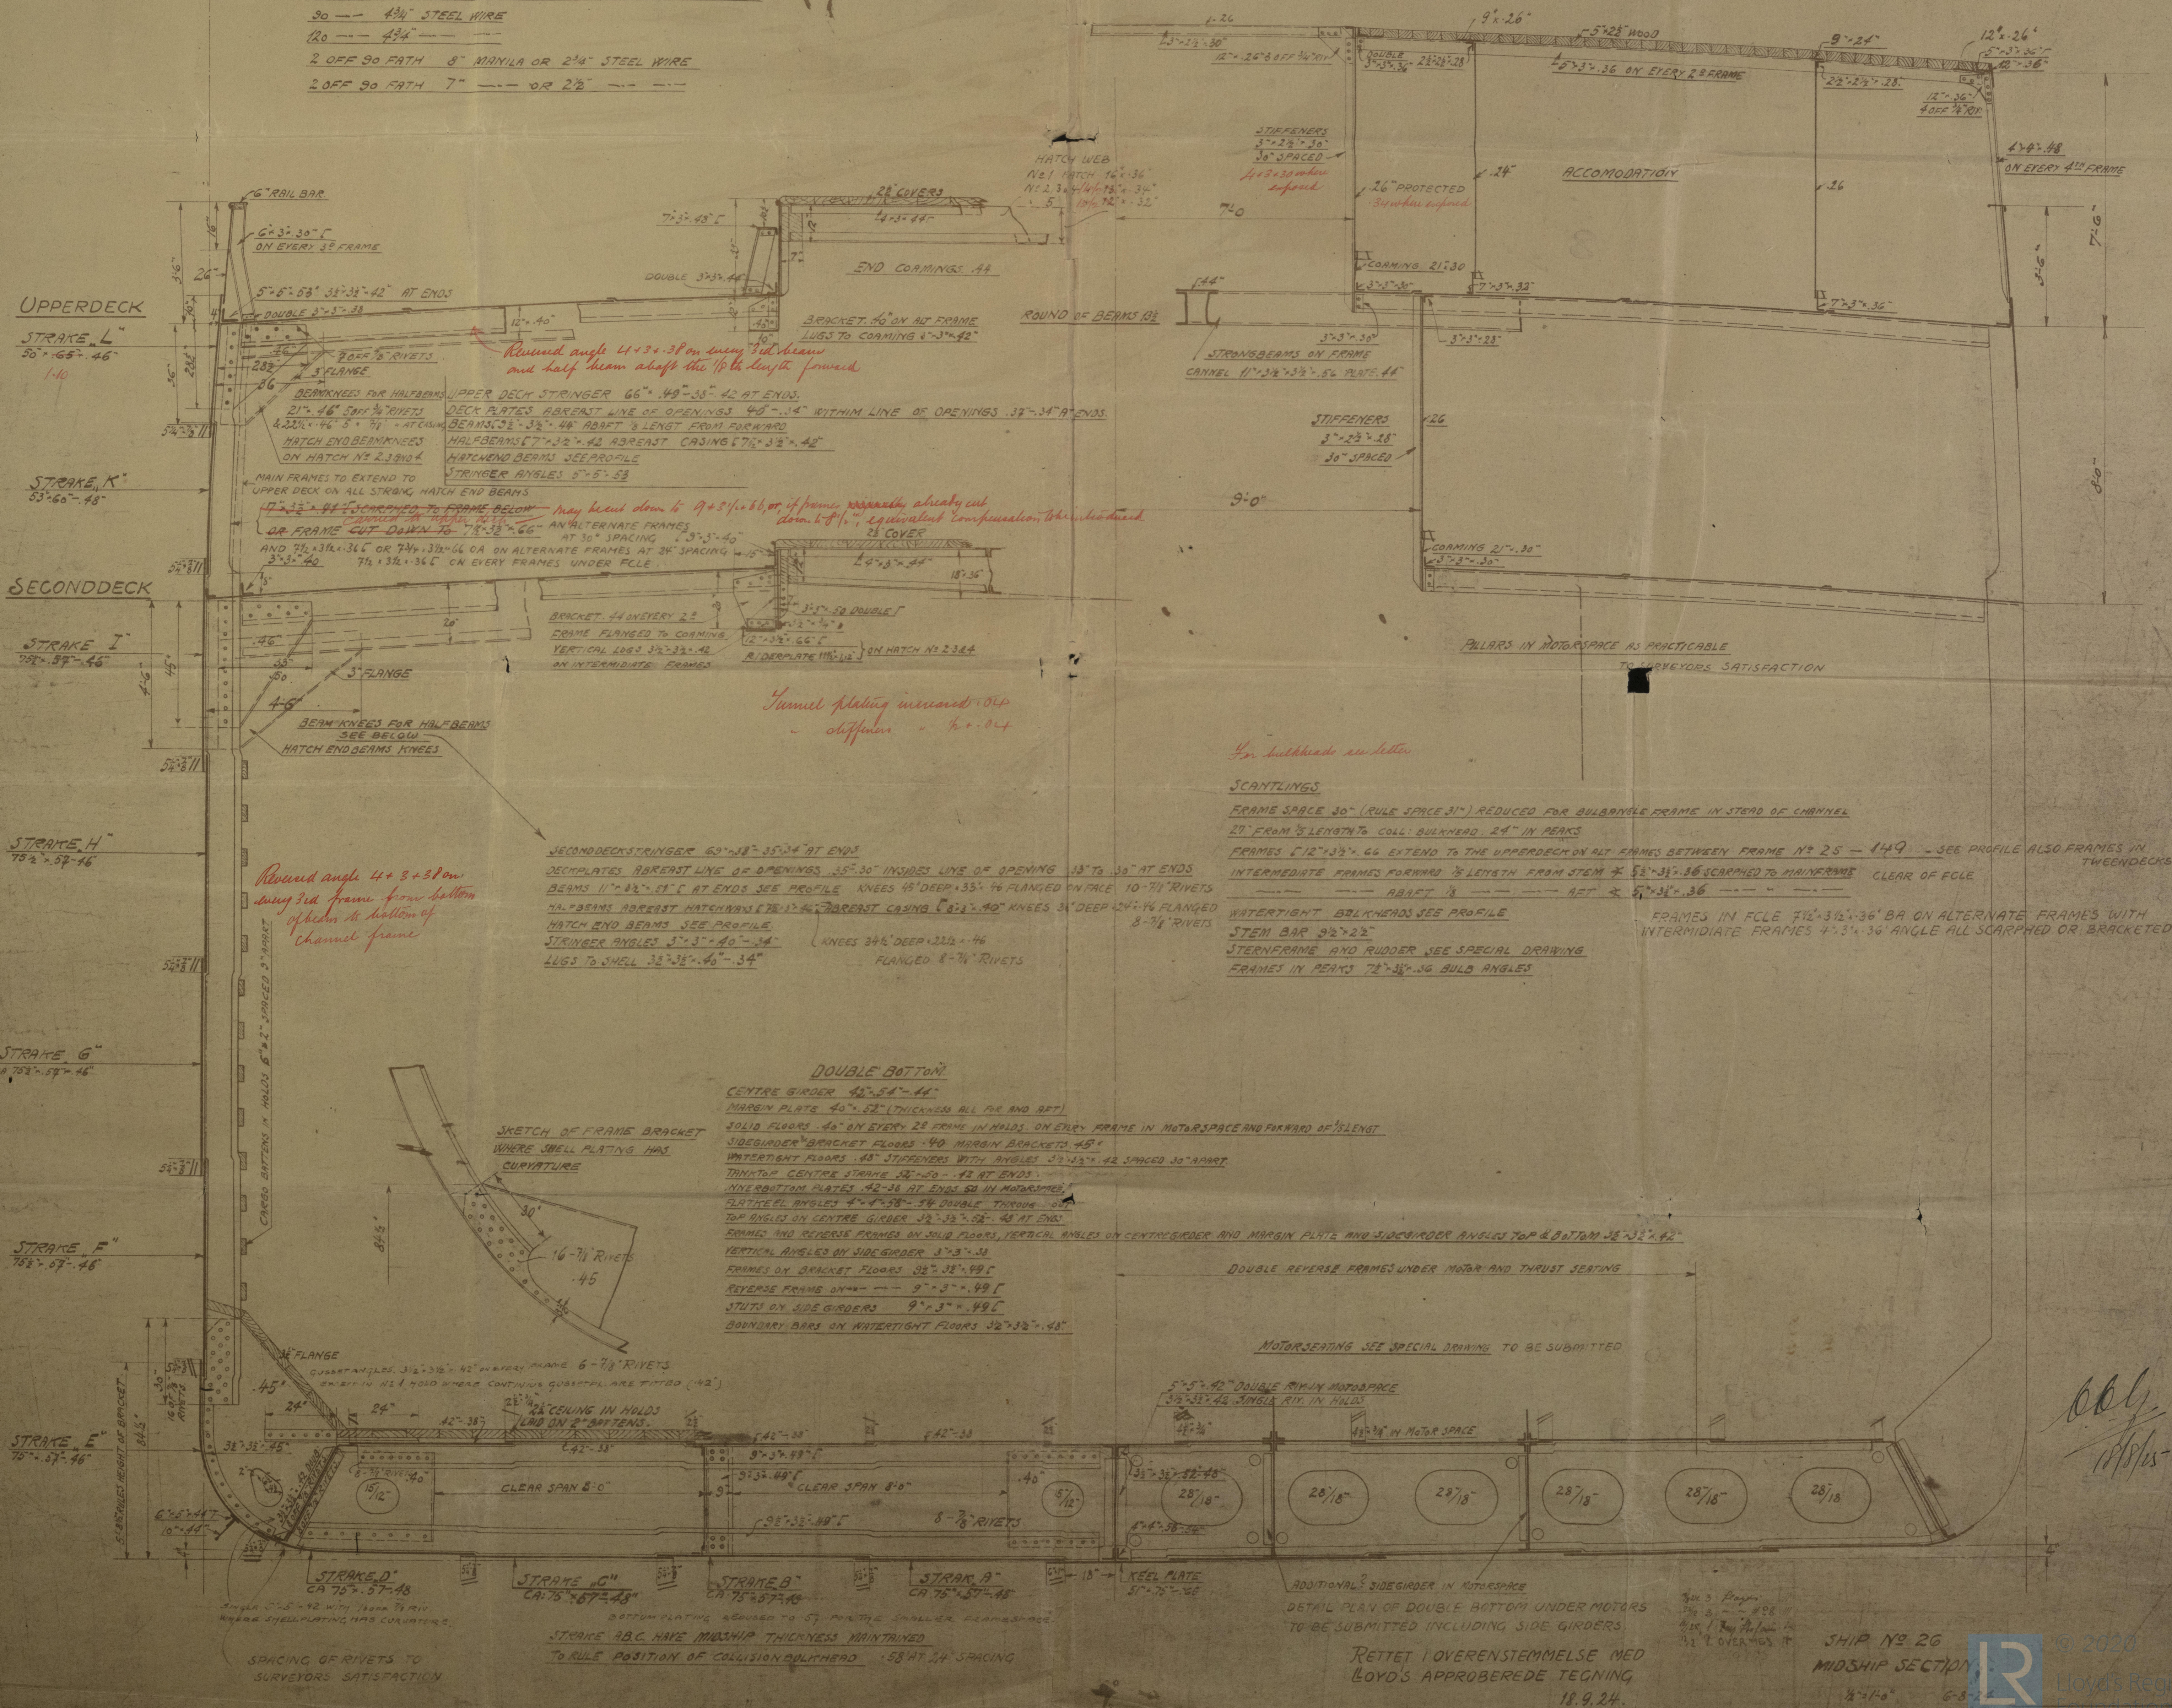

MIDSHIP SECTION

NARSKOV N^o 26, 28

15.8.28

SURVEYORS OFFICE

SKT. ARBEJDE 1928

al. 138.

2/3 Tacoma

RETAIN



© 2020

Lloyd's Register
Foundation

W1142-0094