

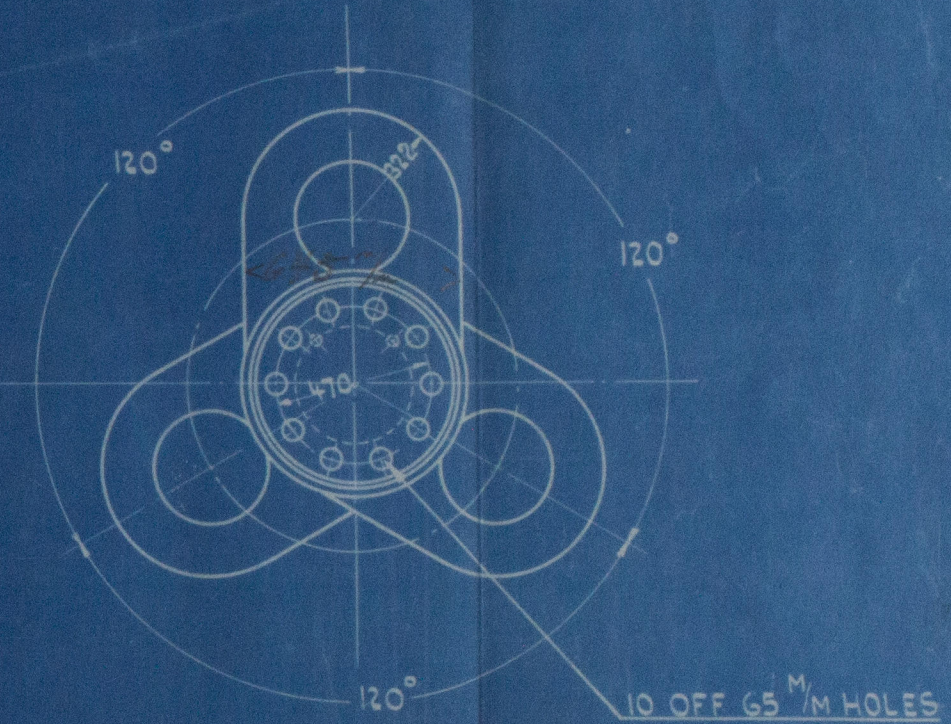


90829

22/8/25

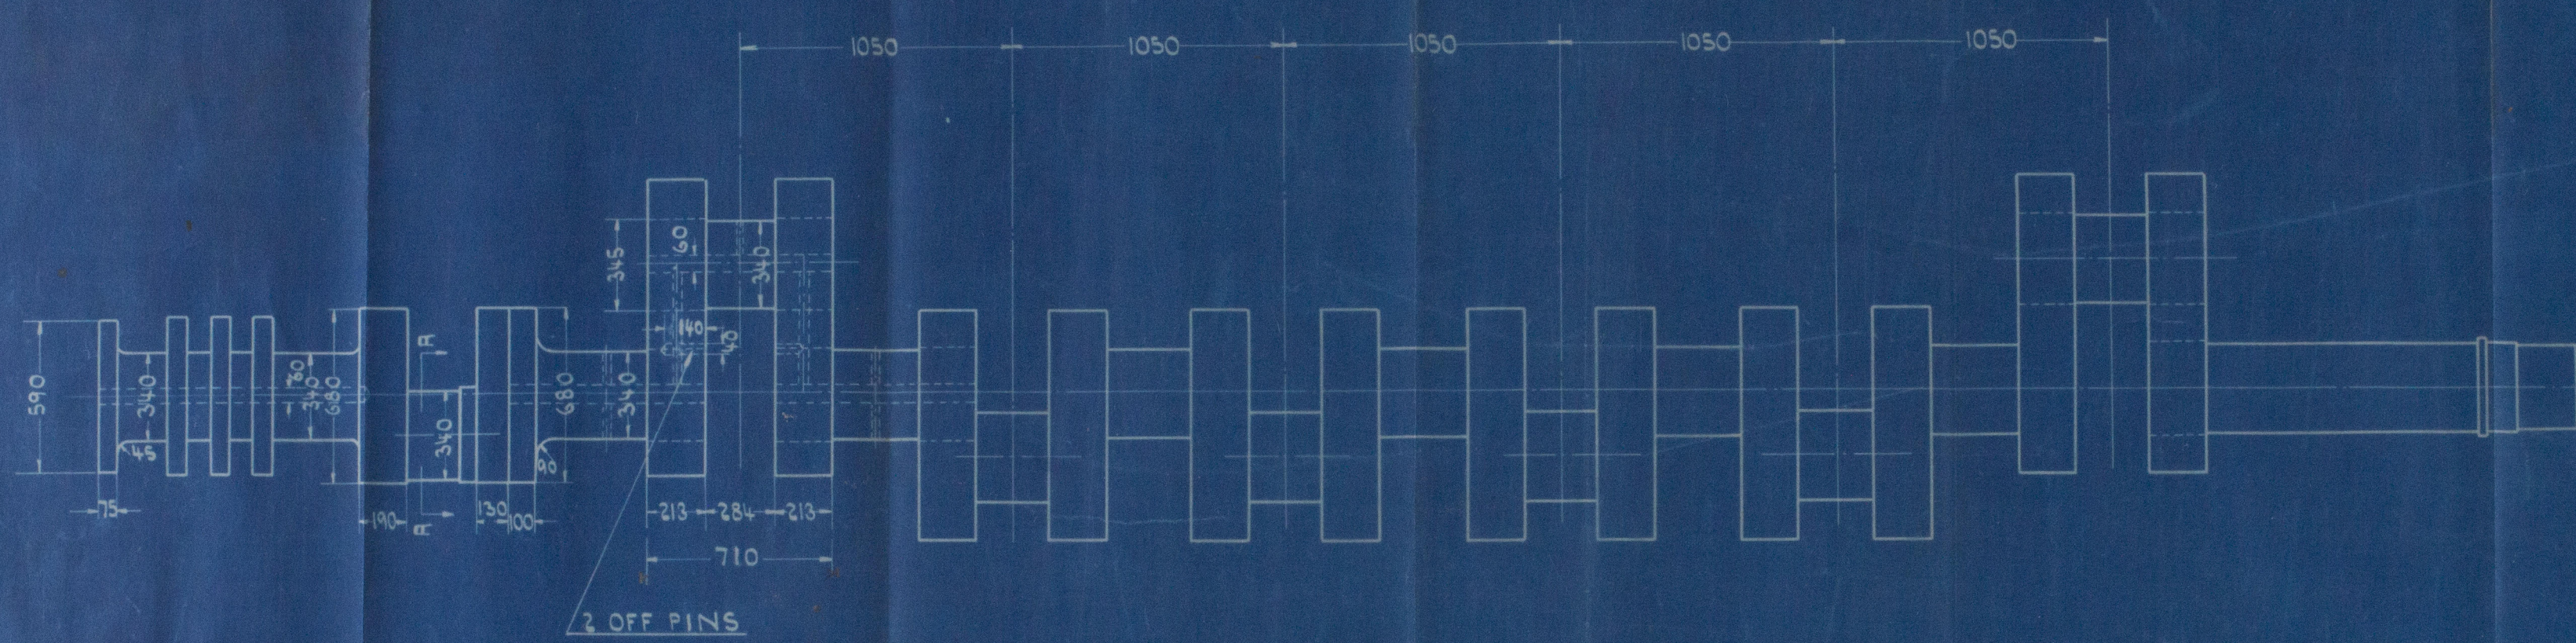


SNIT A-A

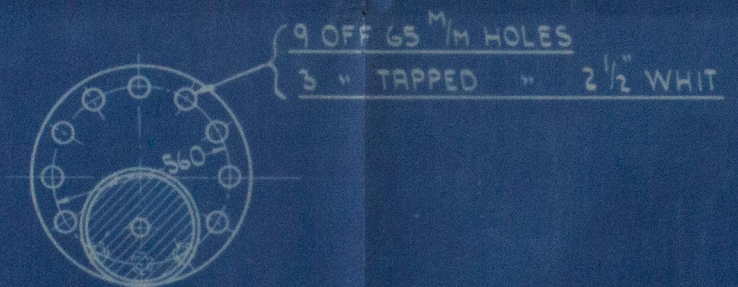

SHAFT FOR T. S. N° NAKSKOV YARD 28

6 CYLINDER FOUR CYCLE DIESEL ENGINE
CYL. DIAM. 550 M / M - STROKE 1000 M / M

21/8/25

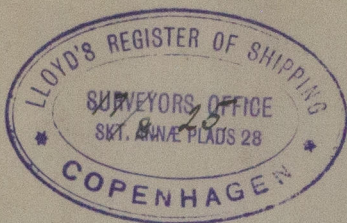

Plan of
CRANK AND THRUST SHAFTS FOR THE
MAIN DIESEL OIL ENGINES
to be constructed by

AKTIESELSKABET
FURMEISTER & WAINES MASKIN- OG SKIBSBYGERI
Copenhagen

for the Twin Screw Motor Vessel

Yard N^o 28

being built by
akts Næskov Skibsværft.
Næskov.

M^y "TALOMA" OF COPENHAGEN
RPT. N^o 0353



Lloyd's Register
Foundation

W1142-0096