


PROFILE & DECK PLAN.

STEEL SCREW TRAWLER

Nº 1146

SCALE 1/4 IN. = 1 FT.

151'-8" B.P. x 25'-6" MLD. x 14'-6" MLD.
TO CLASS X 100.A.I. - STEAM TRAWLER.

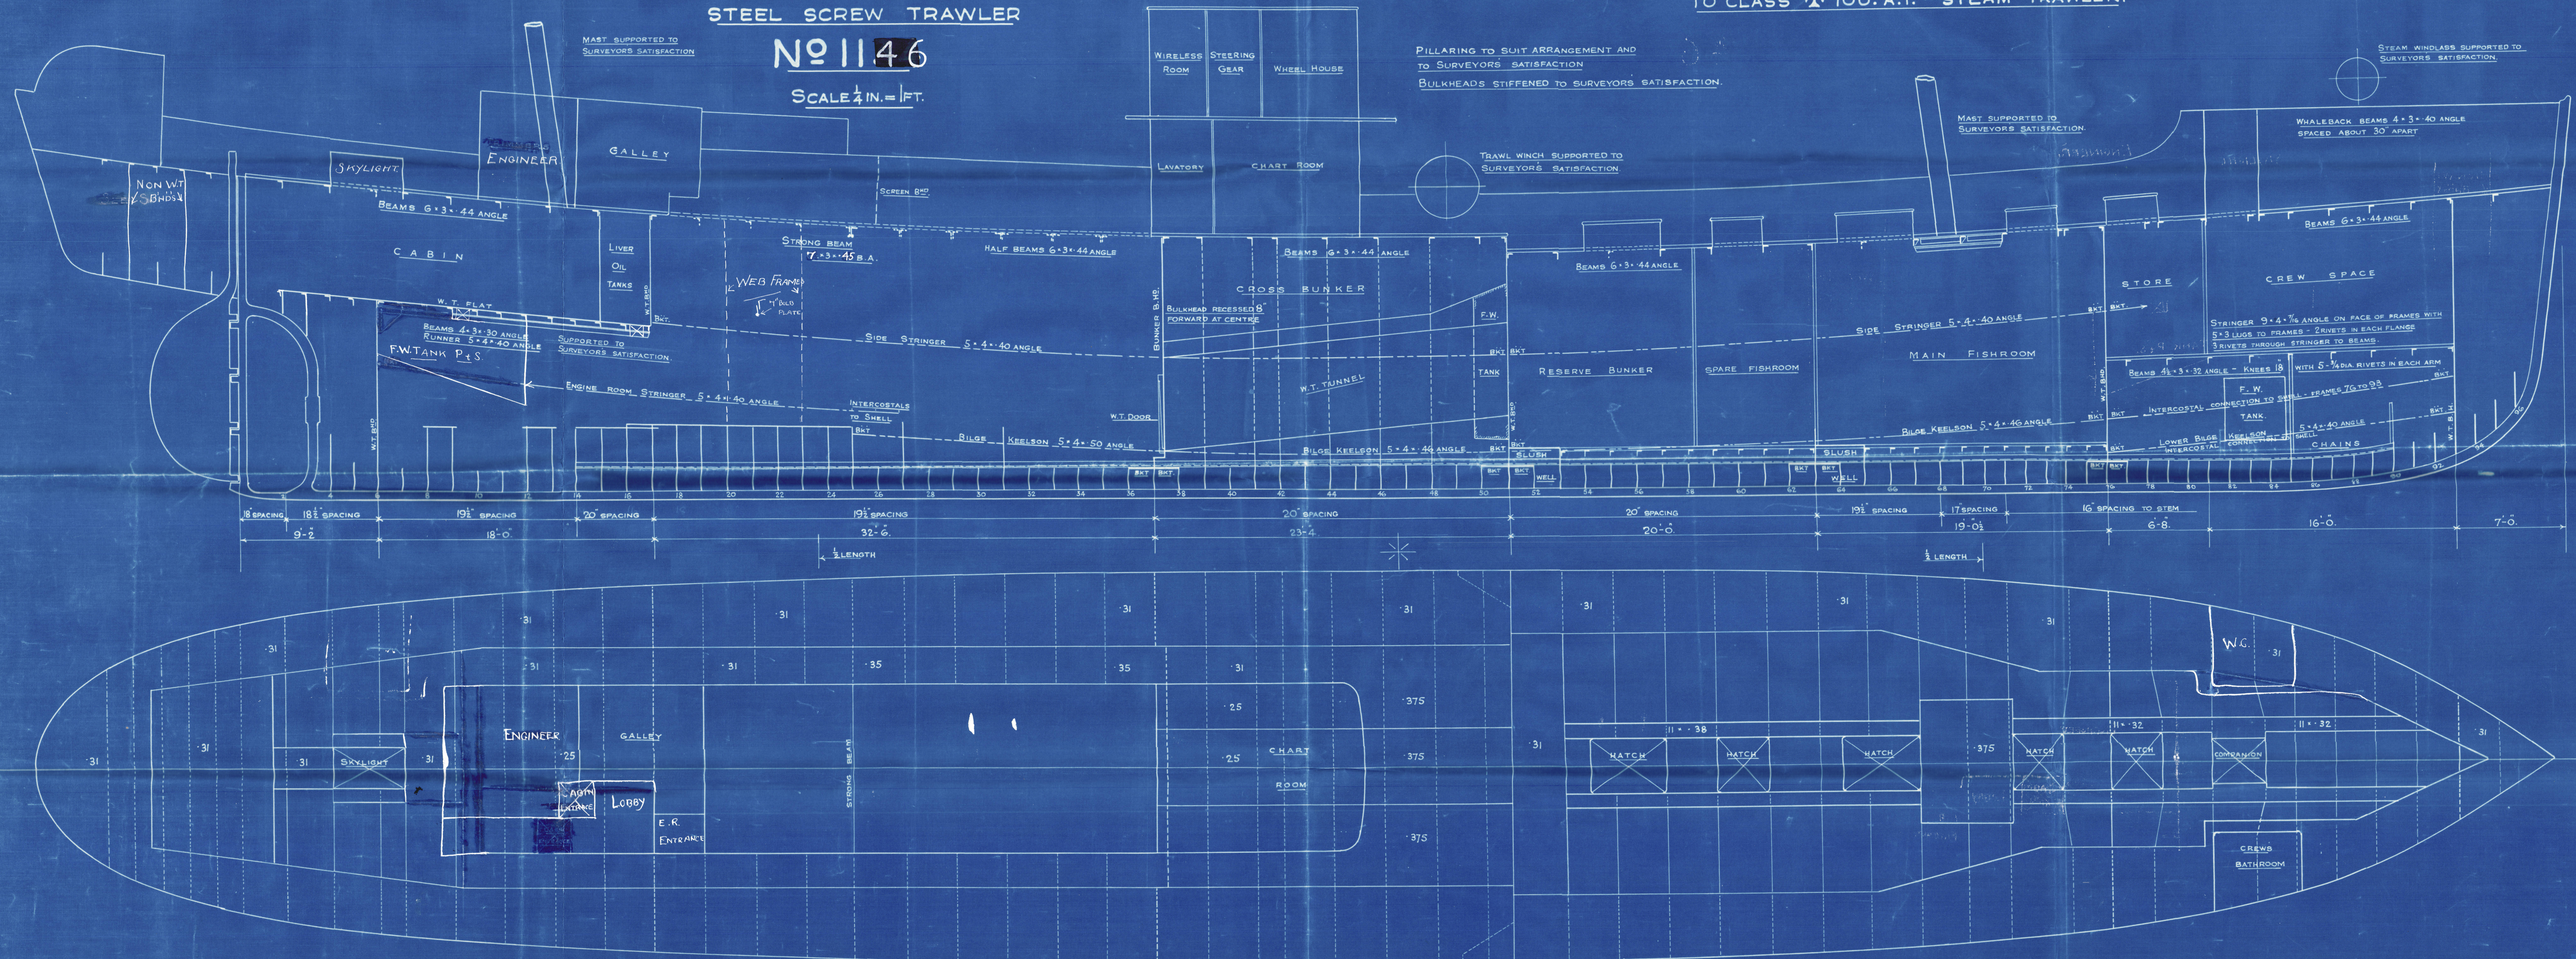

No 71146
Profile + Deck (as built)
Cochrane & Sons Ltd

S.S.R. "Cape Corrientes."
HULL REPORT NO. 46366.

PLAN NO 3400
FOR ENCLOSURE TO
Messrs Lloyd's
Register of Shipping
COCHRANE & SONS, LTD.
SHIPBUILDERS, SELBY.
DATE 13/11/35