


STEEL SINGLE SCREW STEAMERS N^{os} 385-8.

LONGITUDINAL SECTION & DECK PLANS.



250' O.B.P. x 37' 0" BTH M^{LD} x 16' 6" M^{LD} TO U.D. - 25' 0" TO SHTH D^K.

24.5.19

SCALE 1/8" = 1 FOOT

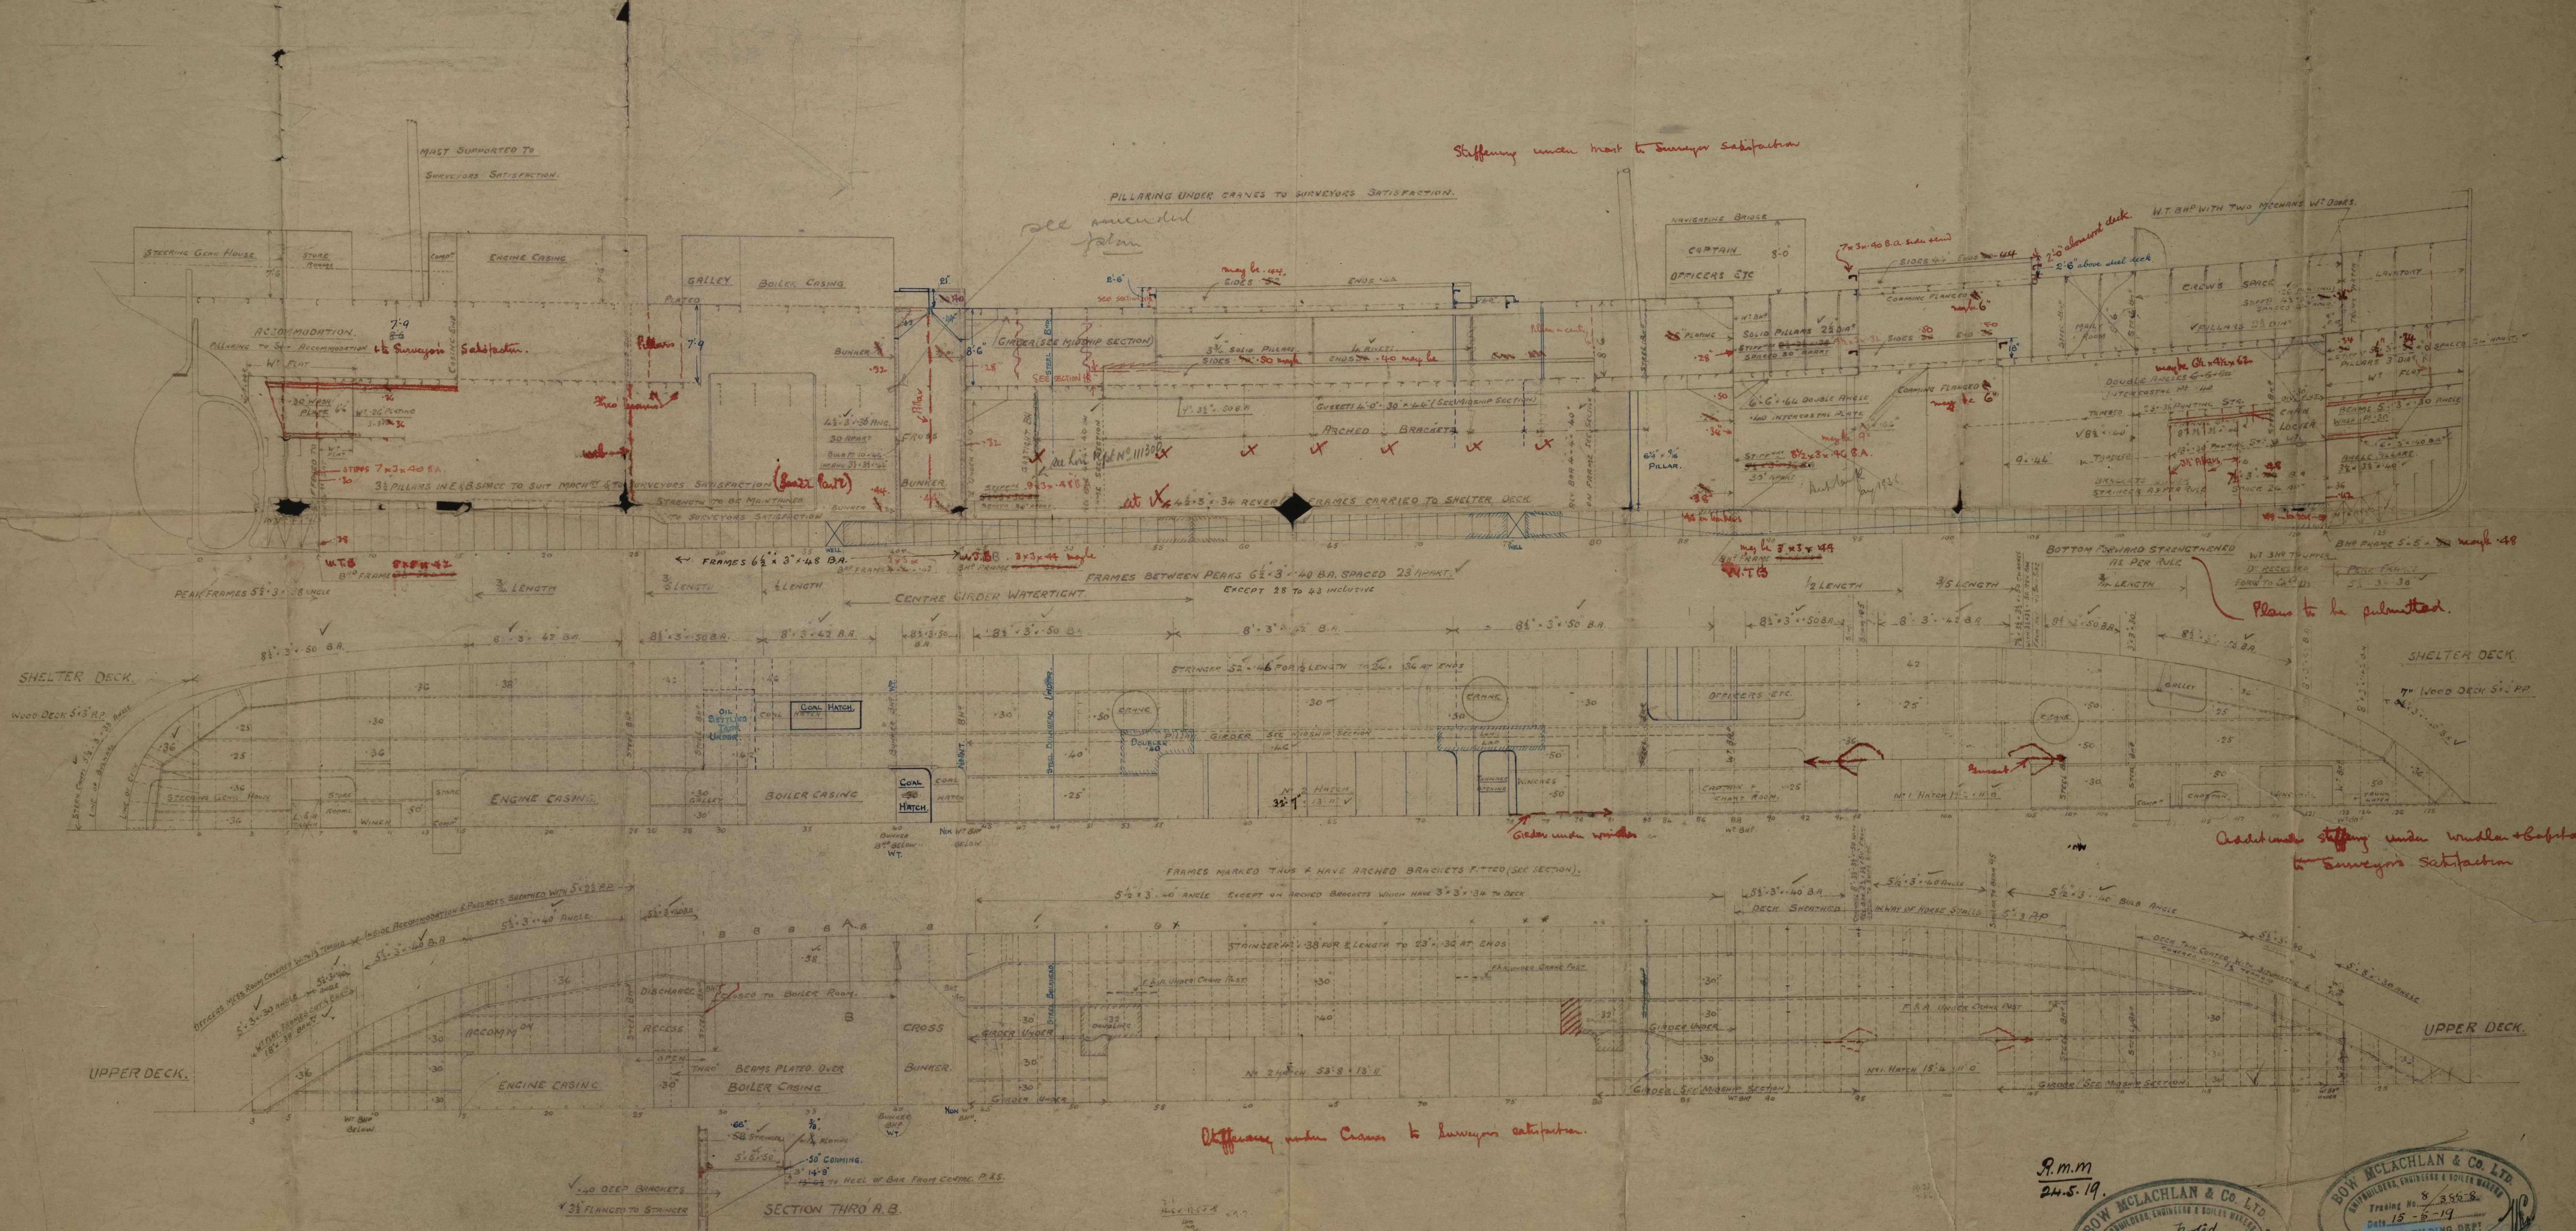

R.M.M.
24.5.19.

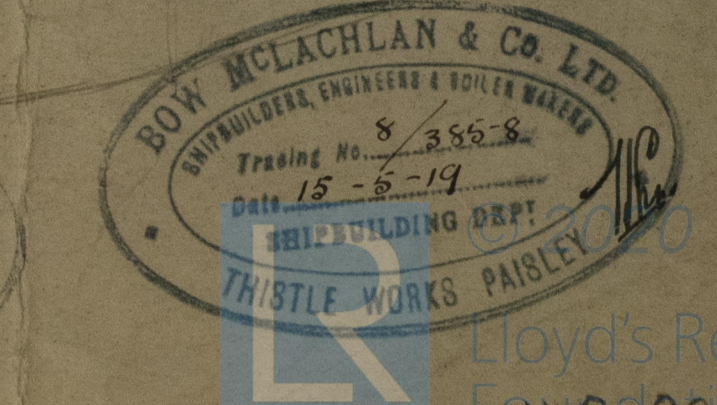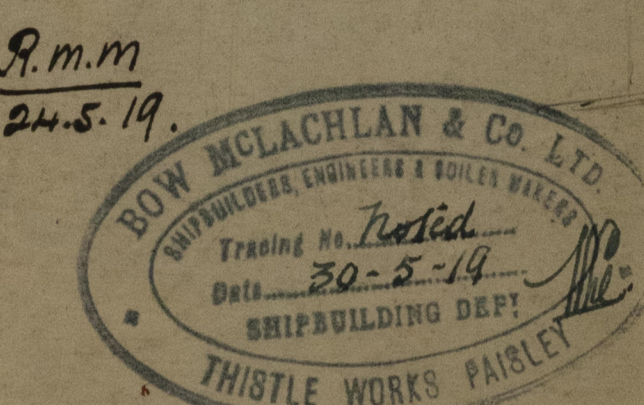

Lloyd's Register
W14450033

W1145-0033

BUILDERS.

Bow & MacLachlan,

Paisley.

YARD No.

385 - 8.


PLAN.

Longitudinal Section.

& Deck Plans.

SHIP'S NAME

"Lapwing"

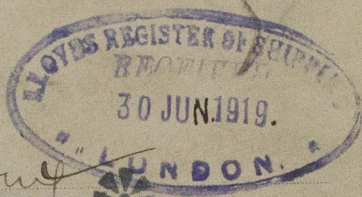

GLASGOW REPORT No

40371

No 386 - 5/8 "Auk"

GLASGOW REPORT No.

40763

No 387 - 5/8 "TEAL"

GLASGOW REPORT No.

41469

No. 388.

5/8 "Gannet"

Geo 41598.

