


## PROFILE & DECK PLANS, S.S.25!

LENGTH B.P. 331'-0". BREADTH MLD 46'-6". DEPTH MLD. 25'-6"

SCALE  $\frac{1}{8} = 1$  FOOT.

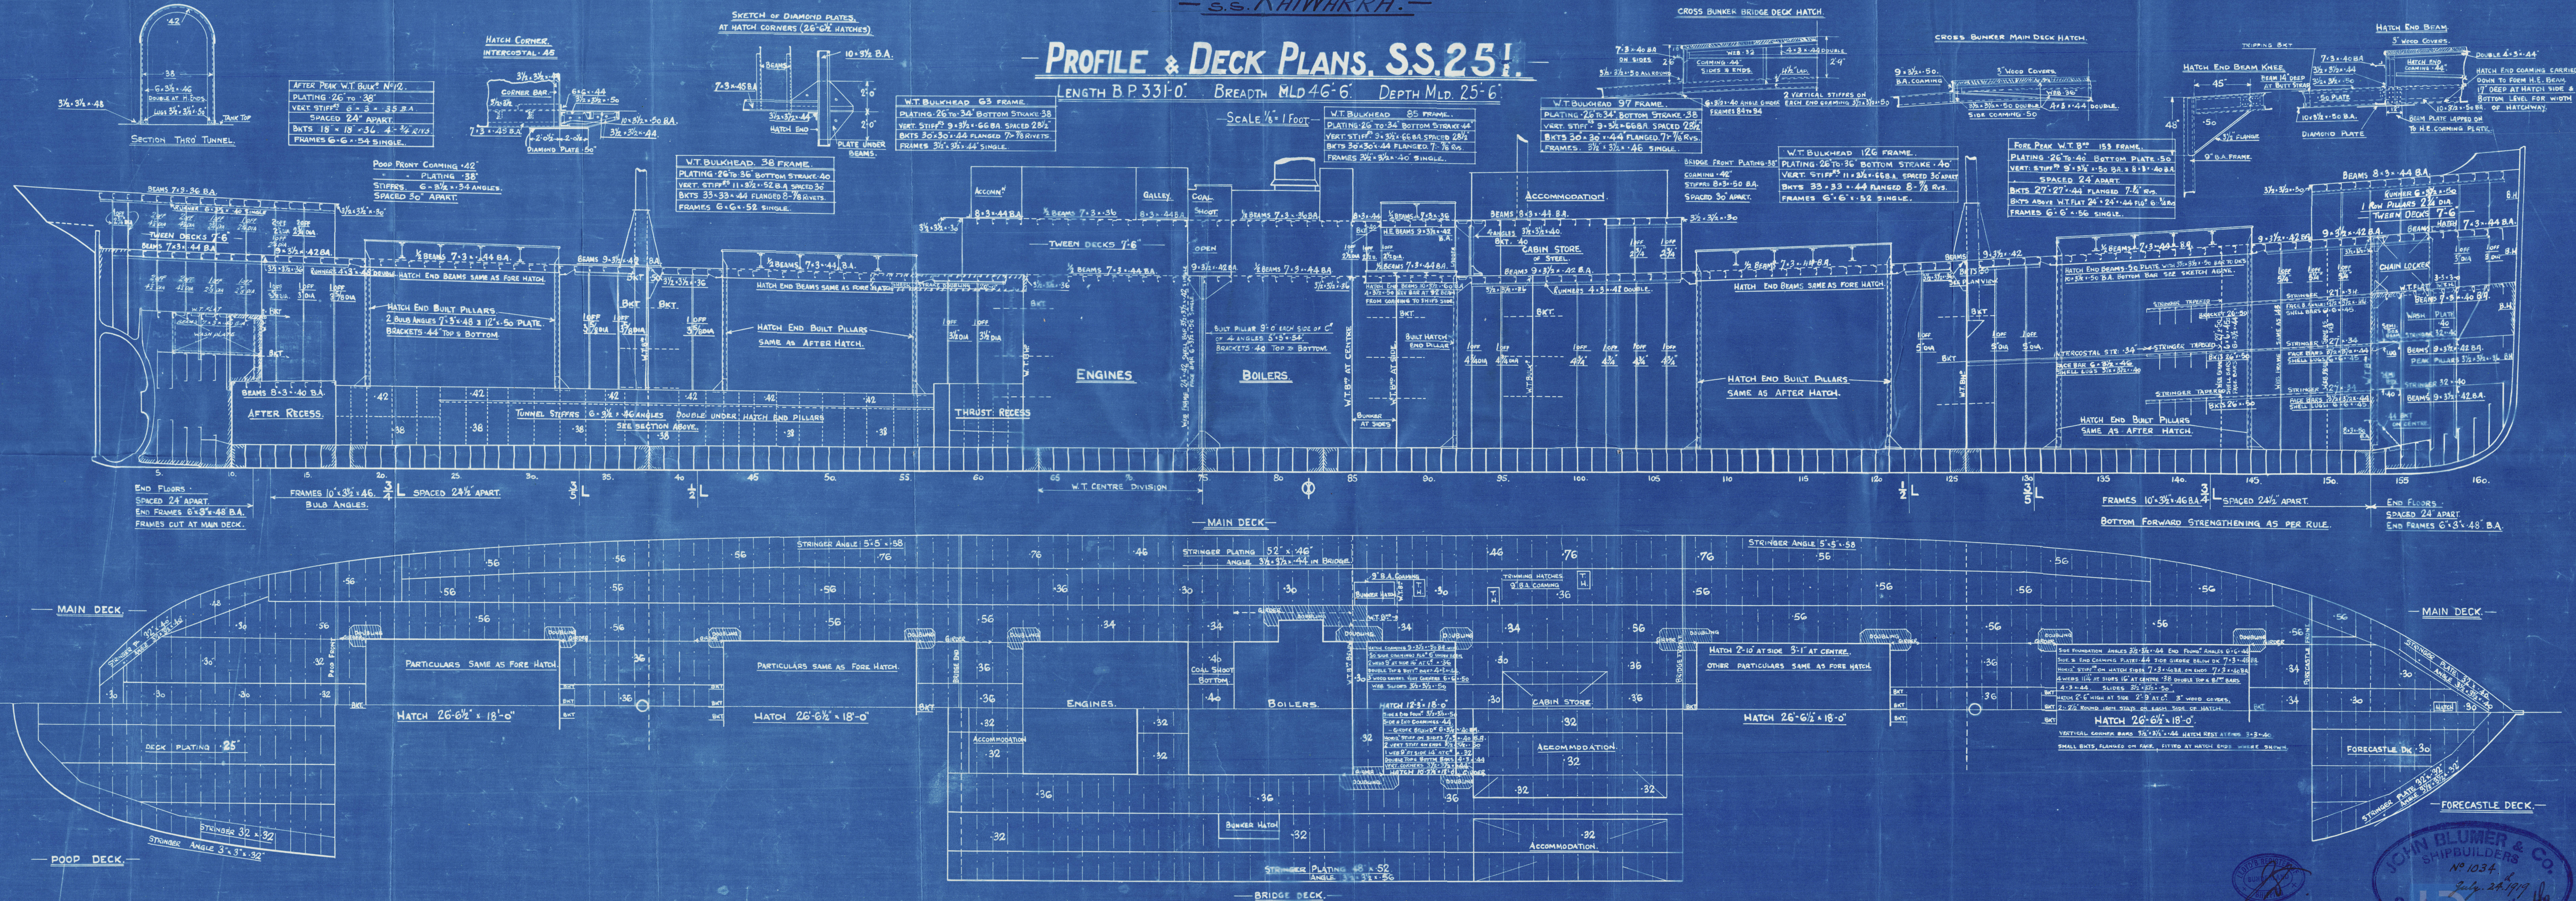

JOHN BLUMER & Co.  
SHIPBUILDERS  
No. 1034.  
July 27. 1919  
NORTH DOCK  
SUNDERLAND



John Blumer & Co.

Nº 251

Profile & Deck Plans.

(as built).

S.S. "KAIWARRA."

W1145-0190

SLD RPT Nº 27577

RETAIN



© 2020

Lloyd's Register  
Foundation