










S.S. NEWBURY.
PROFILE AND DECK PLAN.

S.S. No 369.

Scale 1/8" = 1 foot.

To CLASS 100 A1 AT LLOYDS.

RULE DIMS. Act. 34' SUMMER L.W.L. X 32.75' MLD. X 30'-0" MLD. TO UPPER DE.

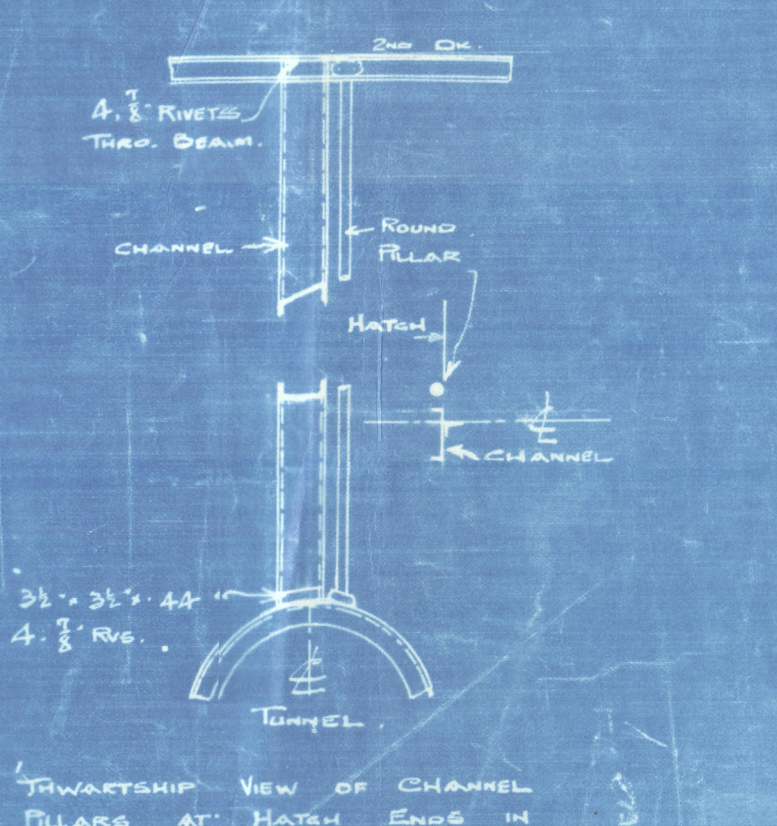 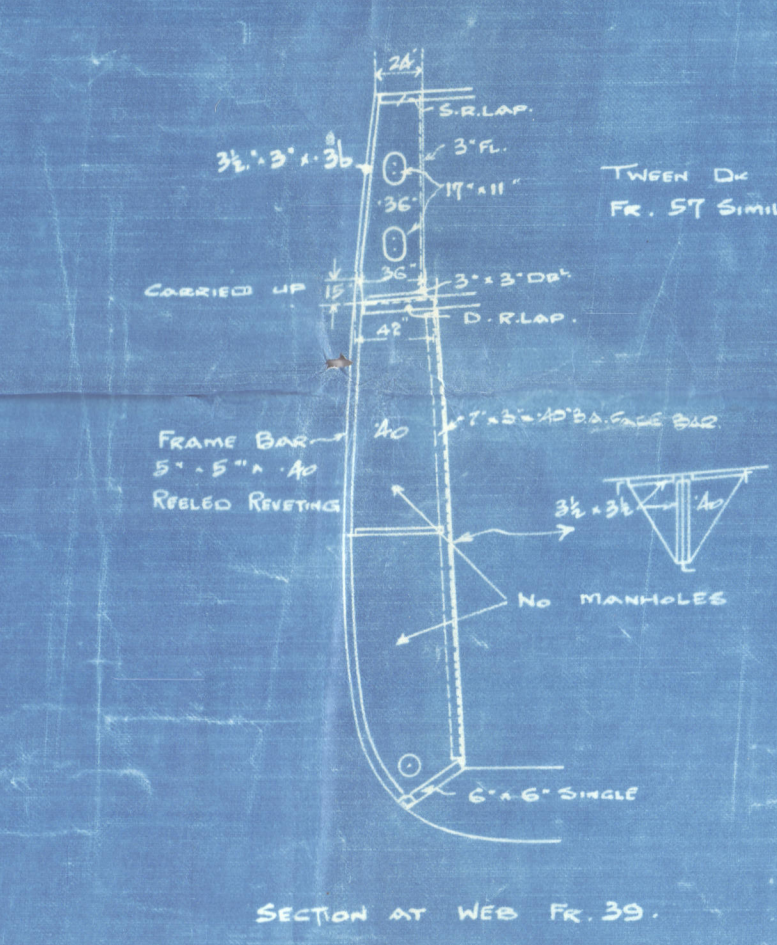 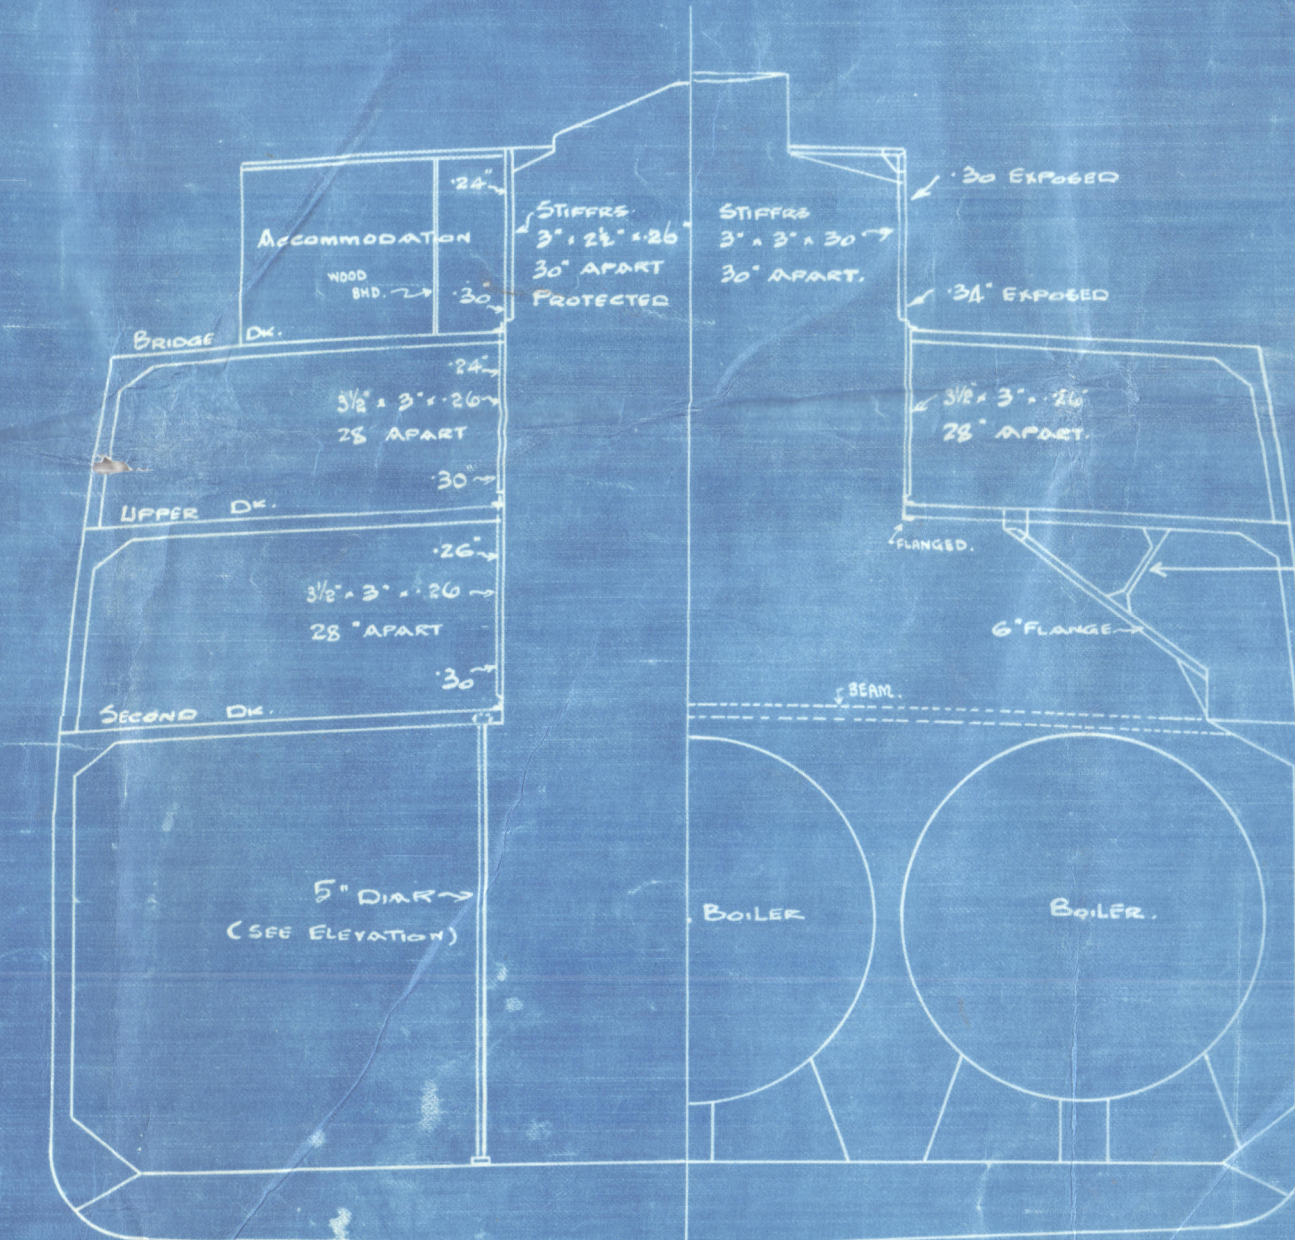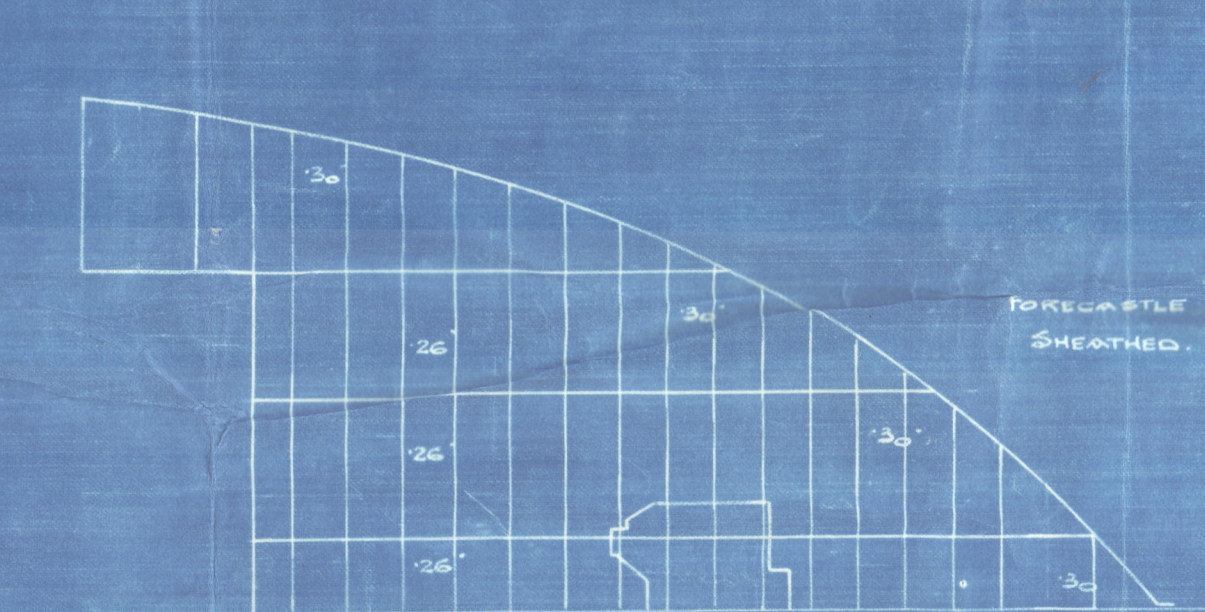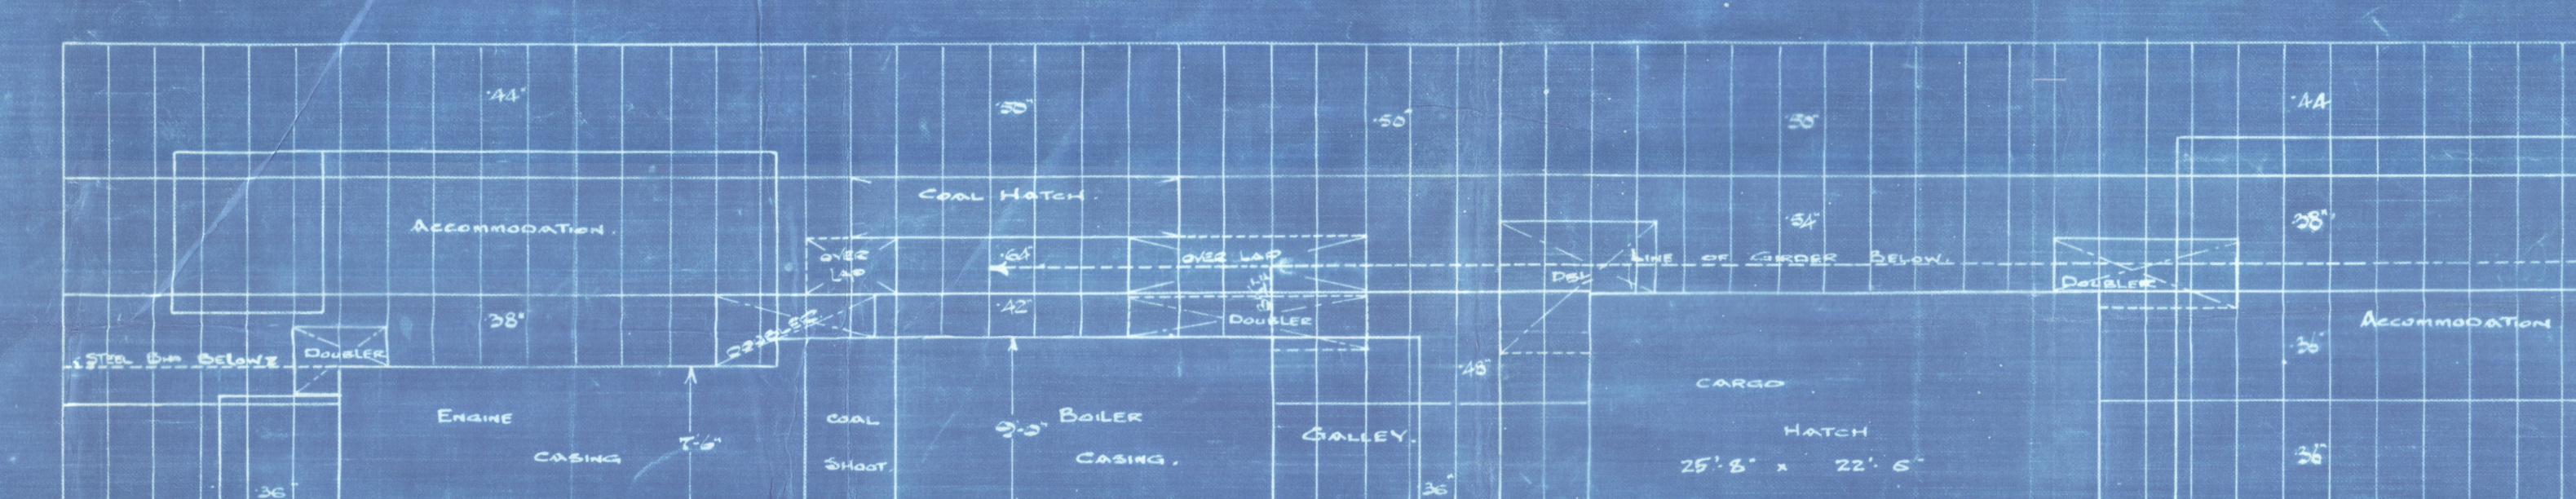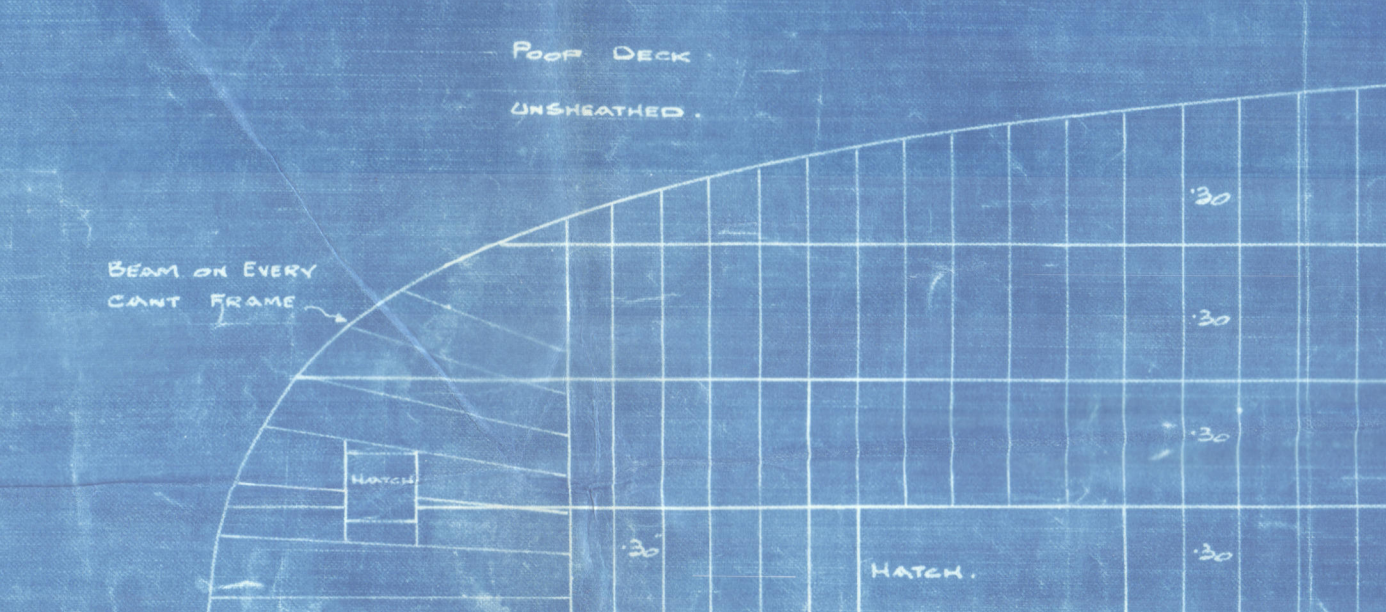 

Robert Duncan & Co's


N^o 369.

S. S. "NEWBURY"

Greenock Report N^o 18650.

PROFILE & DECKS (AS BUILT).

RETAIN

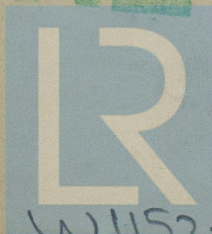

© 2020

Lloyd's Register
Foundation

W1152-0030