
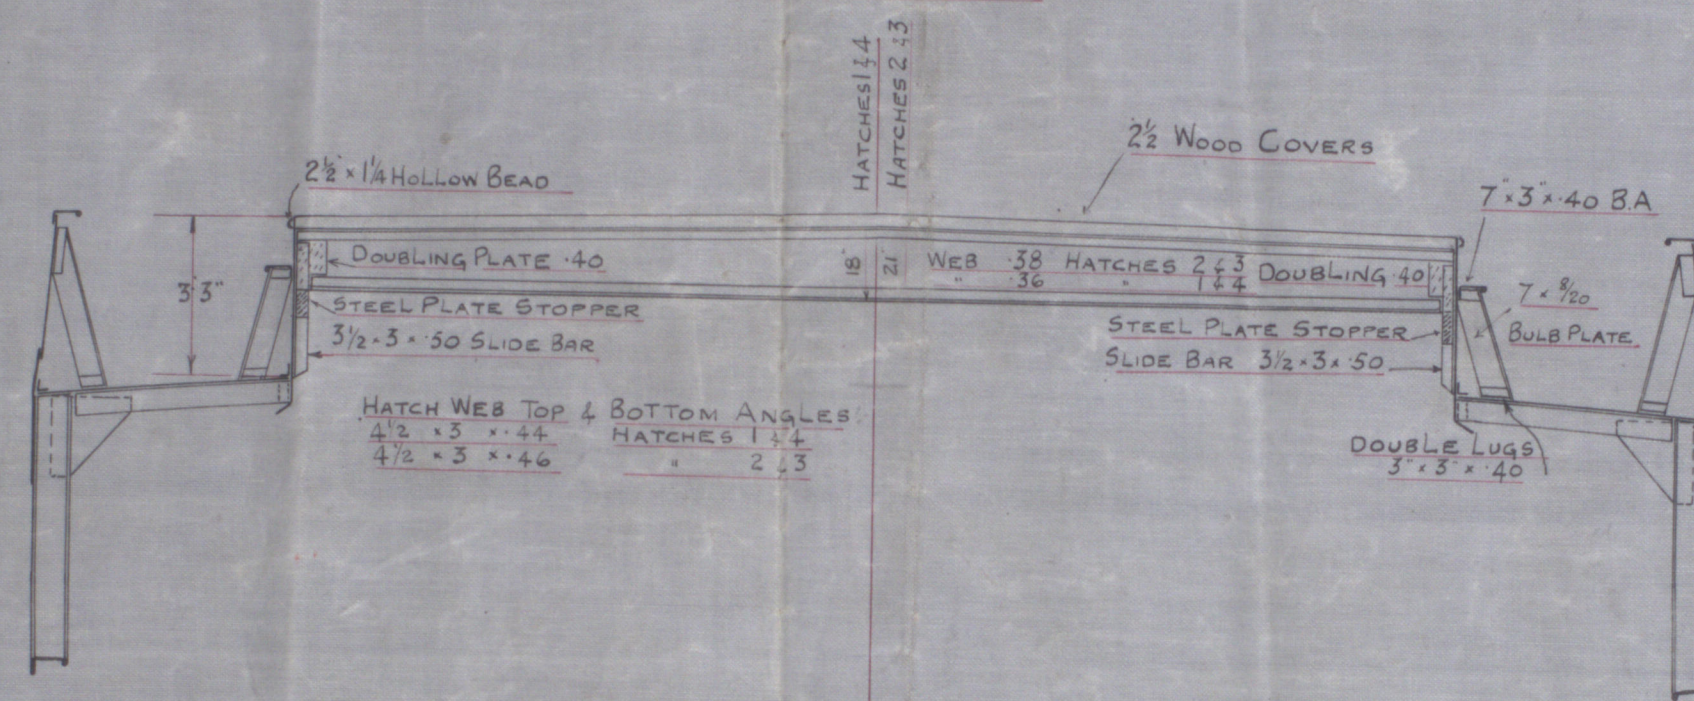
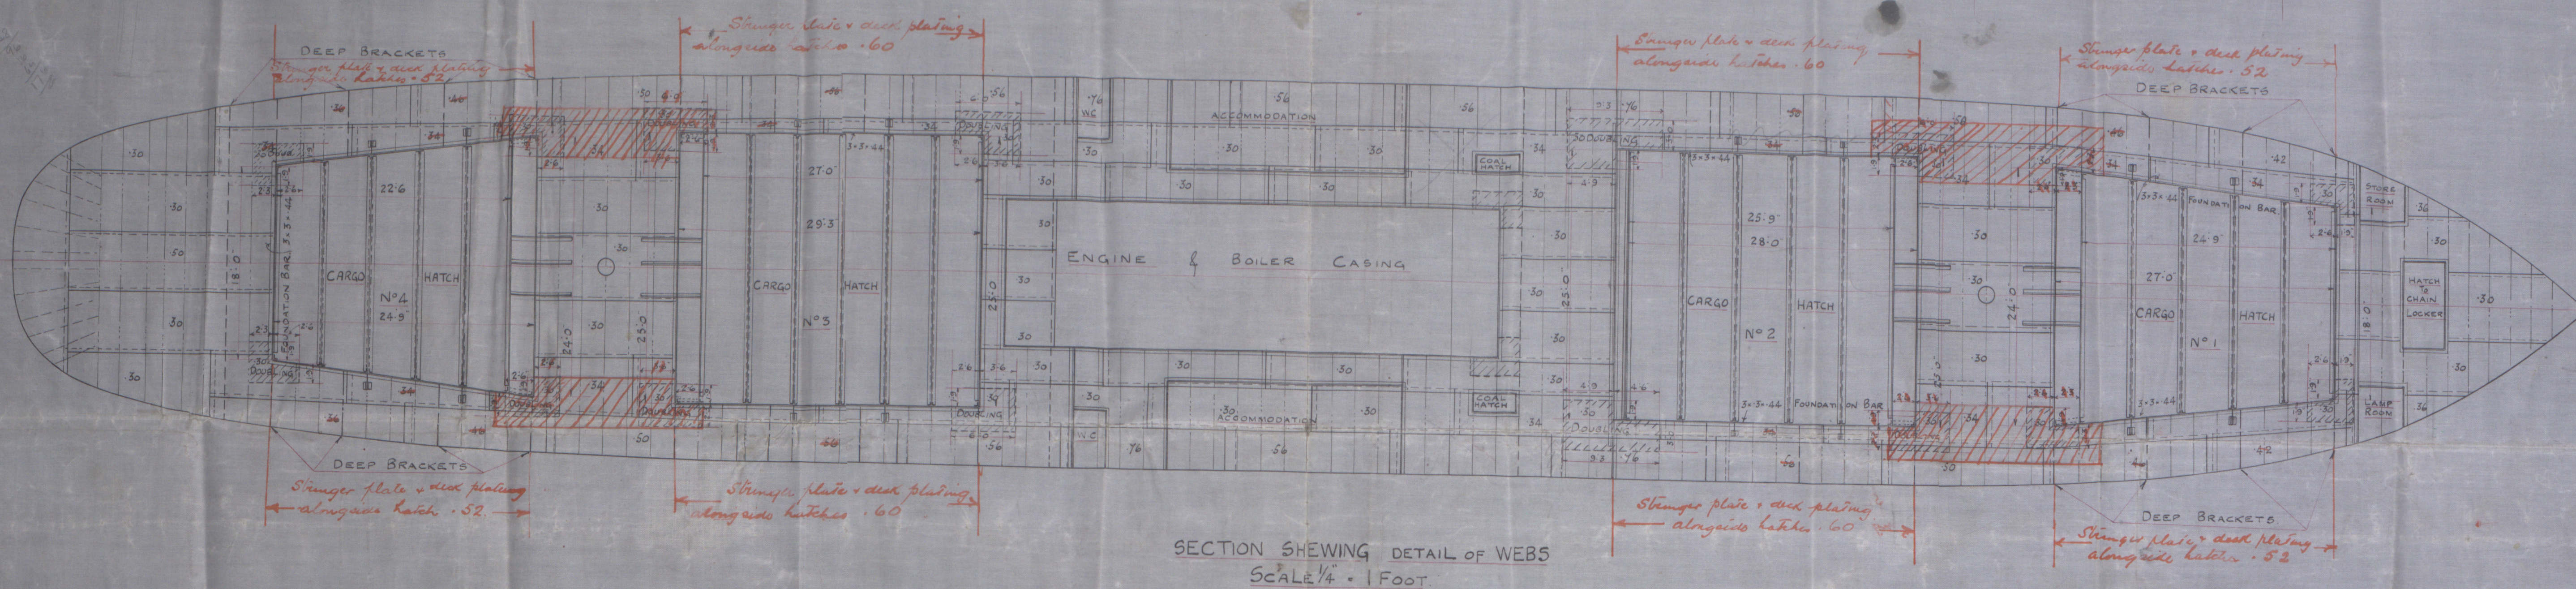


27.5.19

N^o 57 & 59
~~N^o 58~~ 57 & 59
PROFILE & DECK PLAN
SHEWING ARRANGEMENT OF SELF
TRIMMING HATCHES
DIM^{NS} 240'0" x 36'0" MLD x 21'3" MLD
SCALE 1/8" = 1 FOOT

HEIGHT OF HATCH COAMINGS 3'3" ABOVE DECK
SIDE 4'4"
WEBB 3'6"
HATCHES 2'13"

HEIGHT OF COAMINGS 3'3" ABOVE DECK
SIDE 4'4"
WEBB 3'6"
HATCHES 2'13"

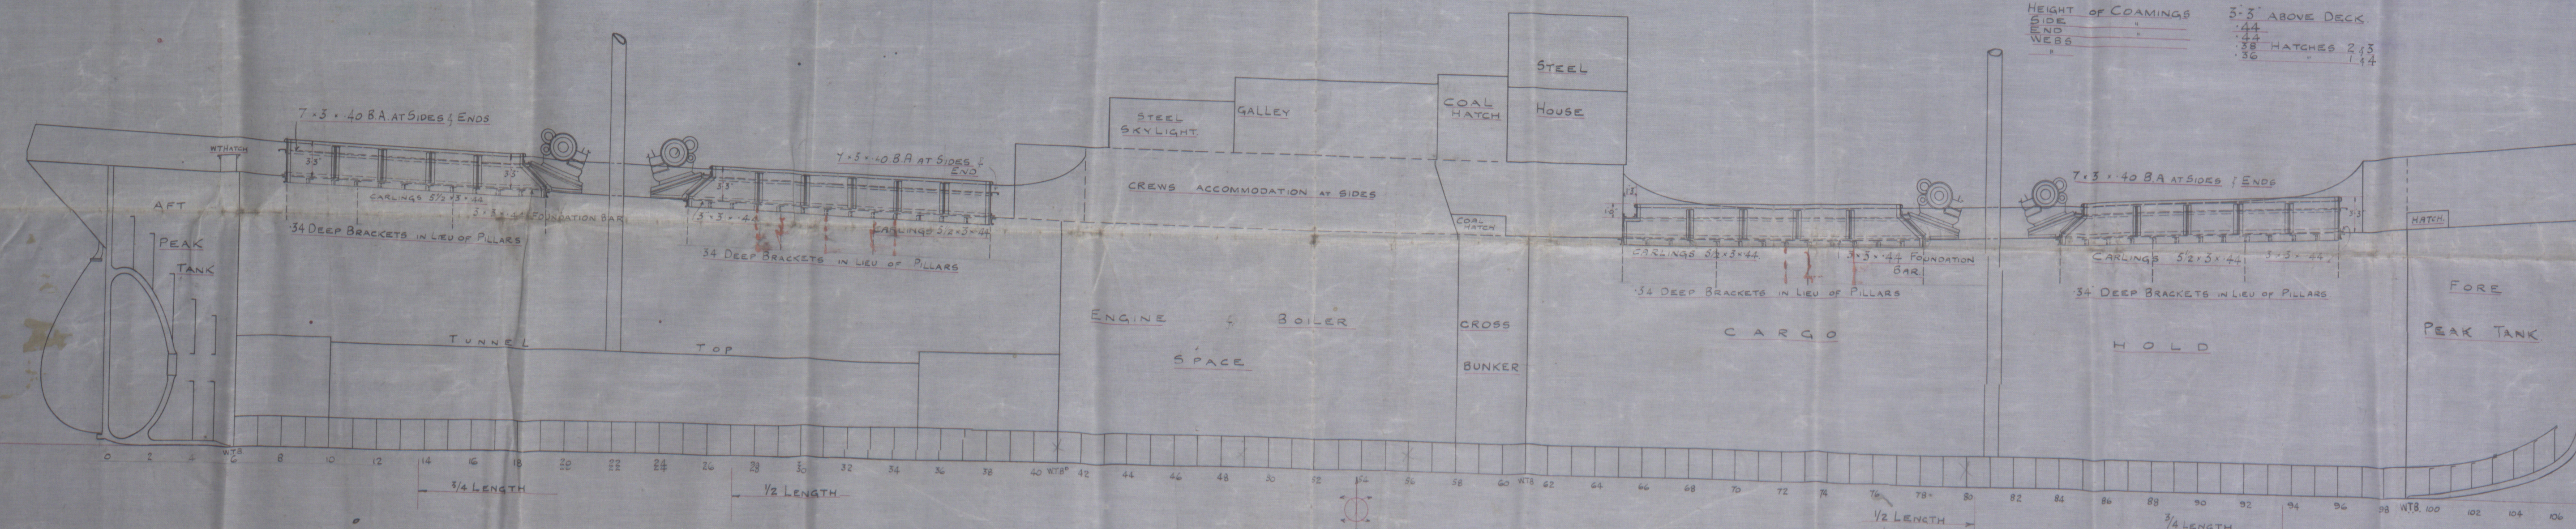

THE OUSE SHIPBUILDING CO. LTD
HOOK
N^o GOOLE

C.T. 19
27.5.19

THE OUSE SHIPBUILDING CO. LTD	
HOOK	
N ^o GOOLE	
DRAWING No. 34.7	
MADE BY J.B.G.	CHECKED BY H.G.
DATE 17.5.19	

3/5 "Shearburn"
3rd report 81632

Hull Report to 30/21.

Profile & deck.

s/s Adderstone.

Hull Rph 32003 (Hav)
32056

River Tyne

Dungham

W1153-0133

0201 62 JUN 20 1920



© 2020

Lloyd's Register
Foundation