

N^{os} A 222-3-4.

2 STEEL BOILERS

FOR EACH SHIP

© 2020
Lloyd's Register
Foundation

W1153-0134

Amended plan
6 Steel Boilers

No 222, 223, & 224

Charles C. & L.

for Standard Roaster Co.

No 52, 58 & 59 Bldg by Chase & B. Co.

180 lbs


21
26/4/18

S. S. Sherburn

Hull Rpt No. 31421

✻ "Plaworth"

Hull 31976.

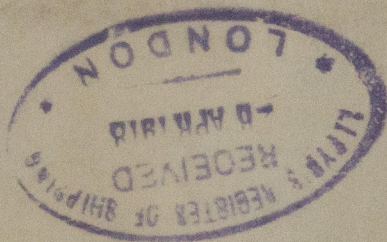

© 2020

Lloyd's Register
Foundation