

YARD N° 1214
M^s „OLIVIA“

PROFILE PLAN




SCALE 1/8" = 1 FOOT
PRINCIPAL DIMENSIONS

LENGTH BETWEEN P.P. 425' 0"
BREADTH MOULDED 54' 3"
DEPTH MOULDED TO UPPERDECK 31' 0"

LLOYDS NUMBERS

D = 31
L x D = 13175
L [B + D] = 36231
L/D = 137

as built
M^s „Olivia“
Cantieri Monfalcone
del. Adriano N. 1214
Tras. Rpt. 12614

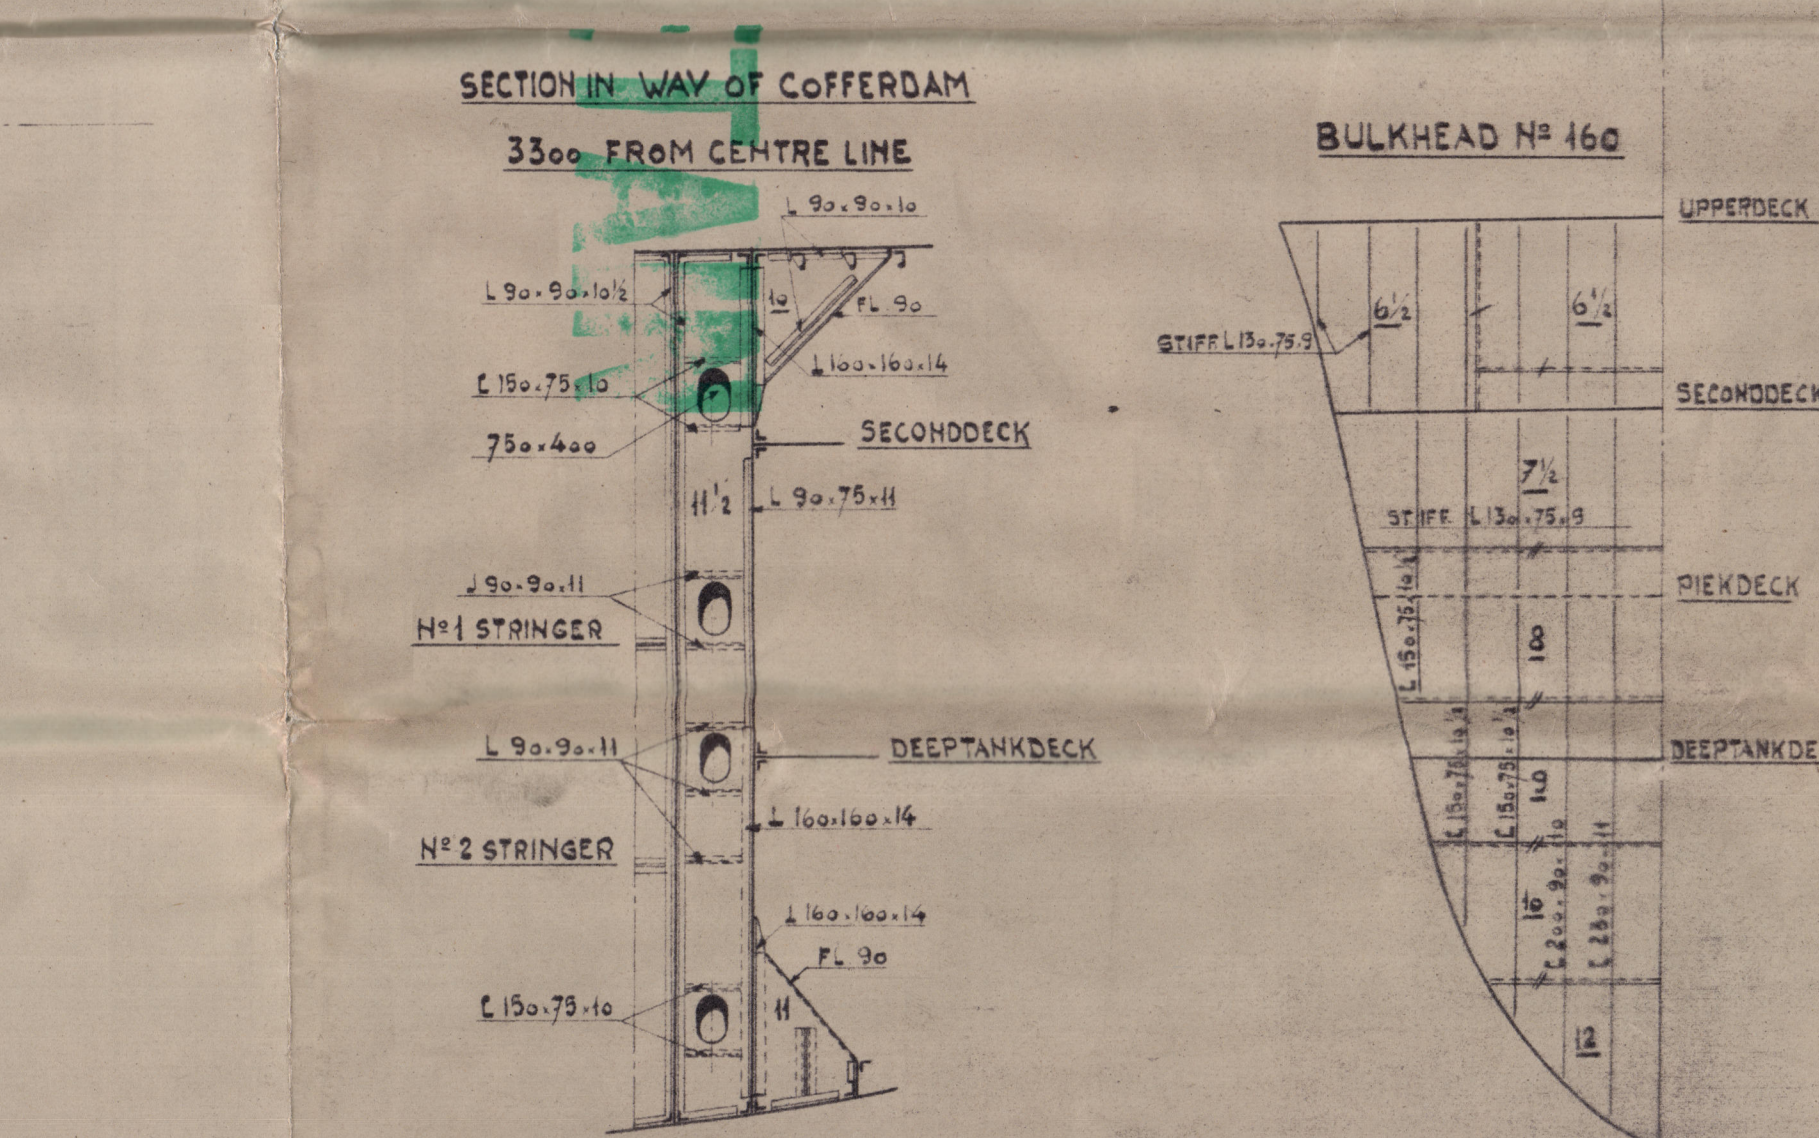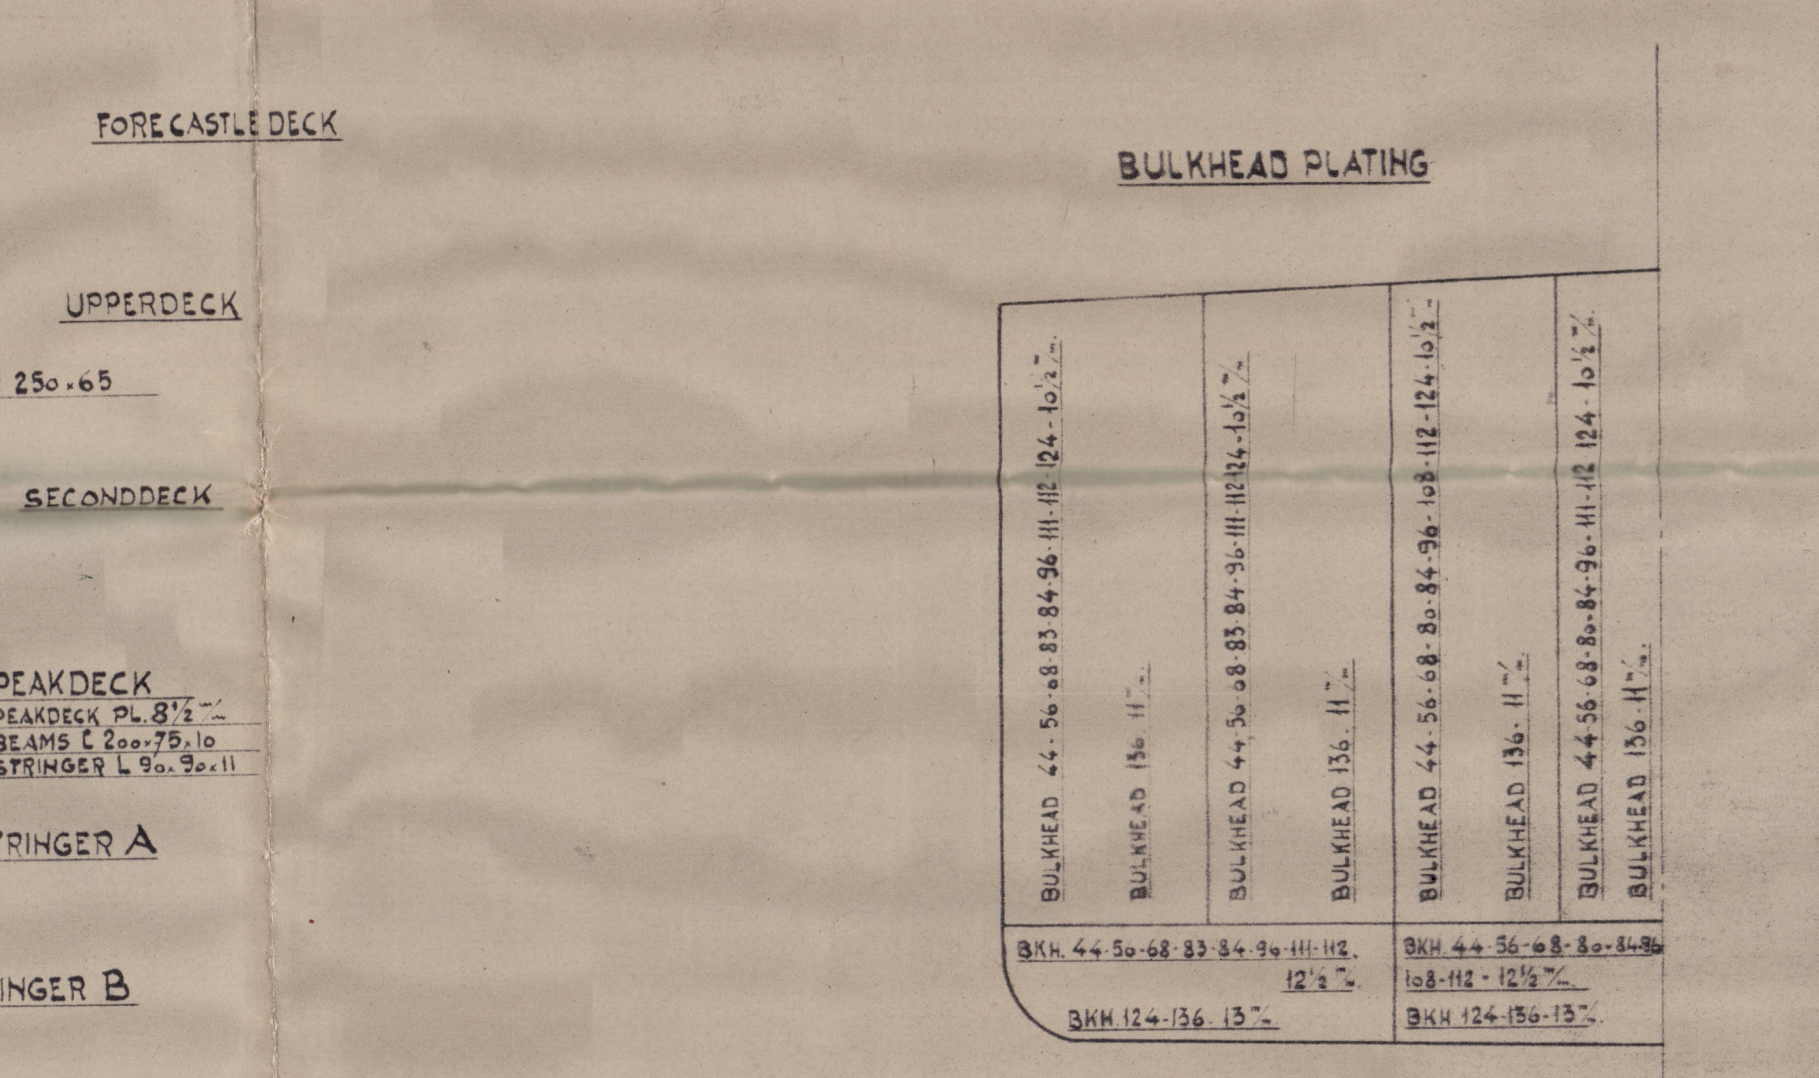 

CANTIERI MONFALCONE	
Societa' Anonima	
Viale Tezze - Gruppo Navale	
Reporto:	
COSTR. N° 1214	
PROFILE PLAN	