

S. S. N° 30.95 104

PROFILE AND DECK PLAN.




SCALE: 1/8" INCH = 1 FOOT.

PARTICULARS FOR FREEBOARD.

REGISTERED DIMENSIONS 200'-0" x 30'-5" x 12'-6"
 UNDER DECK TONNAGE 600 TONS APPROX.
 SHEER AT STEM 6'-0" AT 1/8 LENGTH FROM STEM 3'-2"
 STERN 3'-0" STERN 1'-0"
 RY Q5 D5 FRONT CLOSED.

FORECASTLE OPEN 5 CREWS ACCOMMODATION.

DIMENSIONS—
 BREADTH MOULDED 200'-0"
 DEPTH MOULDED TO UPPER DECK 14'-9"

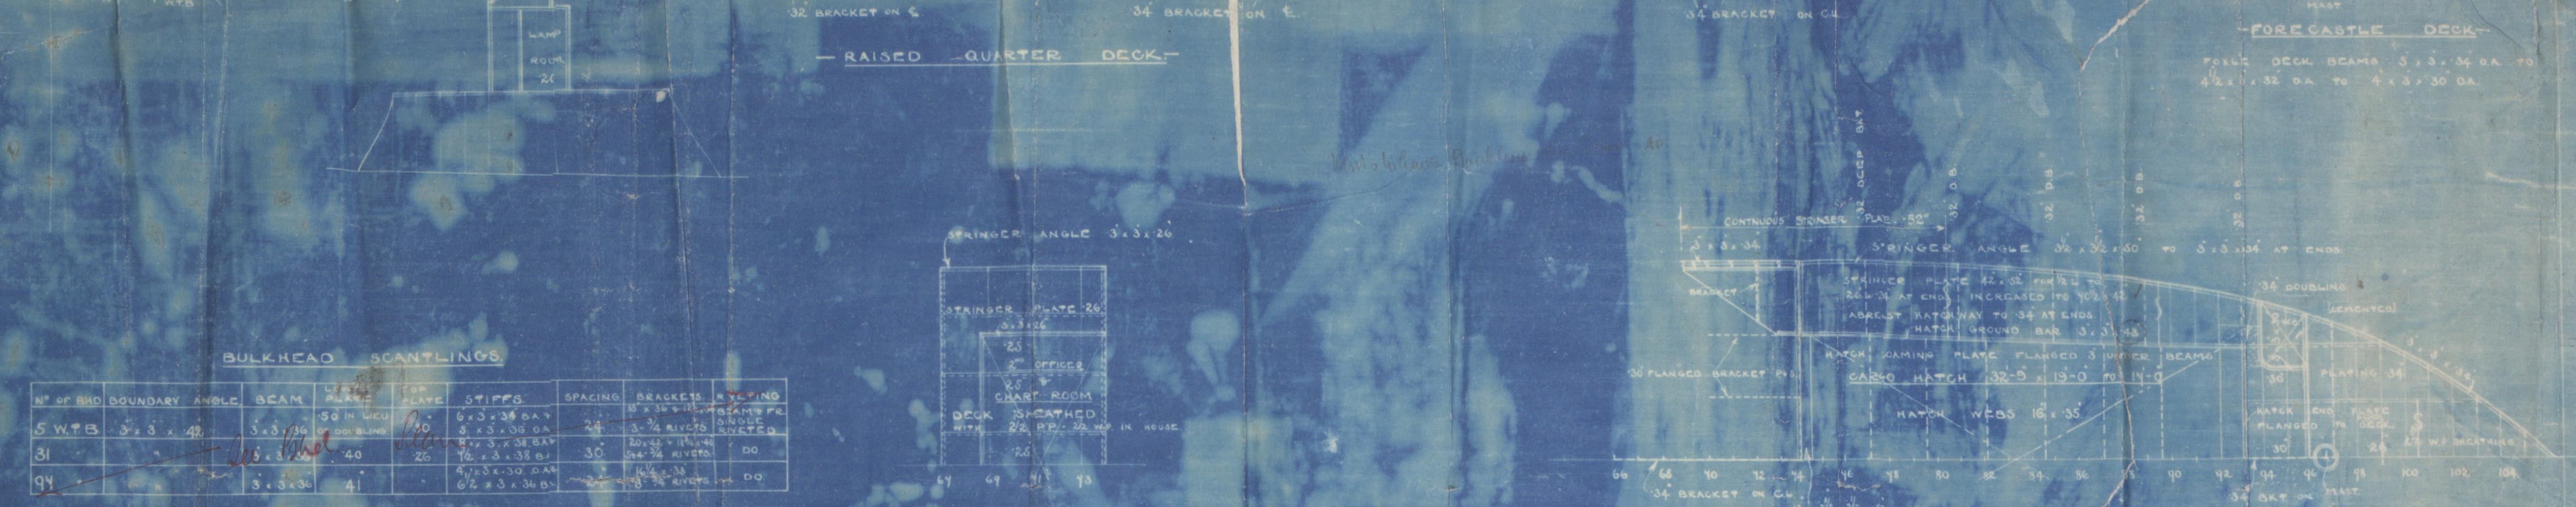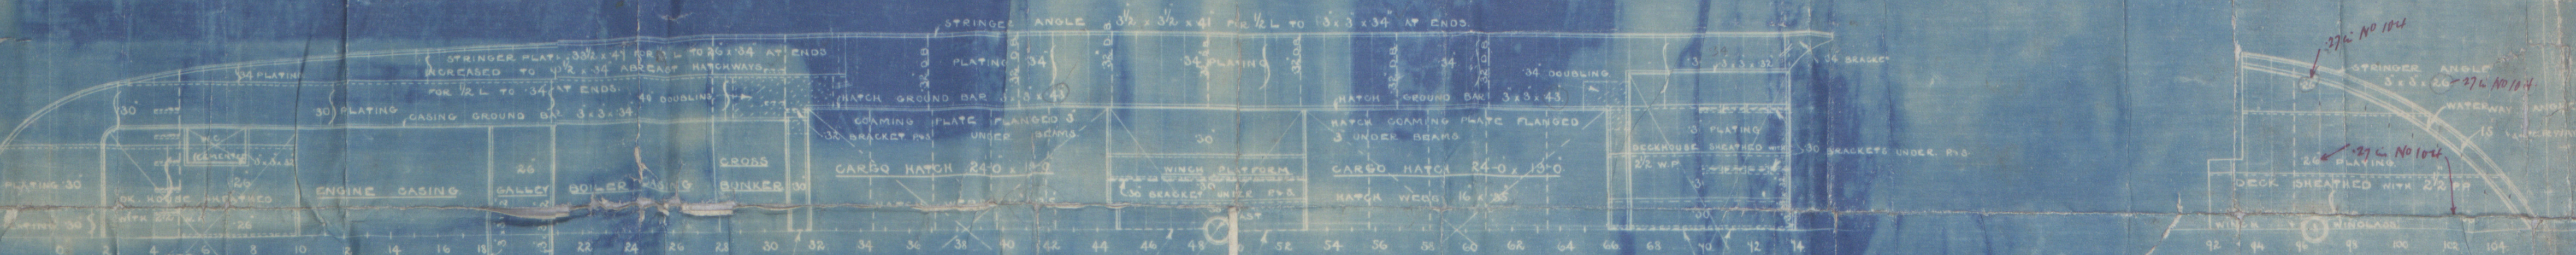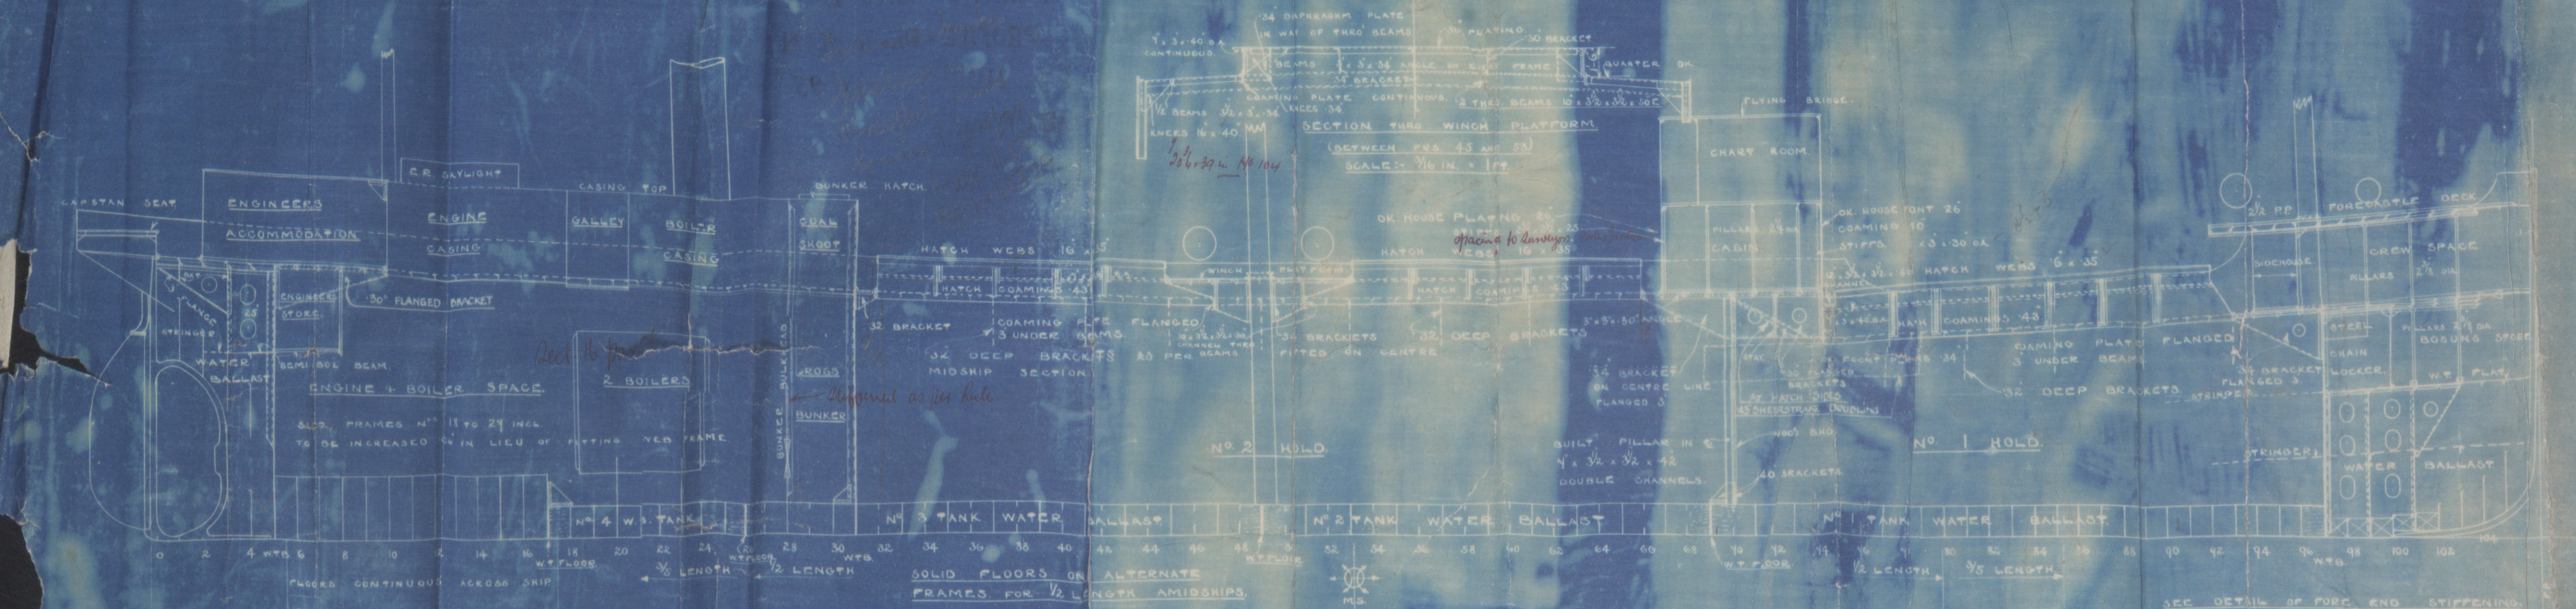

BULKHEAD SCANTLING

N° OF BMD	BOUNDARY	ANGLE	BEAM	PLATE	STIFFS	SPACING	BRACKETS	BY-ENDING
5 WTB	3 x 8 x 4	30 IN LIEU	30 IN LIEU	6 x 3 x 38 BA	24	3 1/2 RIVETS	DO	DO
31	3 x 8 x 4	30 IN LIEU	30 IN LIEU	6 x 3 x 38 BA	24	3 1/2 RIVETS	DO	DO
94	3 x 8 x 4	30 IN LIEU	30 IN LIEU	6 x 3 x 38 BA	24	3 1/2 RIVETS	DO	DO

BRIDGE DECK BEAMS 3/4 x 3 x 34 BA
 ON ALT. FRAMES.

Approved for 12/1/24

LOUIS REGISTER OF SHIPPING
 22.5.23

LOYD'S REGISTER
 15.5.23

JOHN LEWIS & SONS
 15 MAY 1923
 6251
 ABERDEEN

17 July 1924
 Lloyd's Register
 1153-0176

W1153-0176

N^o 95 + ~~105~~ 104.

J. LEWIS + SONS LD

PROFILE + DECK PLAN.

S.S. "HORLEY" N^o 95

ABN. REPORT. N^o 14251

S.S. "BURSTOW" N^o 104.

ABN. REPORT. 1A968.



n. n. Olive

Wreck Section 94

John Lewis & Sons, Ltd

No. 95.



© 2020

Lloyd's Register
Foundation